



SOLAR DECATHLON 2013

TEAM TEXAS



UNIVERSITY OF TEXAS AT EL PASO & THE COMMUNITY COLLEGE



SHEET INDEX

G-GENERAL

- G-001 TABLE OF CONTENTS
- G-101 EGRESS PLAN
- G-102 ADA TOUR ROUTE COMPLIANCE PLAN

C-CIVIL

- C-103 SITE UTILITY PLAN

L-LANDSCAPING

- L-101 LANDSCAPE AND PLANTING SITE PLAN
- L-102 LANDSCAPE IRRIGATION AND GRAY WATER PLAN
- L-103 LANDSCAPE IRRIGATION NOTES AND DETAILS

S-STRUCTURAL

- S-001 STRUCTURAL NOTES AND SYMBOLS
- S-101 FOUNDATION PLAN
- S-102 FIRST FLOOR FRAMING PLAN
- S-103 ROOF FRAMING PLAN
- S-301 FRAMING SECTIONS
- S-302 BUILDING SECTIONS
- S-601 PLAN DETAILS
- S-621 DECK DETAILS
- S-631 ROOF DETAILS

A-ARCHITECTURAL

- A-001 ARCHITECTURAL SYMBOLS AND NOTES
- A-101 ARCHITECTURAL SITE PLAN
- A-111 FIRST FLOOR PLAN
- A-112 ROOF PLAN
- A-211 ELEVATIONS
- A-212 ELEVATIONS
- A-213 INTERIOR ELEVATIONS
- A-301 BUILDING SECTIONS
- A-302 BUILDING SECTIONS
- A-311 WALL SECTIONS
- A-312 WALL SECTIONS
- A-531 WINDOW DETAILS
- A-532 DOOR DETAILS
- A-601 SCHEDULES

F-FIRE PROTECTION

- F-100 FIRE PROTECTION FLOOR PLAN, SCHEMATICS AND KEYED NOTES

P-PLUMBING

- P-001 SYMBOL LEGEND AND PLUMBING GENERAL NOTES
- P-100 PLUMBING SITE PLAN, KEYED NOTES
- P-200 PLUMBING WATER SEWER, DOMESTIC WATER FLOOR PLAN, ISOMETRIC
- P-300 PLUMBING SOLAR SYSTEM FLOOR PLAN, SOLAR RISER DIA, SOLAR SC.
- P-400 PLUMBING FIXTURE SCHEDULES AND SCHEMATICS

M-MECHANICAL

- M-001 SYMBOL, LEGEND, MECHANICAL GENERAL NOTES
- M-100 MECHANICAL RADIANT FLOOR PLAN, MECH. RADIANT CEILING PLAN AND NOTES
- M-200 ENLARGED MECHANICAL ROOM FLOOR PLAN, ELEVATION AND NOTES
- M-300 MECHANICAL SCHEMATICS

E-ELECTRICAL

- E-001 SYMBOL, LEGEND, ELECTRICAL GENERAL NOTES
- E-100 ELECTRICAL SITE PLAN AND ELECTRICAL POWER EQUIPMENT ELEVATION
- E-200 ELECTRICAL LIGHTING FLOOR PLAN AND ELECTRICAL LIGHTING SCHEDULE
- E-300 ELECTRICAL POWER FLOOR PLAN, APPLIANCE SCHEDULE, MODULAR WIRING
- E-400 ELECTRICAL PANEL SCHEDULE
- E-401 ELECTRICAL BATTERY LOCATION FLOOR PLAN
- E-501 ELECTRICAL THREE LINE DIAGRAM

O-OPERATIONAL

- O-001 EQUIPMENT SYMBOLS AND NOTES
- O-101 ARRIVAL SEQUENCE PLAN
- O-102 DEPARTURE SEQUENCE PLAN
- O-601 CONSTRUCTION EQUIPMENT SCHEDULE
- O-602 TRUCK LOADING DIAGRAM



TEAM NAME: TEAM TEXAS
 ADDRESS: ORANGE COUNTY GREAT PARK
 IRVINE, CALIFORNIA
 LOT #106
 CONTACT: ASMARSHALL@UTEP.EDU
 SOLARDECATHLON.UTEP.EDU

CONSULTANTS

CLIENT

U.S. DEPARTMENT OF ENERGY
 SOLAR DECATHLON 2013
 WWW.SOLARDECATHLON.GOV



MARK	DATE	DESCRIPTION
01	10/11/2012	80% DCENR DD SUBMISSION
02	11/20/2012	80% DCENR DD RE-SUBMISSION
03	02/14/2013	95% DCENR CD SUBMISSION
03	04/05/2013	95% DCENR RE-SUBMISSION

MARK DATE DESCRIPTION

LOT NUMBER: #106
 DRAWN BY: AUTHOR
 CHECKED BY: CHECKER
 COPYRIGHT: NONE; PROJECT IS PUBLIC DOMAIN

SHEET TITLE

TABLE OF CONTENTS

G-001



TEAM NAME: TEAM TEXAS
 ADDRESS: ORANGE COUNTY GREAT PARK
 IRVINE, CALIFORNIA
 LOT #106
 CONTACT: ASMARSHALL@UTEP.EDU
 SOLARDECATHLON.UTEP.EDU

CONSULTANTS

CLIENT
 U.S. DEPARTMENT OF ENERGY
 SOLAR DECATHLON 2013
 WWW.SOLARDECATHLON.GOV



01	10/11/2012	80% DCENR DD SUBMISSION
02	11/20/2012	80% DCENR DD RE-SUBMISSION
03	02/14/2013	95% DCENR CD SUBMISSION
03	04/05/2013	95% DCENR RE-SUBMISSION


MARK	DATE	DESCRIPTION
------	------	-------------

LOT NUMBER: #106
 DRAWN BY: Author
 CHECKED BY: Checker
 COPYRIGHT: NONE: PROJECT IS PUBLIC DOMAIN

SHEET TITLE


EGRESS PLAN

G-101

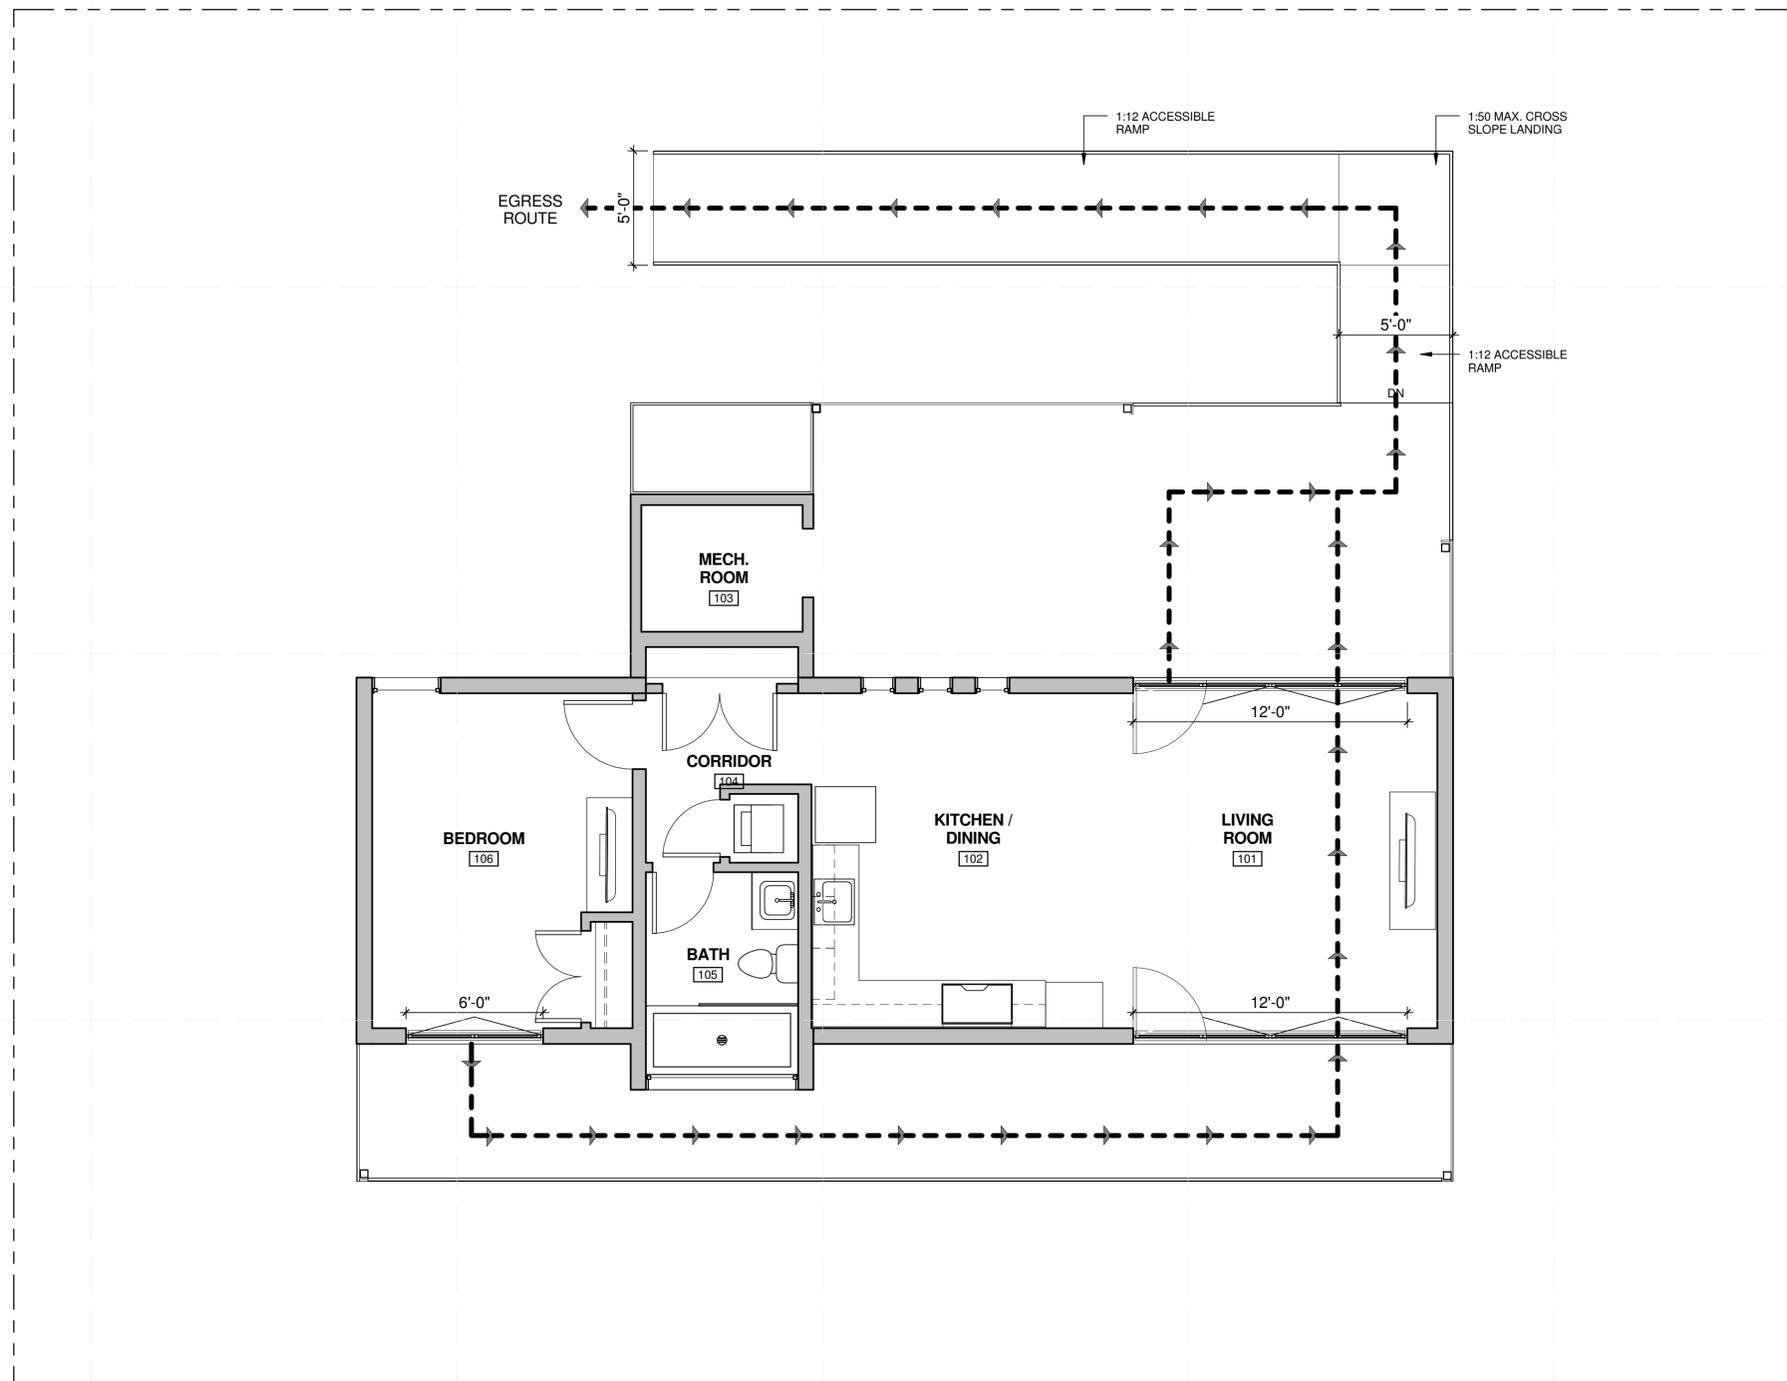

A2 EGRESS PLAN
 1/4" = 1'-0"



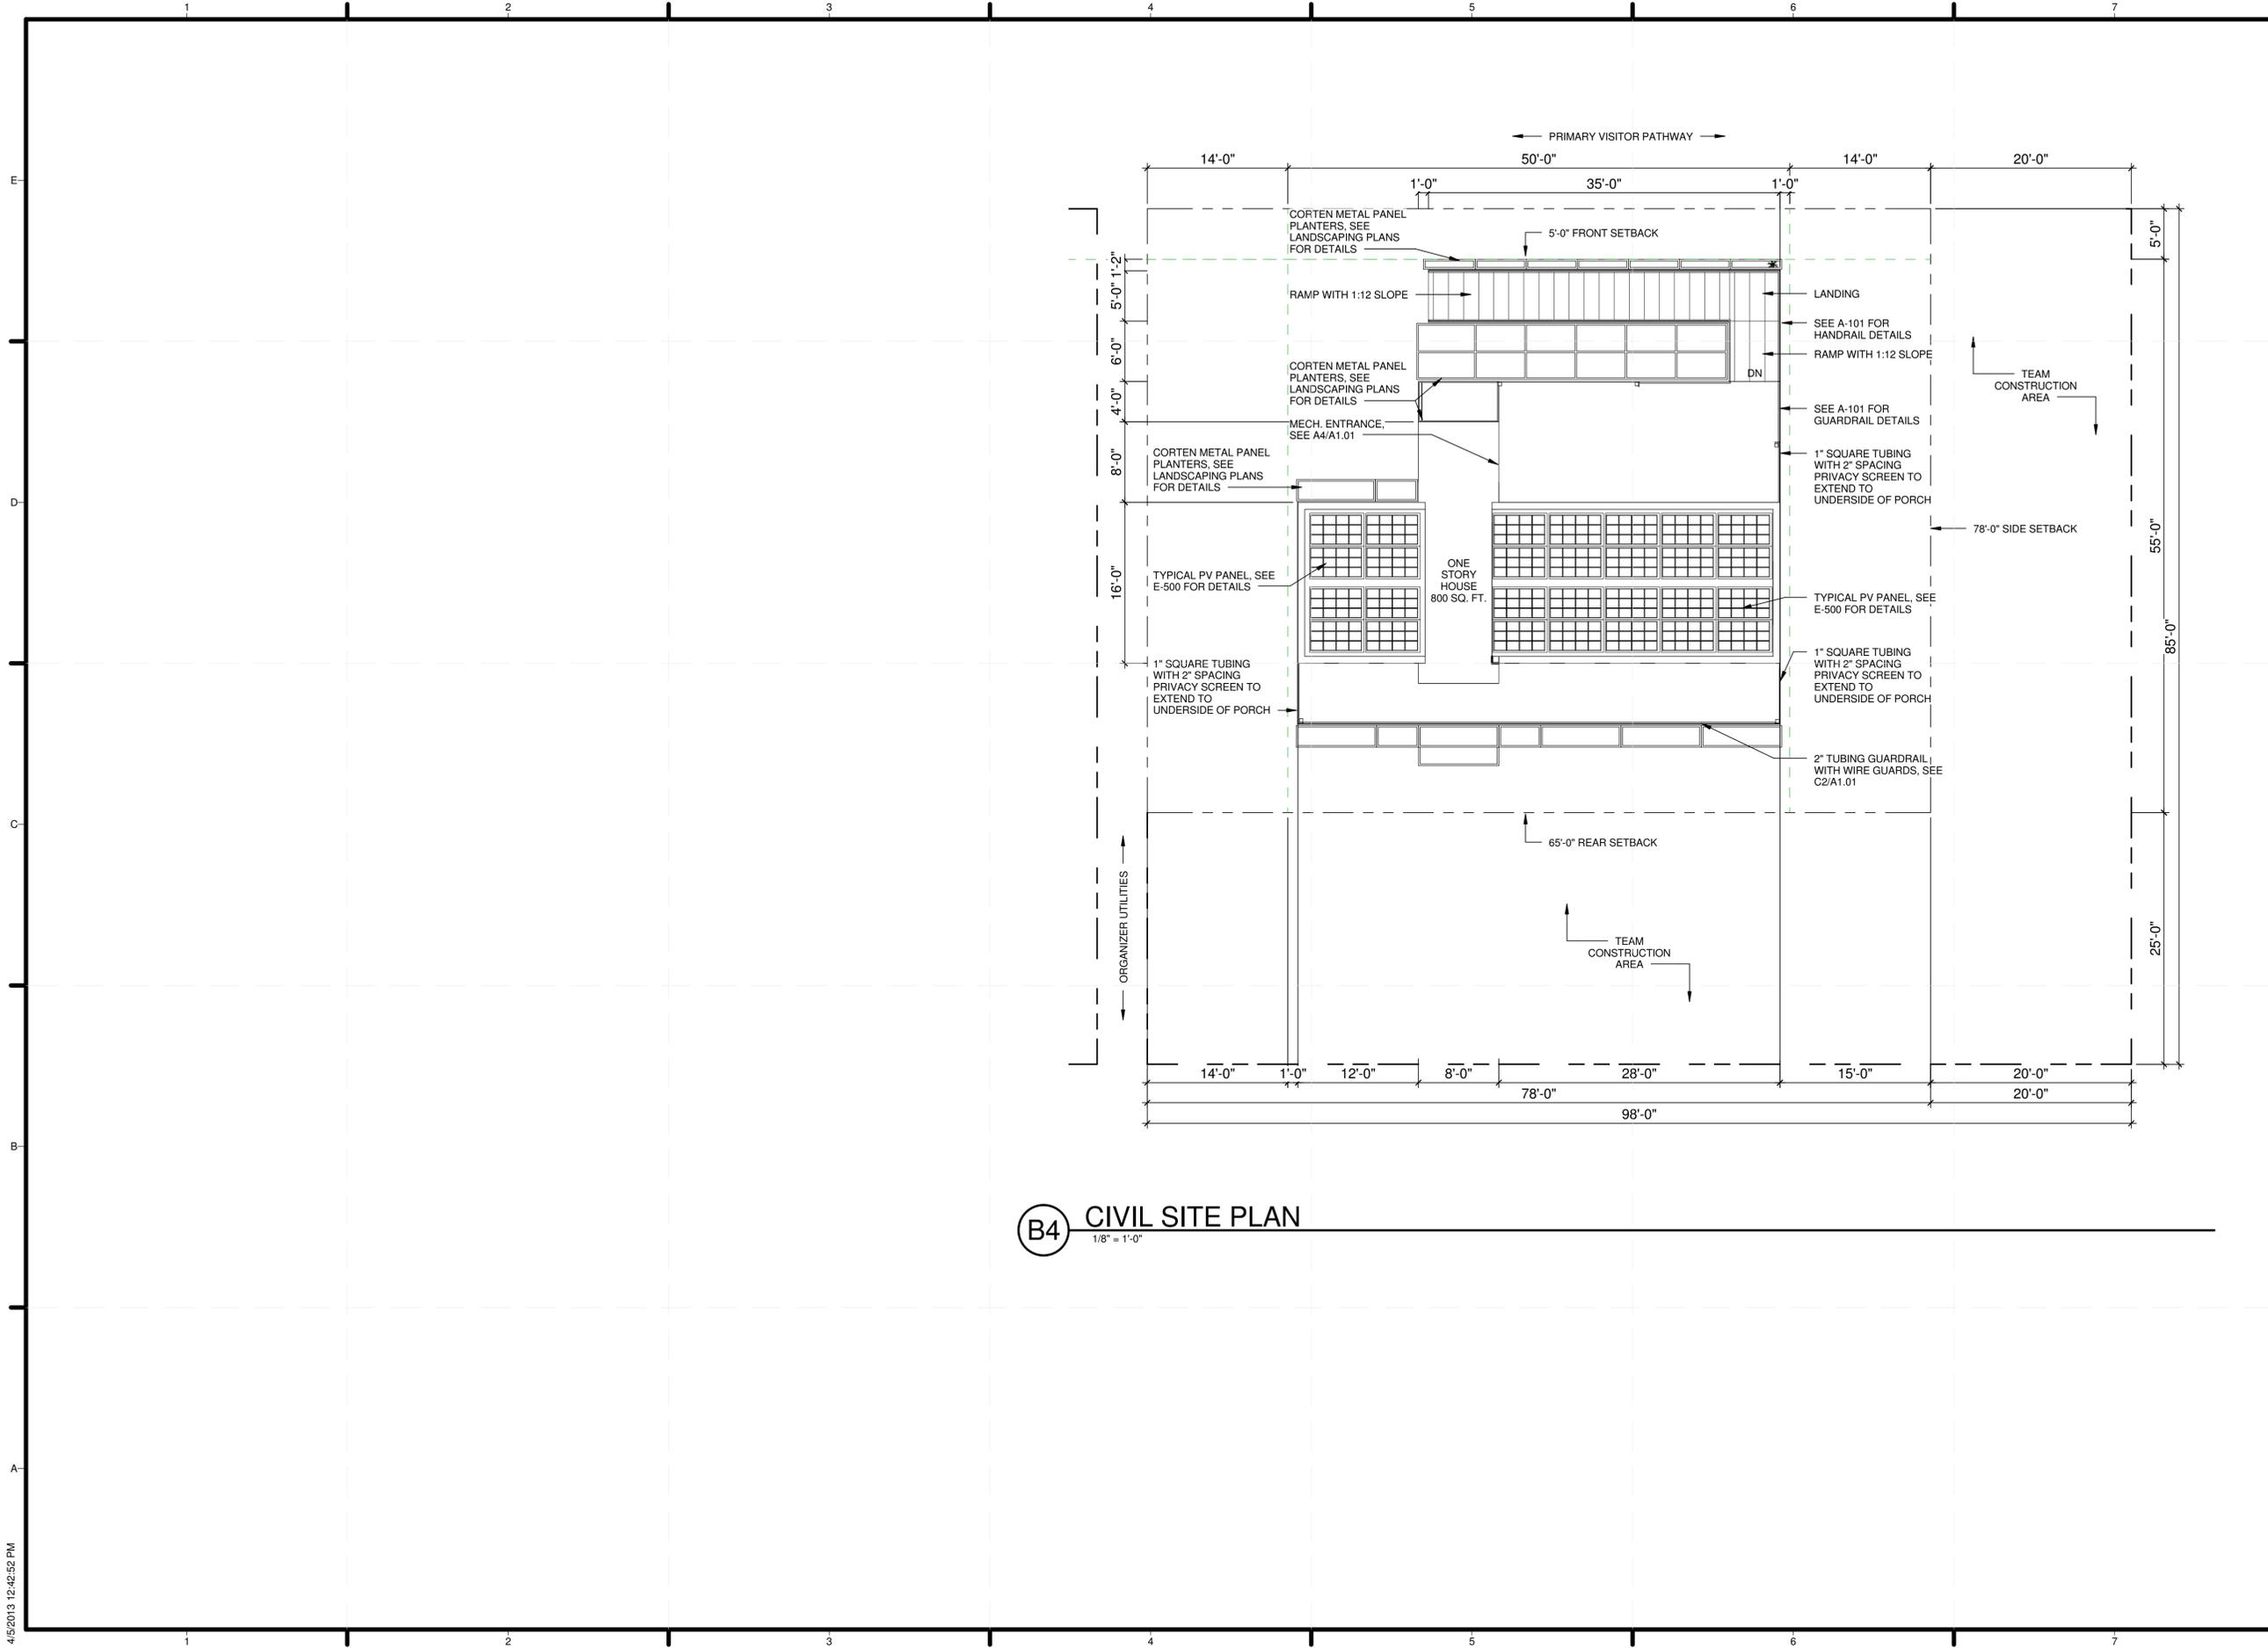

B4 CIVIL SITE PLAN
1/8" = 1'-0"



TEAM NAME: TEAM TEXAS
 ADDRESS: ORANGE COUNTY GREAT PARK
 IRVINE, CALIFORNIA
 LOT #106
 CONTACT: ASMARSHALL@UTEP.EDU
 SOLARDECATHLON.UTEP.EDU

CONSULTANTS



CLIENT
 U.S. DEPARTMENT OF ENERGY
 SOLAR DECATHLON 2013
 WWW.SOLARDECATHLON.GOV




01	10/11/2012	80% DCENR DD SUBMISSION
02	11/20/2012	80% DCENR DD RE-SUBMISSION
03	02/14/2013	95% DCENR CD SUBMISSION
03	04/05/2013	95% DCENR RE-SUBMISSION

MARK	DATE	DESCRIPTION
------	------	-------------


LOT NUMBER: #106
 DRAWN BY: AUTHOR
 CHECKED BY: CHECKER
 COPYRIGHT: NONE: PROJECT IS PUBLIC DOMAIN

SHEET TITLE
SITE UTILITY PLAN


C-103

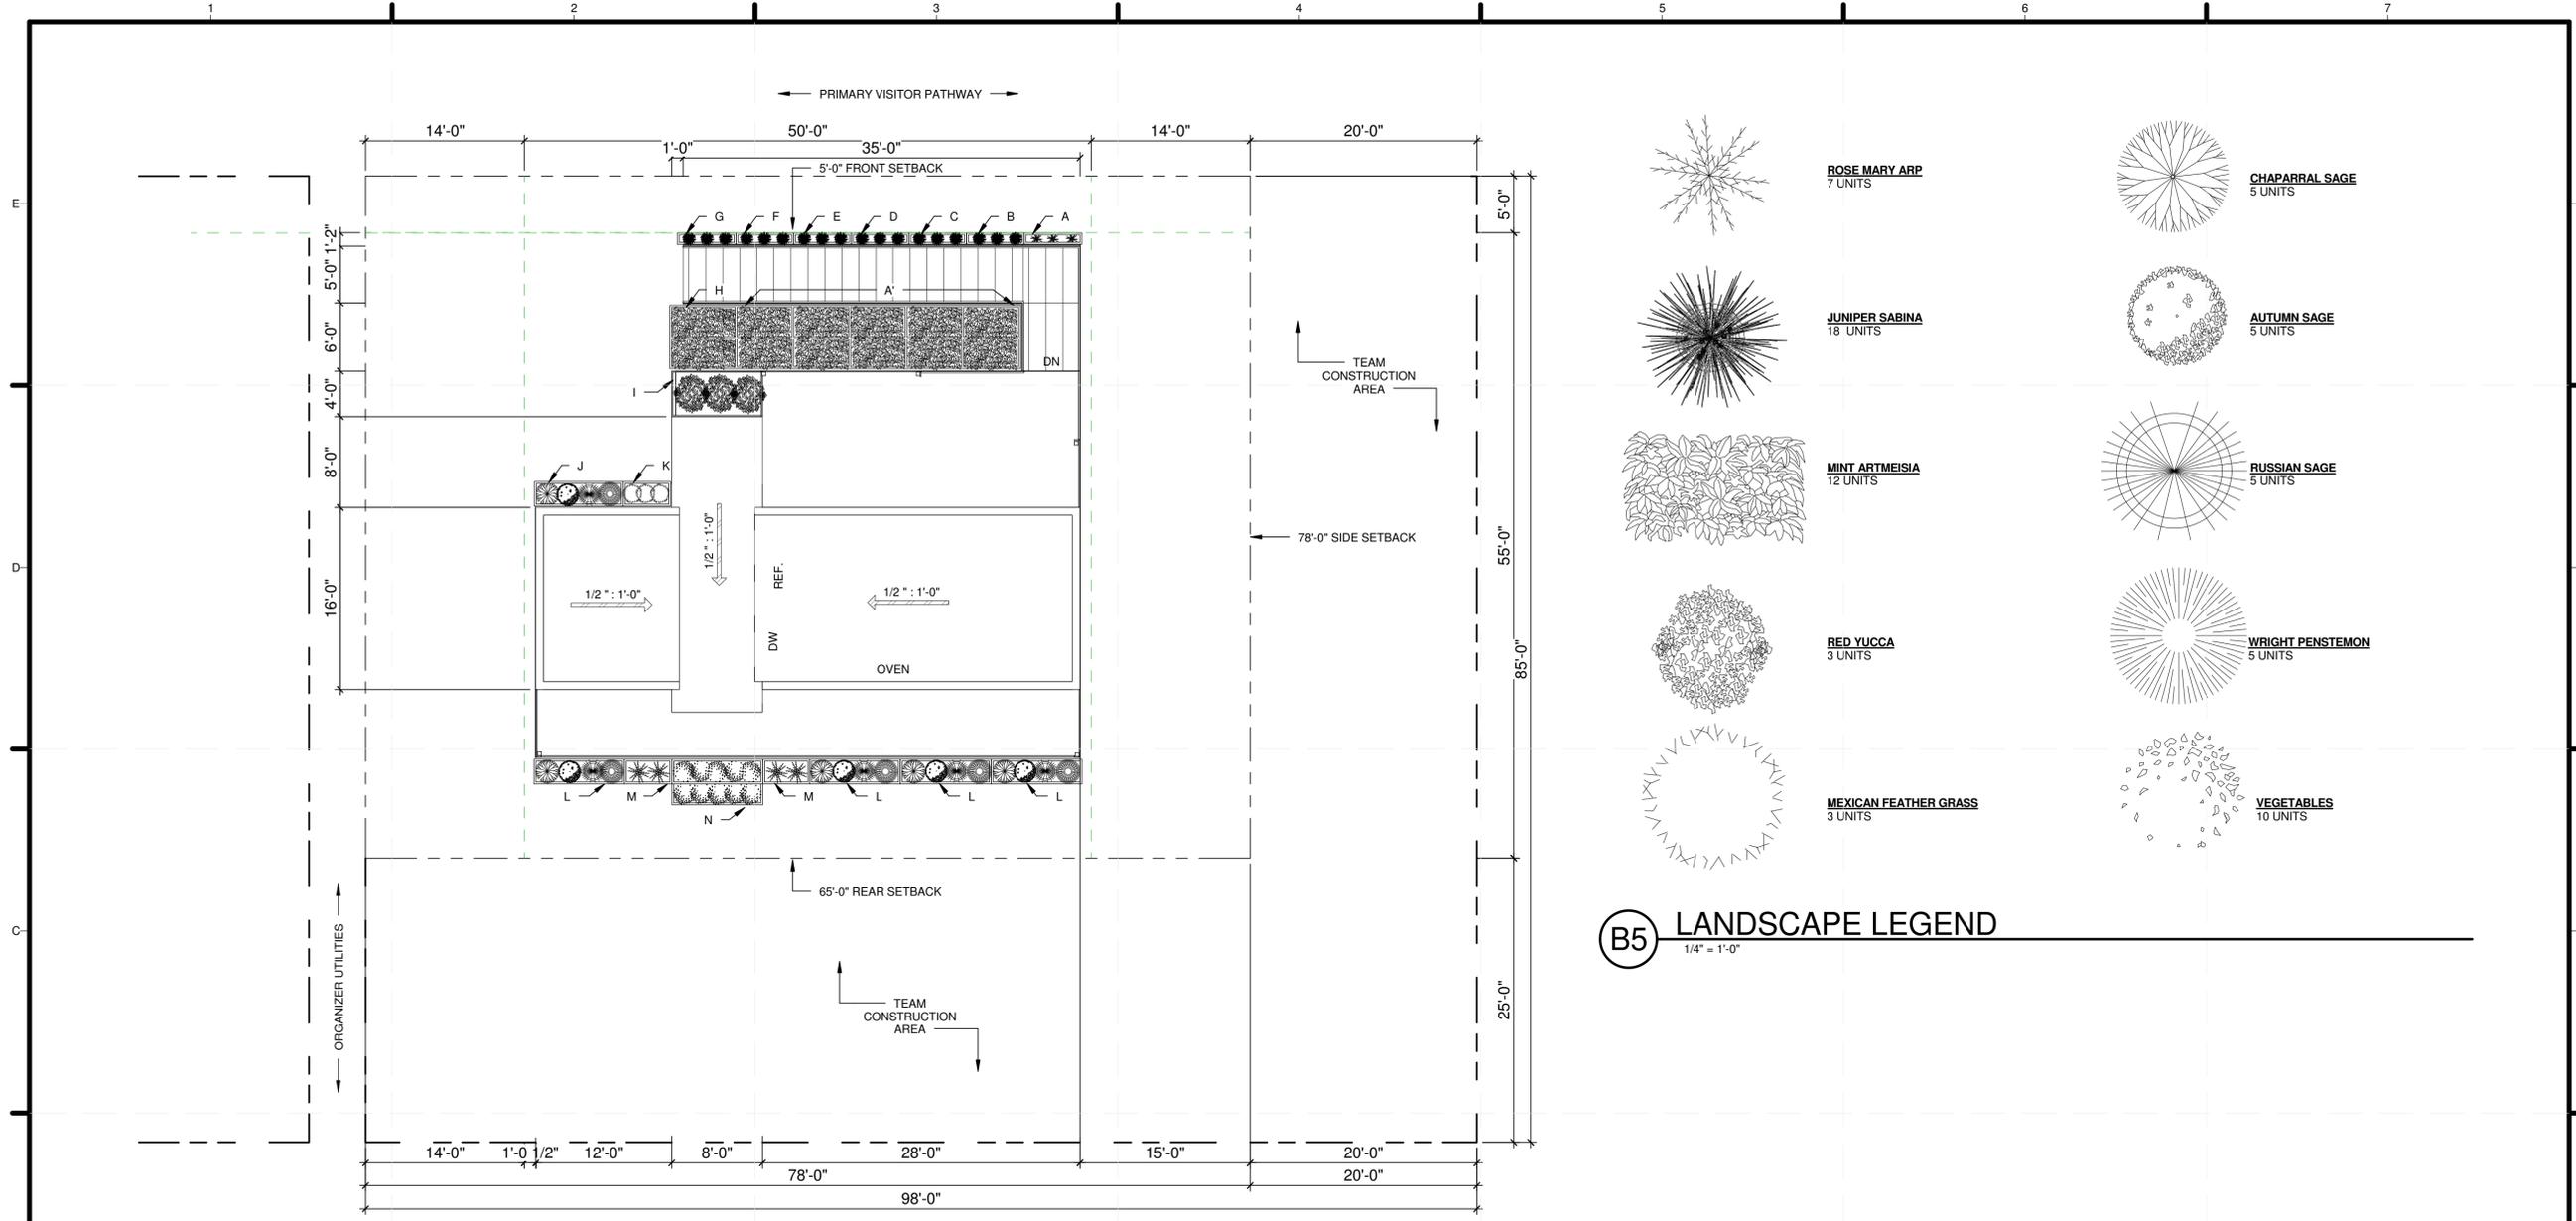

B5 LANDSCAPE LEGEND
1/4" = 1'-0"

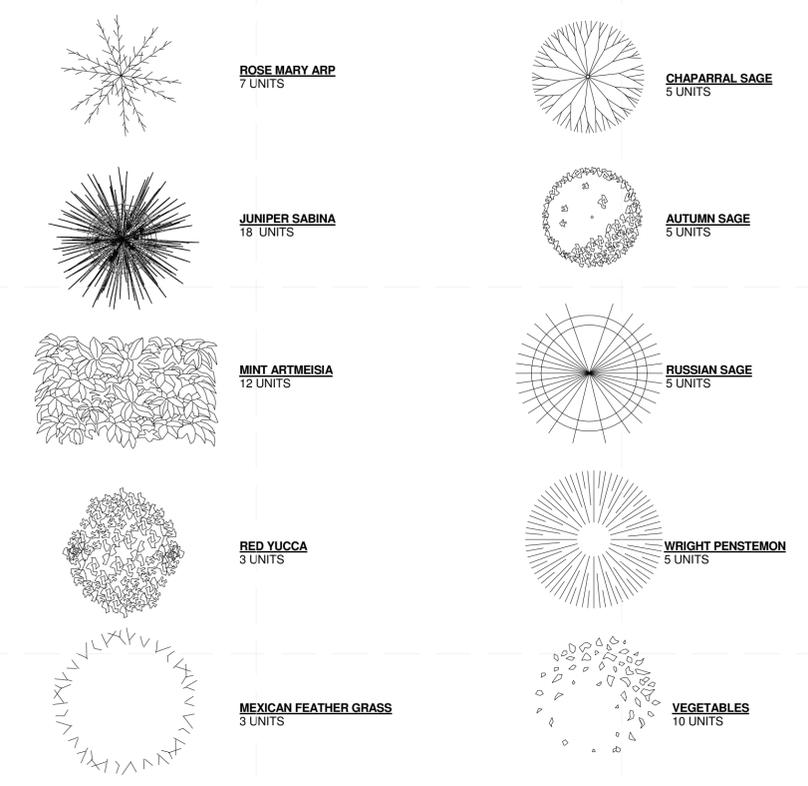


B1 LANDSCAPING PLAN
1/8" = 1'-0"

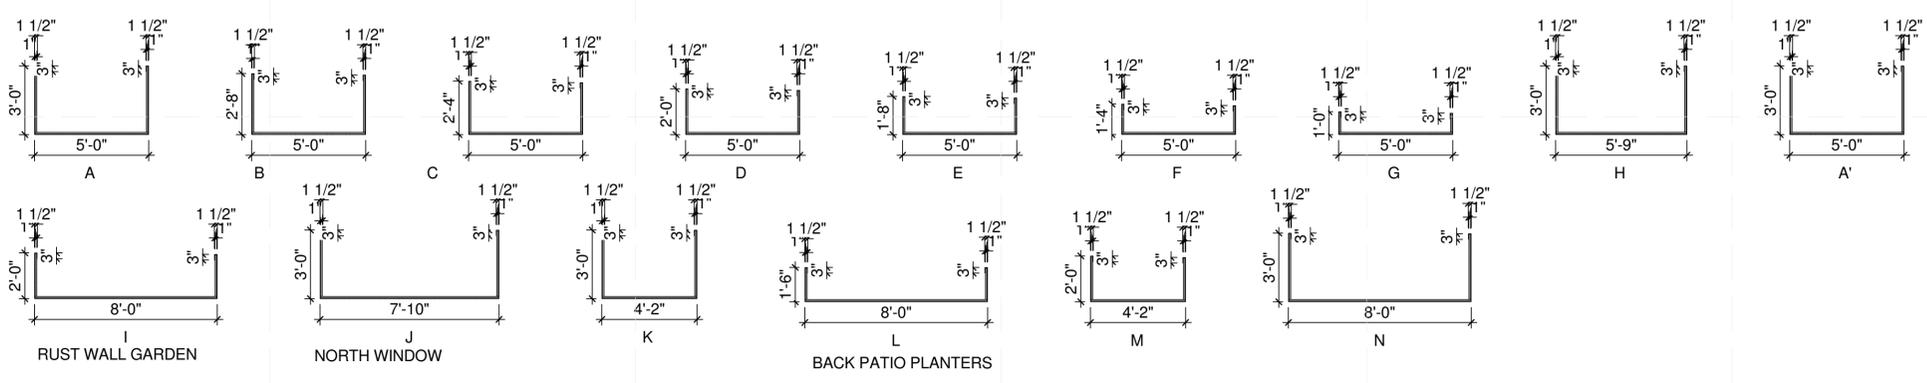

GENERAL NOTES
 PLANTER FRAME
 EXTERIOR COMPOSED OF
 CORTEN STEEL PANELS
 1/4" THICKNESS
 18 GAUGE
 1 SQ IN. TUBING
 2 FT. ON CENTER

A1 PLANTER LEGEND
1/4" = 1'-0"

TEAM NAME: TEAM TEXAS		
ADDRESS: ORANGE COUNTY GREAT PARK IRVINE, CALIFORNIA LOT #106		
CONTACT: ASMARSHALL@UTEP.EDU SOLARDECATHLON.UTEP.EDU		
CONSULTANTS		
CLIENT		
U.S. DEPARTMENT OF ENERGY SOLAR DECATHLON 2013 WWW.SOLARDECATHLON.GOV		
01	10/11/2012	80% DCENR DD SUBMISSION
02	11/20/2012	80% DCENR DD RE-SUBMISSION
03	02/14/2013	95% DCENR CD SUBMISSION
03	04/05/2013	95% DCENR RE-SUBMISSION
MARK	DATE	DESCRIPTION
LOT NUMBER: #106		
DRAWN BY: Author		
CHECKED BY: CHECKER		
COPYRIGHT: NONE: PROJECT IS PUBLIC DOMAIN		
SHEET TITLE		
LANDSCAPE AND PLANTING SITE PLAN		
L-101		

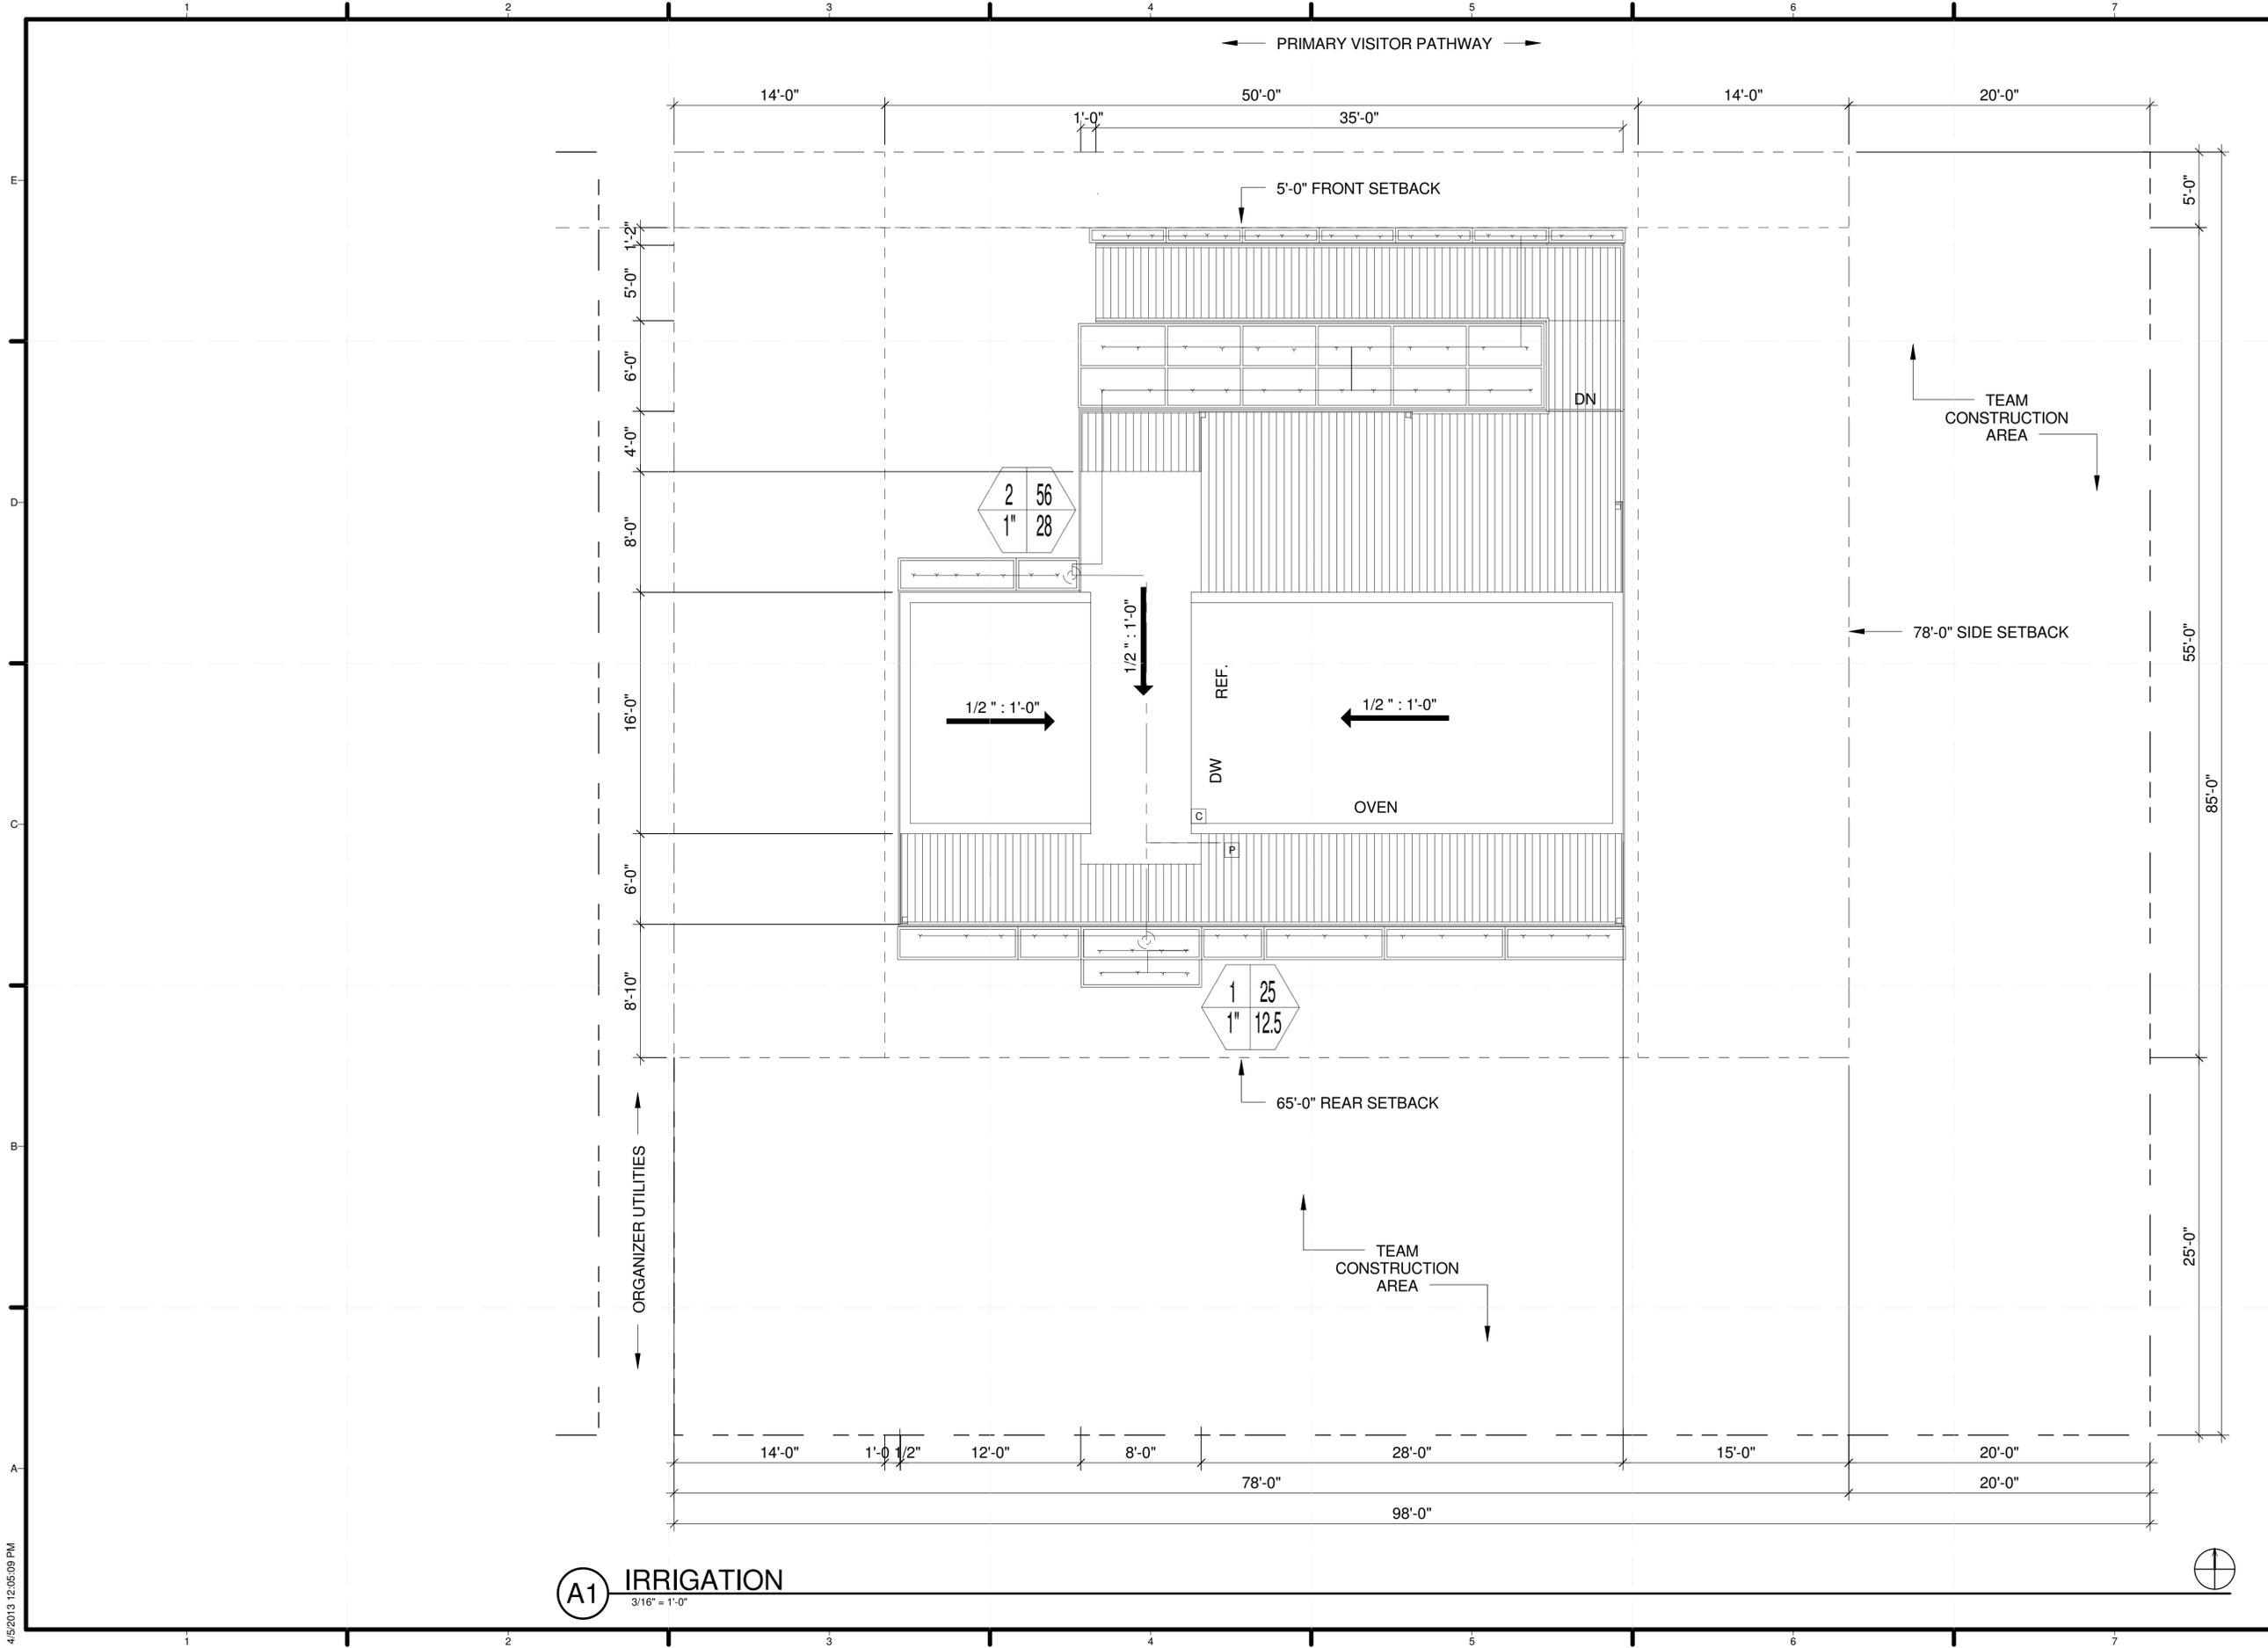

TEAM NAME: TEAM TEXAS
 ADDRESS: ORANGE COUNTY GREAT PARK
 IRVINE, CALIFORNIA
 LOT #106
 CONTACT: ASMARSHALL@UTEP.EDU
 SOLARDECATHLON.UTEP.EDU

CONSULTANTS



CLIENT
 U.S. DEPARTMENT OF ENERGY
 SOLAR DECATHLON 2013
 WWW.SOLARDECATHLON.GOV



01	10/11/2012	80% DCENR DD SUBMISSION
02	11/20/2012	80% DCENR DD RE-SUBMISSION
03	02/14/2013	95% DCENR CD SUBMISSION
03	04/05/2013	95% DCENR RE-SUBMISSION

MARK	DATE	DESCRIPTION
------	------	-------------

LOT NUMBER: #106
 DRAWN BY: Author
 CHECKED BY: CHECKER
 COPYRIGHT: NONE: PROJECT IS PUBLIC DOMAIN

SHEET TITLE

LANDSCAPE IRRIGATION AND GREYWATER PLAN

L-102

(A1) IRRIGATION
 3/16" = 1'-0"

4/5/2013 12:05:09 PM

LANDSCAPE & IRRIGATION GENERAL NOTES

GENERAL NOTES

- CONTRACTOR SHALL BE FAMILIAR WITH PLANS, DETAILS AND SPECIFICATIONS AS THEY PERTAIN TO THE SITE. IT SHALL BE THE CONTRACTOR'S RESPONSIBILITY TO NOTIFY THE OWNER'S REPRESENTATIVE IF ANY ITEMS CONTAINED WITHIN THE SCOPE OF WORK DEFINED HEREIN, ARE IN CONFLICT WITH PROPOSED CONTRACT.
- EXISTING UTILITY LINES ARE TO BE BLUE STAKED PRIOR TO EXCAVATION, CHECK AND FIELD VERIFY ALL SITE CONDITIONS, UTILITIES AND SERVICES PRIOR TO EXCAVATION. CALL FOR BLUE STAKING.
- CONTRACTOR SHALL COORDINATE ALL WORK WITH OTHER CONTRACTORS.

PLANTING NOTES

GENERAL

- SCOPE: WORK COVERED IN THESE NOTES CONSISTS OF THE PLANTING OF SEEDING, TREES, SHRUBS AND GROUND COVERS, GRADING AND MULCHING, INCLUDING THE FURNISHING OF ALL LABOR, EQUIPMENT, MATERIALS AND PERFORMING ALL WORK IN CONNECTION WITH THE DRAWINGS AND SPECIFICATIONS.

PROTECTION

- PROTECTION OF PERSONS AND PROPERTY: LANDSCAPE SUBCONTRACTOR IS TO BARRICADE OPEN EXCAVATIONS OCCURRING AS PART OF THIS WORK AND POST WITH WARNING LIGHTS OR OTHER WARNING MEASURES AS NECESSARY. PROTECTION OF EXISTING SHRUBS, TREES AND OTHER PLANT MATERIALS ARE ALSO TO BE INCLUDED.

- PROTECT STRUCTURES, UTILITIES, SIDEWALKS, PAVEMENTS AND OTHER FACILITIES FROM DAMAGE CAUSED BY SETTLEMENT, LATERAL MOVEMENT, UNDERMINING, WASHOUT AND OTHER HAZARDS CREATED BY EARTHWORK OPERATIONS. ALL DAMAGES THAT MAY OCCUR DURING THIS PHASE OF WORK SHALL BE THE CONTRACTOR'S FINANCIAL RESPONSIBILITY.

GRADING

- PERFORM GRADING AND EXCAVATION WORK IN COMPLIANCE WITH APPLICABLE SPECIFICATIONS, REQUIREMENTS, CODES AND ORDINANCES OF ALL GOVERNING BODIES HAVING JURISDICTION.
- ROUGH GRADING: ROUGH GRADING SHALL BE PERFORMED TO SPECIFICATIONS BY EARTHWORK SUBCONTRACTOR TO WITHIN +/- 0.1 FT. OF PLAN CONTOURS
- FINE GRADING: SURFACE SHALL BE RAKED FREE OF STONES AND EXTRANEOUS MATERIALS AND DEBRIS LARGER THAN 1" TO A SMOOTH AND EVEN TEXTURE. ALL EXTRANEOUS MATTER WILL BE DISPOSED OF BY LANDSCAPE SUBCONTRACTOR.

PLANTINGS

- PLANT MATERIAL SUBSTITUTIONS SHALL NOT BE MADE WITHOUT THE WRITTEN PERMISSION OF THE LANDSCAPE ARCHITECT. THE USE OF MATERIALS DIFFERING IN KIND, QUALITY OR SIZE FROM THAT SPECIFIED WILL BE ALLOWED ONLY AFTER THE LANDSCAPE ARCHITECT IS CONVINCED THAT ALL MEANS OF OBTAINING THE SPECIFIED MATERIAL HAVE BEEN EXHAUSTED. AT THE TIME BIDS ARE SUBMITTED, THE CONTRACTOR IS ASSUMED TO HAVE LOCATED THE MATERIALS NECESSARY TO COMPLETE THE JOB AS SPECIFIED. ALL REQUESTS FOR SUBSTITUTIONS MUST BE SUBMITTED NO LATER THAN 2 WEEKS PRIOR TO THE INITIATION OF WORK.
- PLANT MATERIAL QUALITY, SIZE AND CONDITION SHALL BE IN ACCORDANCE WITH AMERICAN STANDARD FOR NURSERY STOCK, 1980 EDITION. AS PUBLISHED BY THE COMMITTEE ON HORTICULTURAL STANDARDS OF THE AMERICAN ASSOCIATION OF NURSERYMEN, INC.
- ALL PLANTS SHALL BE TYPICAL OF THEIR SPECIES OR VARIETY. ALL PLANTS SHALL HAVE NORMAL, WELL DEVELOPED BRANCHES AND VIGOROUS ROOT SYSTEMS. THEY SHALL BE SOUND, HEALTHY, VIGOROUS, FREE FROM DEFECTS, DISFIGURING KNOTS, ABRASIONS OF THE BARK, SUNSCALED INJURIES, PLANT DISEASES, INSECT EGGS, BORES AND ALL OTHER FORMS OF INFECTIONS.
- UNLESS OTHERWISE STATED ON THE DRAWINGS OR APPROVED BY OWNER'S REPRESENTATIVE, ALL PLANTS SHALL BE NURSERY GROWN AND SHALL BE TAGGED WITH NURSERY LABELS INDICATING SPECIES AND VARIETY.
- NONCONTAINER GROWN PLANTS SHALL HAVE A SOLID BALL OF EARTH OF MINIMUM SPECIFIED SIZE AND HELD IN PLACE SECURELY BY BURLAP AND A STOUT TWINE OR ROPE. BROKEN OR LOOSE BALLS WILL BE REJECTED.
- UNLESS SPECIFICALLY NOTED ON THE DRAWING, ALL TREES SHALL HAVE A SINGLE TRUNK THAT IS STRAIGHT AND FREE OF "DOGS-LEGS," "CROOKS," "Y-CROTCHES," OR OTHER DISFIGURING SHAPES. THE CENTRAL LEADER OF ALL TREES SHALL NOT HAVE BEEN PRUNED. TREES WITH DOUBLE LEADERS ARE NOT ACCEPTABLE, UNLESS SPECIFIED AS MULTI-TRUNKED.
- ALL PLANT MATERIAL SHALL HAVE A UNIFORM SHAPE AROUND ITS COMPLETE CIRCUMFERENCE PLANT MATERIAL WITH IRREGULAR BRANCHING PATTERNS OR WITH BRANCHING PATTERNS MORE HIGHLY DEVELOPED ON ONE SIDE THAN ON OTHER SIDES SHALL NOT BE ACCEPTABLE.

JOB SITE

- THE LANDSCAPE ARCHITECT WILL INSPECT PLANT MATERIAL AT A WHOLESALE NURSERY OF THE CONTRACTOR'S CHOICE PRIOR TO DELIVERY OF MATERIALS TO THE CONTRACTOR'S YARD. HOWEVER, AT NO ADDITIONAL EXPENSE TO THE OWNER, THE CONTRACTOR SHALL BE RESPONSIBLE FOR ALL TRAVEL EXPENSES INCURRED BY THE OWNER'S REPRESENTATIVE FOR ANY TRAVEL OUTSIDE OF THE LOCAL AREA.
- THE LANDSCAPE SUBCONTRACTOR SHALL BE LIABLE FOR ANY LOSS OR DAMAGE TO ANY WORK OR MATERIALS, SUPPLIES AND EQUIPMENT ON THE JOB SITE CAUSED BY THE LANDSCAPE SUBCONTRACTOR, ITS EMPLOYEES OR ANY PROJECT WITH THE OWNER'S REPRESENTATIVE/OWNER.

- LANDSCAPE ARCHITECT AND GENERAL CONTRACTOR'S QUALITY CONTROL INSPECTOR SHALL BE THE JUDGE OF THE QUALITY AND ACCEPTABILITY OF ALL PLANT MATERIALS. ALL REJECTED MATERIAL SHALL BE IMMEDIATELY REMOVED FROM THE SITE AND REPLACED WITH ACCEPTABLE MATERIAL AT NO ADDITIONAL COST TO OWNER.

MULCHING

- ALL PLANTING BEDS SHOWN ON PLANS SHALL BE MULCHED. NO BEDS WILL BE LEFT UNCOVERED OR NOT TOP DRESSED, UNLESS OTHERWISE SPECIFIED.

CARE AND REPLACEMENT

- ALL TREES, SHRUBS AND GROUND COVERS SHALL BE GUARANTEED FOR THE PERIOD OF ONE FULL YEAR BEGINNING ON THE DATE OF FINAL ACCEPTANCE.

SEEDING NOTES

GENERAL

- ALL AREAS DISTURBED OR DENIED OF VEGETATION SHALL BE RESEEDED WITH THE SEED MIX OR SOD AS DESCRIBED IN THE PLANS AND SPECIFICATIONS.
- ALL DISTURBED OR DENIED AREAS BEYOND THE LIMITS OF CONSTRUCTION SHALL BE RESEEDED AS PER THE SEED MIX AND AS PER THE LANDSCAPE ARCHITECT'S DIRECTION.
- ALL RECLAMATION SEEDING OUTSIDE THE LIMITS OF CONSTRUCTION SHALL BE CONSIDERED INCIDENTAL TO CONTRACT.






IRRIGATION NOTES

GENERAL

- IRRIGATION IN TEXAS IS REGULATED BY THE TEXAS COMMISSION ON ENVIRONMENTAL QUALITY, P.O. BOX 13087, AUSTIN, TX 78711-3087.
- WORK UNDER THIS SECTION CONSISTS OF INSTALLING A COMPLETE UNDERGROUND IRRIGATION SYSTEM AS SHOWN ON THESE PLANS, DETAILS AND SPECIFICATIONS. THE LANDSCAPE SUBCONTRACTOR PERFORMING THIS WORK SHALL FURNISH ALL LABOR, EQUIPMENT, MATERIALS, INCIDENTAL WORK, AND PERMITS NECESSARY FOR THE COMPLETION OF THE IRRIGATION SYSTEM, EXCEPT FOR THOSE COMPONENTS SPECIFIED TO BE FURNISHED BY OTHERS.
- ALL ROADWAY TRENCHING, PATCHING, AND TRAFFIC CONTROL SHALL BE PERFORMED TO THE CITY OF EL PASO STANDARDS FOR PUBLIC WORK CONSTRUCTION. THE LANDSCAPE SUBCONTRACTOR SHALL PREPARE FOR THE OWNER AND OTHER REQUIRED ENTITIES HAVING JURISDICTION A TRAFFIC CONTROL PLAN AND A PROJECTED TIME SCHEDULE.
- THE LANDSCAPE SUBCONTRACTOR SHALL COORDINATE WATER "TAP-IN" LOCATIONS AND CONTROLLER LOCATIONS WITH THE CONTRACTOR'S QUALITY CONTROL INSPECTOR AND LANDSCAPE ARCHITECT PRIOR TO INSTALLATION.
- ALL PLANT MATERIALS SHALL BE IRRIGATED WITH AUTOMATIC IRRIGATION SYSTEMS AS PER PLANS, DETAILS AND SPECIFICATIONS UNLESS OTHERWISE INDICATED ON THE DRAWINGS.
- WHERE TREES, LIGHT STANDARDS, ETC. ARE AN OBSTRUCTION OF PIPING AND DRIP EMITTERS, THEY SHALL BE ADJUSTED AND/OR RELOCATED AS NECESSARY TO OBTAIN FULL COVERAGE WITHOUT EXCESSIVE OVERFLOW. PLANS ARE DIAGRAMMATIC AND APPROXIMATE DUE TO SCALE OF DRAWINGS. ALL VALVES SHALL BE LOCATED IN PLANTING AREAS OR SODDEN AREAS WHERE SHOWN AND ALL PIPING SHALL BE INSTALLED PRIOR TO LANDSCAPING OR PAVING WORK. NO TEES, ELLS OR OTHER TURNS IN PIPING SHALL BE LOCATED UNDER PAVING. CAP ALL ENDS HAND TIGHT, PRIOR TO BACKFILL.
- COMPLY WITH REQUIREMENTS OF THE I.P.C. AND ANY OTHER GOVERNMENTAL BODIES HAVING JURISDICTION.
- ALL BACKFILL SHALL BE IMPORTED CLEAN MATERIAL. TRENCH IS TO BE EVEN WITH EXISTING GRADES AFTER COMPACTION. NO ORGANIC MATERIAL AND NO STONES IN BACKFILL LARGER THAN 1/2" IN DIAMETER.
- TRENCH BACKFILL MATERIAL SHALL BE COMPACTED 85% PROCTOR DENSITY
- COORDINATE PROGRAMS TO AVOID STATION OVERLAP.
- LANDSCAPE SUBCONTRACTOR TO FLUSH ALL LINES PRIOR TO INSTALLING HEADS AND EMITTERS.
- ALL VALVES TO BE IN APPROVED VALVE BOXES (SEE SPECS AND NOTES). LOCATE VALVE BOXES IN GROUPINGS OF TWO OR THREE AND LOCATE NEAR WALKWAYS WHERE POSSIBLE. ALL VALVES TO BE TAGGED WITH THE VALVE RESPECTIVE NUMBER.
- LANDSCAPE SUBCONTRACTOR SHALL PREPARE THOROUGH AND CORRECT SET OF AS-BUILT DRAWINGS AND SPECIFICATIONS FOR SUBMITAL TO THE GENERAL CONTRACTOR AS A PREREQUISITE FOR FINAL PAYMENT.
- THE MAINLINE SHALL BE PRESSURE TESTED AT 150 PSI FOR 4 HOURS, WITNESSED BY THE GENERAL CONTRACTOR'S QUALITY CONTROL INSPECTOR

COMPONENTS AND PRODUCTS

- ALL COMPONENTS INSTALLED AS THE UNDERGROUND IRRIGATION SYSTEM ARE TO BE NEW AND IN GOOD WORKING ORDER AND WITHOUT FLAWS UNLESS OTHERWISE INDICATED ON THE PLANS, DETAILS AND SPECIFICATIONS.
 - IF THE CONTRACT DRAWINGS AND/OR SPECIFICATIONS DO NOT THOROUGHLY DESCRIBE THE METHOD OR TECHNIQUES TO BE USED FOR INSTALLATION, THE LANDSCAPE SUBCONTRACTOR SHALL FOLLOW THE INSTALLATION METHODS RECOMMENDED BY THE MANUFACTURER.
 - ALL PLANT MATERIALS INSTALLED SHALL HAVE THE AUTOMATIC IRRIGATION SYSTEM FULLY OPERABLE AT THE TIME OF PLANT INSTALLATION.
- CARE AND REPLACEMENT
- THE LANDSCAPE SUBCONTRACTOR SHALL SUPPLY ALL WARRANTIES OF COMPONENTS OF THE IRRIGATION SYSTEM TO THE GENERAL CONTRACTOR
 - THE CONTRACTOR SHALL MAINTAIN THE IRRIGATION SYSTEM IN SATISFACTORY WORKING ORDER DURING THE TIME OF CONTRACT WORK
 - CONTRACTOR SHALL MAINTAIN & WATER ALL TREES & TURF WHILE THE OLD IRRIGATION SYSTEM IS DOWN.

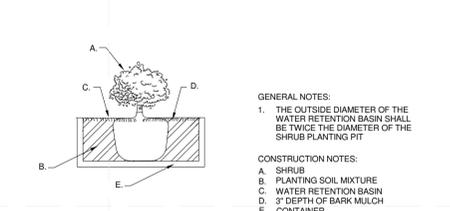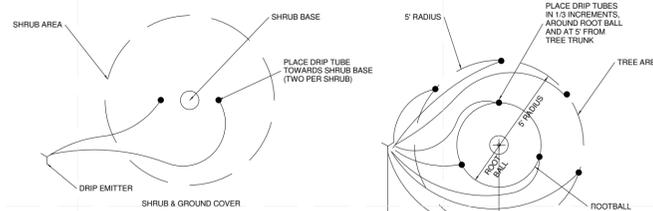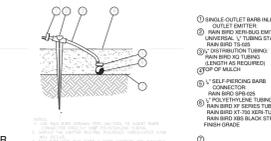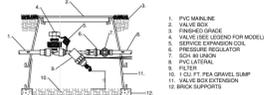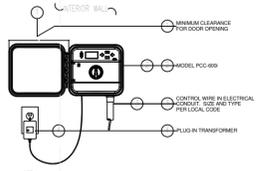

IRRIGATION LEGEND

SYM	ITEM	QTY
[Symbol]	HUNTER PCC-600, 6 STATION INDOOR CONTROLLER	1
[Symbol]	1" REMOTE CONTROL VALVE, HUNTER PG101G INSTALL WYE FILTERS AFTER THE VALVE ON ALL DRIP ZONES.	1
[Symbol]	1" MAIN LINE - SCHED. 40 PVC	
[Symbol]	1" LATERAL LINE - SCHED. 40 PVC	
[Symbol]	RAINBIRD PURPLE DRIP LINE 3/4" POLY	
[Symbol]	PVC TO POLY CONVERTER	

NOTES

- ALL EQUIPMENT SPECIFIED MAY BE SUBSTITUTED WITH AN EQUAL APPROVED BY LANDSCAPE ARCHITECT & OWNER.
- THIS PLAN IS SCHEMATIC FOR READABILITY. CONTRACTOR MAY FIELD ADJUST EQUIPMENT LOCATIONS AS NECESSARY. FIELD VERIFY CONTROLLER AND WIRE LOCATIONS WITH LANDSCAPE ARCHITECT.
- ALL EQUIPMENT TO BE INSTALLED AS PER MANUFACTURERS SPECIFICATIONS UNLESS DETAILED OTHERWISE ON PLANS.
- ALL UTILITIES ARE TO BE BLUE STAKED PRIOR TO EXCAVATION. CHECK AND FIELD VERIFY ALL SITE CONDITIONS, UTILITIES AND SERVICES PRIOR TO EXCAVATION. CALL N.M. ONE CALL AT 260-1990 FOR BLUE STAKING.
- ALL OPEN EXCAVATIONS OCCURRING FROM THIS WORK SHALL BE BARRICADED AS NECESSARY.
- PERFORM ALL ASPECTS OF WORK IN COMPLIANCE WITH ALL APPLICABLE SPECIFICATIONS, REQUIREMENTS, CODES, AND ORDINANCES OF ALL GOVERNING BODIES HAVING JURISDICTION.
- PLANS ARE SCHEMATIC. CONTRACTOR MAY ADJUST ALL LATERAL LINES TO ECONOMIZE PIPING AS LONG AS GENERAL VALVE ZONING REMAINS AS INTENDED ON DRAWINGS. THEREFORE, CONTRACTOR SHALL SIZE ALL PIPE AS PER INDUSTRY STANDARD FRICTION LOSS CHARACTERISTICS FOR PVC CLASS 40 IPS PLASTIC PIPE. VALVES AND MAINLINE HAVE BEEN SIZED AS PER FLOW AND SHALL NOT BE REDUCED IN SIZE WITHOUT PERMISSION OF THE LANDSCAPE ARCHITECT.
- CONTRACTOR SHALL STUB 3 EXTRA CONTROL WIRES TO THE FARTHEST VALVE BOX IN EACH BRANCH OF MAINLINE FOR FUTURE EXPANSION.



TEAM NAME: TEAM TEXAS
 ADDRESS: ORANGE COUNTY GREAT PARK
 IRVINE, CALIFORNIA
 LOT #106
 CONTACT: ASMARSHALL@UTEP.EDU
 SOLARDECATHLON.UTEP.EDU

CONSULTANTS



CLIENT
 U.S. DEPARTMENT OF ENERGY
 SOLAR DECATHLON 2013
 WWW.SOLARDECATHLON.GOV



01	10/11/2012	80% DOE/NR DD SUBMISSION
02	11/20/2012	80% DOE/NR DD RE-SUBMISSION
03	02/14/2013	95% DOE/NR CD SUBMISSION
03	04/05/2013	95% DOE/NR RE-SUBMISSION

MARK	DATE	DESCRIPTION

LOT NUMBER: #106
 DRAWN BY: Author
 CHECKED BY: Checker
 COPYRIGHT: NONE; PROJECT IS PUBLIC DOMAIN

SHEET TITLE

LANDSCAPE
 IRRIGATION NOTES
 AND DETAILS

L- 103

1 LANDSCAPE IRRIGATION NOTES AND DETAILS

1/16" = 1'-0"

GENERAL STRUCTURAL NOTES

DESIGN CRITERIA:

ROOF DEAD LOADS:	12 PSF
FLOOR DEAD LOADS:	15 PSF
LIVE LOADS:	
ROOF	20 PSF
FLOOR	60 PSF
WIND LOADING:	
BASIC WIND SPEED	115 MPH
BUILDING CATEGORY	II
IMPORTANCE FACTOR	1.0
WIND EXPOSURE	C
DESIGN WIND PRESSURE	19.6 PSF
DESIGN UPLIFT PRESSURE	22.0 PSF

LATERAL FORCE RESISTING SYSTEM:

LFRS IS COMPRISED OF 6 1/2" THICK STRUCTURAL INSULATED PANEL WALLS MANUFACTURED BY INSULATED COMPONENT STRUCTURES - ROCKY MOUNTAIN INC. SHEAR TRANSFER BETWEEN FLOORS AND FOUNDATION ARE ACCOMPLISHED WITH BOLTED CONNECTION TO W-BEAM AND BOLTED CONNECTION TO CP SEISMIC PIER MANUFACTURED BY CENTRAL PIERS. HELD DOWN BY CONCRETE FOOTING AND STEEL BRACES.

SEISMIC LOADING:

OCCUPANCY CATEGORY	II
SEISMIC USE GROUP	I
SEISMIC IMPORTANCE FACTOR	1.0
SPECTRAL RESPONSE COEFFICIENTS:	
SDS = 0.995	
SD1 = 0.554	
SEISMIC DESIGN CATEGORY	D
DESIGN BASE SHEAR	5040 LB
BASIC SEISMIC FORCE RESISTING SYSTEM:	
LIGHT-FRAMED WALLS SHEATHED WITH WOOD STRUCTURAL INSULATED PANELS	
RESPONSE MODIFICATION FACTOR, R	7

CONCRETE NOTES:

- CONCRETE MIXES:

MINIMUM SPECIFIED, 28 DAY	MAXIMUM		
COMPRESSIVE STRENGTH (PSI)	AGG. SIZE	SLUMP	
FOOTINGS	4000	1 1/2"	4" - 6"
- CONCRETE SHALL BE NORMAL WEIGHT.
- REINFORCING STEEL SHALL CONFORM TO ASTM A 615, GRADE 60.
- USE COVER OF 1 1/2" THROUGHOUT FOOTING.
- PROVIDE AN ADDITIONAL 1/8" FOR HOLES STEEL STAKES HOLES.
- PROVIDE AN ADDITIONAL 1/16" FOR HOLES WEDGE ANCHORS WITH A 2.5" EMBEDMENT.

REINFORCING STEEL NOTES:

- REINFORCING STEEL SHALL CONFORM WITH ASTM A 615, GRADE 60.
- REINFORCING STEEL SHALL BE CONTINUOUS IN FOOTINGS AT ALL CORNERS AND INTERSECTIONS. REINFORCEMENT CLEAR CONCRETE COVER:

SIDES OF FORMED GRADE BEAM	1 1/2"
PLACED AGAINST EARTH	1 1/2"

CP SEISMIC PIERS NOTES:

- SEISMIC PIERS SHALL BE CP SEISMIC MANUFACTURED BY CENTRAL PIERS.
- HEIGHT OF PIER SHALL BE 11" AND EXTEND UP TO 18".
- PIER USED AT PERIMETER SHALL BE CP SEISMIC PERIMETER PIER BY CENTRAL PIERS.
- REPLACE CONCRETE PAD FOOTING WITH 4"X32"X32" REINFORCED FOOTING.
- CP SEISMIC PIER SHALL BE CONNECTED TO W-BEAM WITH 4 3/8" BOLTS WITH WASHER AND NUTS ON BOTH SIDES OF FLANGE.
- CP SEISMIC PIER SHALL BE CONNECTED TO FOOTING WITH 5/8" STAINLESS STEEL WEDGE ANCHORS MANUFACTURED BY STRONG TIE WITH 2.5" EMBEDMENT.

STRUCTURAL STEEL NOTES:

- STRUCTURAL STEEL SHALL CONFORM WITH THE FOLLOWING:

WIDE-FLANGE BEAMS:	ASTM A 992
WIDE-FLANGE BEAM BOLTS	ASTM A 325
ALL OTHER BOLTS	ASTM A 307
STEEL STAKES	ASTM A 36
ANGLES, PLATES, ETC.	ASTM A 36
HSS MEMBERS	ASTM A 500 GR. B 46
- W-BEAM SHALL BE LEVELED FLAT BEFORE LAYING INTERIOR HOME MODULE ON IT.
- W-BEAM SHALL BE CONNECTED TO FLOOR FRAME WITH 1/2" THRU BOLTS WITH WASHER AND NUTS.
- STEEL STAKES SHALL BE SOLID. COMPOSITION PIPE IS NOT PERMISSIBLE.
- WHERE W10X33 SUPPORTING BEAM CONNECTS TO W8X13 SUPPORTED BEAM WITH DOUBLE ANGLES, PROVIDE AN ADDITIONAL 1/8" GREATER THAN SUPPORTED BEAM THICKNESS.
- ALL HSS MEMBERS' CONNECTIONS SHALL BE PREFABRICATED.
- USE STANDARD HOLES FOR ALL BOLTS EXCEPT WHERE NOTED ON THE PLANS

SIP PANELS:

- ROOF SIP SHALL COMPRISE OF ORIENTED STRANDED BOARD EXTERIOR 7/16" SKIN, POLYURETHANE CORE, AND PLYWOOD INTERIOR SKIN FOR A TOTAL WIDTH OF 8.25" MANUFACTURED BY ICS - ROCKY MOUNTAIN INC.
- WALLS SIP SHALL COMPRISE OF ORIENTED STRANDED BOARD EXTERIOR 7/16" SKIN, POLYURETHANE CORE, AND PLYWOOD INTERIOR SKIN FOR A TOTAL WIDTH OF 6.5" MANUFACTURED BY ICS - ROCKY MOUNTAIN INC.
- PRIOR TO JOINING THE PANELS, USE A BEAD OF EXPANDING FOAM ADHESIVE, RECOMMENDED BY MANUFACTURER.
- ALL PANELS SHOULD INCLUDE A 2X ON ALL EDGES.

3.25" ROOF SIP PANELS	2X8
6.5" WALL SIP PANELS	2X6

FLOOR FRAMING:

- WOOD SHALL BE DOUGLAS-FIR LARCH.
- SILL PLATE CONNECTING WALL TO FLOOR SHALL BE A 2X6.
- ALL BACK-TO-BACK PANELS SHALL BE CONNECTED BY 1-1/2" BOLT UNLESS OTHERWISE NOTED IN THE PLANS.

LEGEND:

A.R.	ANCHOR ROD
B.N.	BOUNDARY NAILING
B.O.F.	BOTTOM OF FOOTING
C.J.	CONTROL JOINT
CONST. JT.	CONSTRUCTION JOINT
DBL	DOUBLE
EA.	EACH
E.N.	EDGE NAILING
ELEV.	ELEVATION
F.F.	FINISHED FLOOR
F.N.	FIELD NAILING
F.V.	FIELD VERIFY
FRMG	FRAMING
GWB	GYPSUM WALL BOARD
J.B.	JOIST BEARING ELEVATION
HD	HOLDOWN
R.S.	ROUGH SAWN
T.B.	TRUSS BEARING
T.B. EL.	TRUSS BEARING ELEVATION
T.N.	TOE-NAIL
T.O.B.	TOP OF BEAM
T.O.F.	TOP OF FOOTING
T.O.P.	TOP OF PARAPET
T.O.W.	TOP OF WALL
TYP.	TYPICAL
SCHED.	SCHEDULE
SHTG	SHEATHING
SIM.	SIMILAR
SIP	STRUCTURAL INSULATED PANEL
S.W.	SHEARWALL
U.N.O.	UNLESS NOTED OTHERWISE
W.C.J.	WALL CONTROL JOINT



TEAM NAME: TEAM TEXAS

ADDRESS:
 The University of Texas at El Paso El Paso Community College
 College of Engineering Department of Architecture
 500 West University Avenue 919 Hunter Drive
 El Paso, Texas 79968 El Paso, Texas 79915

CONTACT: teamtexasSD13@utep.edu

CLIENT

U.S. DEPARTMENT OF ENERGY

SOLAR DECATHLON 2013

WWW.SOLARDECATHLON.GOV



01	10/11/2012	80% DOE/NR DD SUBMISSION
02	11/20/2012	80% DOE/NR RE-SUBMISSION
03	02/14/2013	95% DOE/NR CD SUBMISSION
04	04/05/2013	95% DOE/NR RE-SUBMISSION

MARK	DATE	DESCRIPTION
------	------	-------------

LOT NUMBER: 106

DRAWN BY: TEAM TEXAS

CHECKED BY:

COPYRIGHT:

SHEET TITLE


GENERAL
STRUCTURAL NOTES

S-001



TEAM NAME: TEAM TEXAS
 ADDRESS: ORANGE COUNTY GREAT PARK
 IRVINE, CALIFORNIA
 LOT #106
 CONTACT: ASMARSHALL@UTEP.EDU
 SOLARDECATHLON.UTEP.EDU

CONSULTANTS
 WRIGHT AND DALBIN ARCHITECTS
 HKN ENGINEERS - STRUCTURE
 EMC ENGINEERS - MPE
 EPCC - SCHOOL OF INTERIOR DESIGN
 EPCC - SCHOOL OF CULINARY ARTS

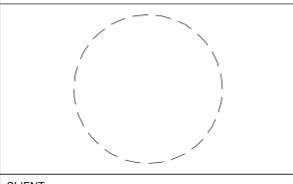

CLIENT
 U.S. DEPARTMENT OF ENERGY
 SOLAR DECATHLON 2013
 WWW.SOLARDECATHLON.GOV




01	10/11/2012	80% DOE-NR DD SUBMISSION
02	11/20/2012	80% DOE-NR DD RE-SUBMISSION
03	02/14/2013	95% DOE-NR CD SUBMISSION
03	04/05/2013	95% DOE-NR RE-SUBMISSION

MARK	DATE	DESCRIPTION
------	------	-------------

LOT NUMBER: #106
 DRAWN BY: TEAM TEXAS
 CHECKED BY: CONSULTANTS
 COPYRIGHT: NONE - PROJECT IS PUBLIC DOMAIN

SHEET TITLE
BUILDING SECTION

S-301

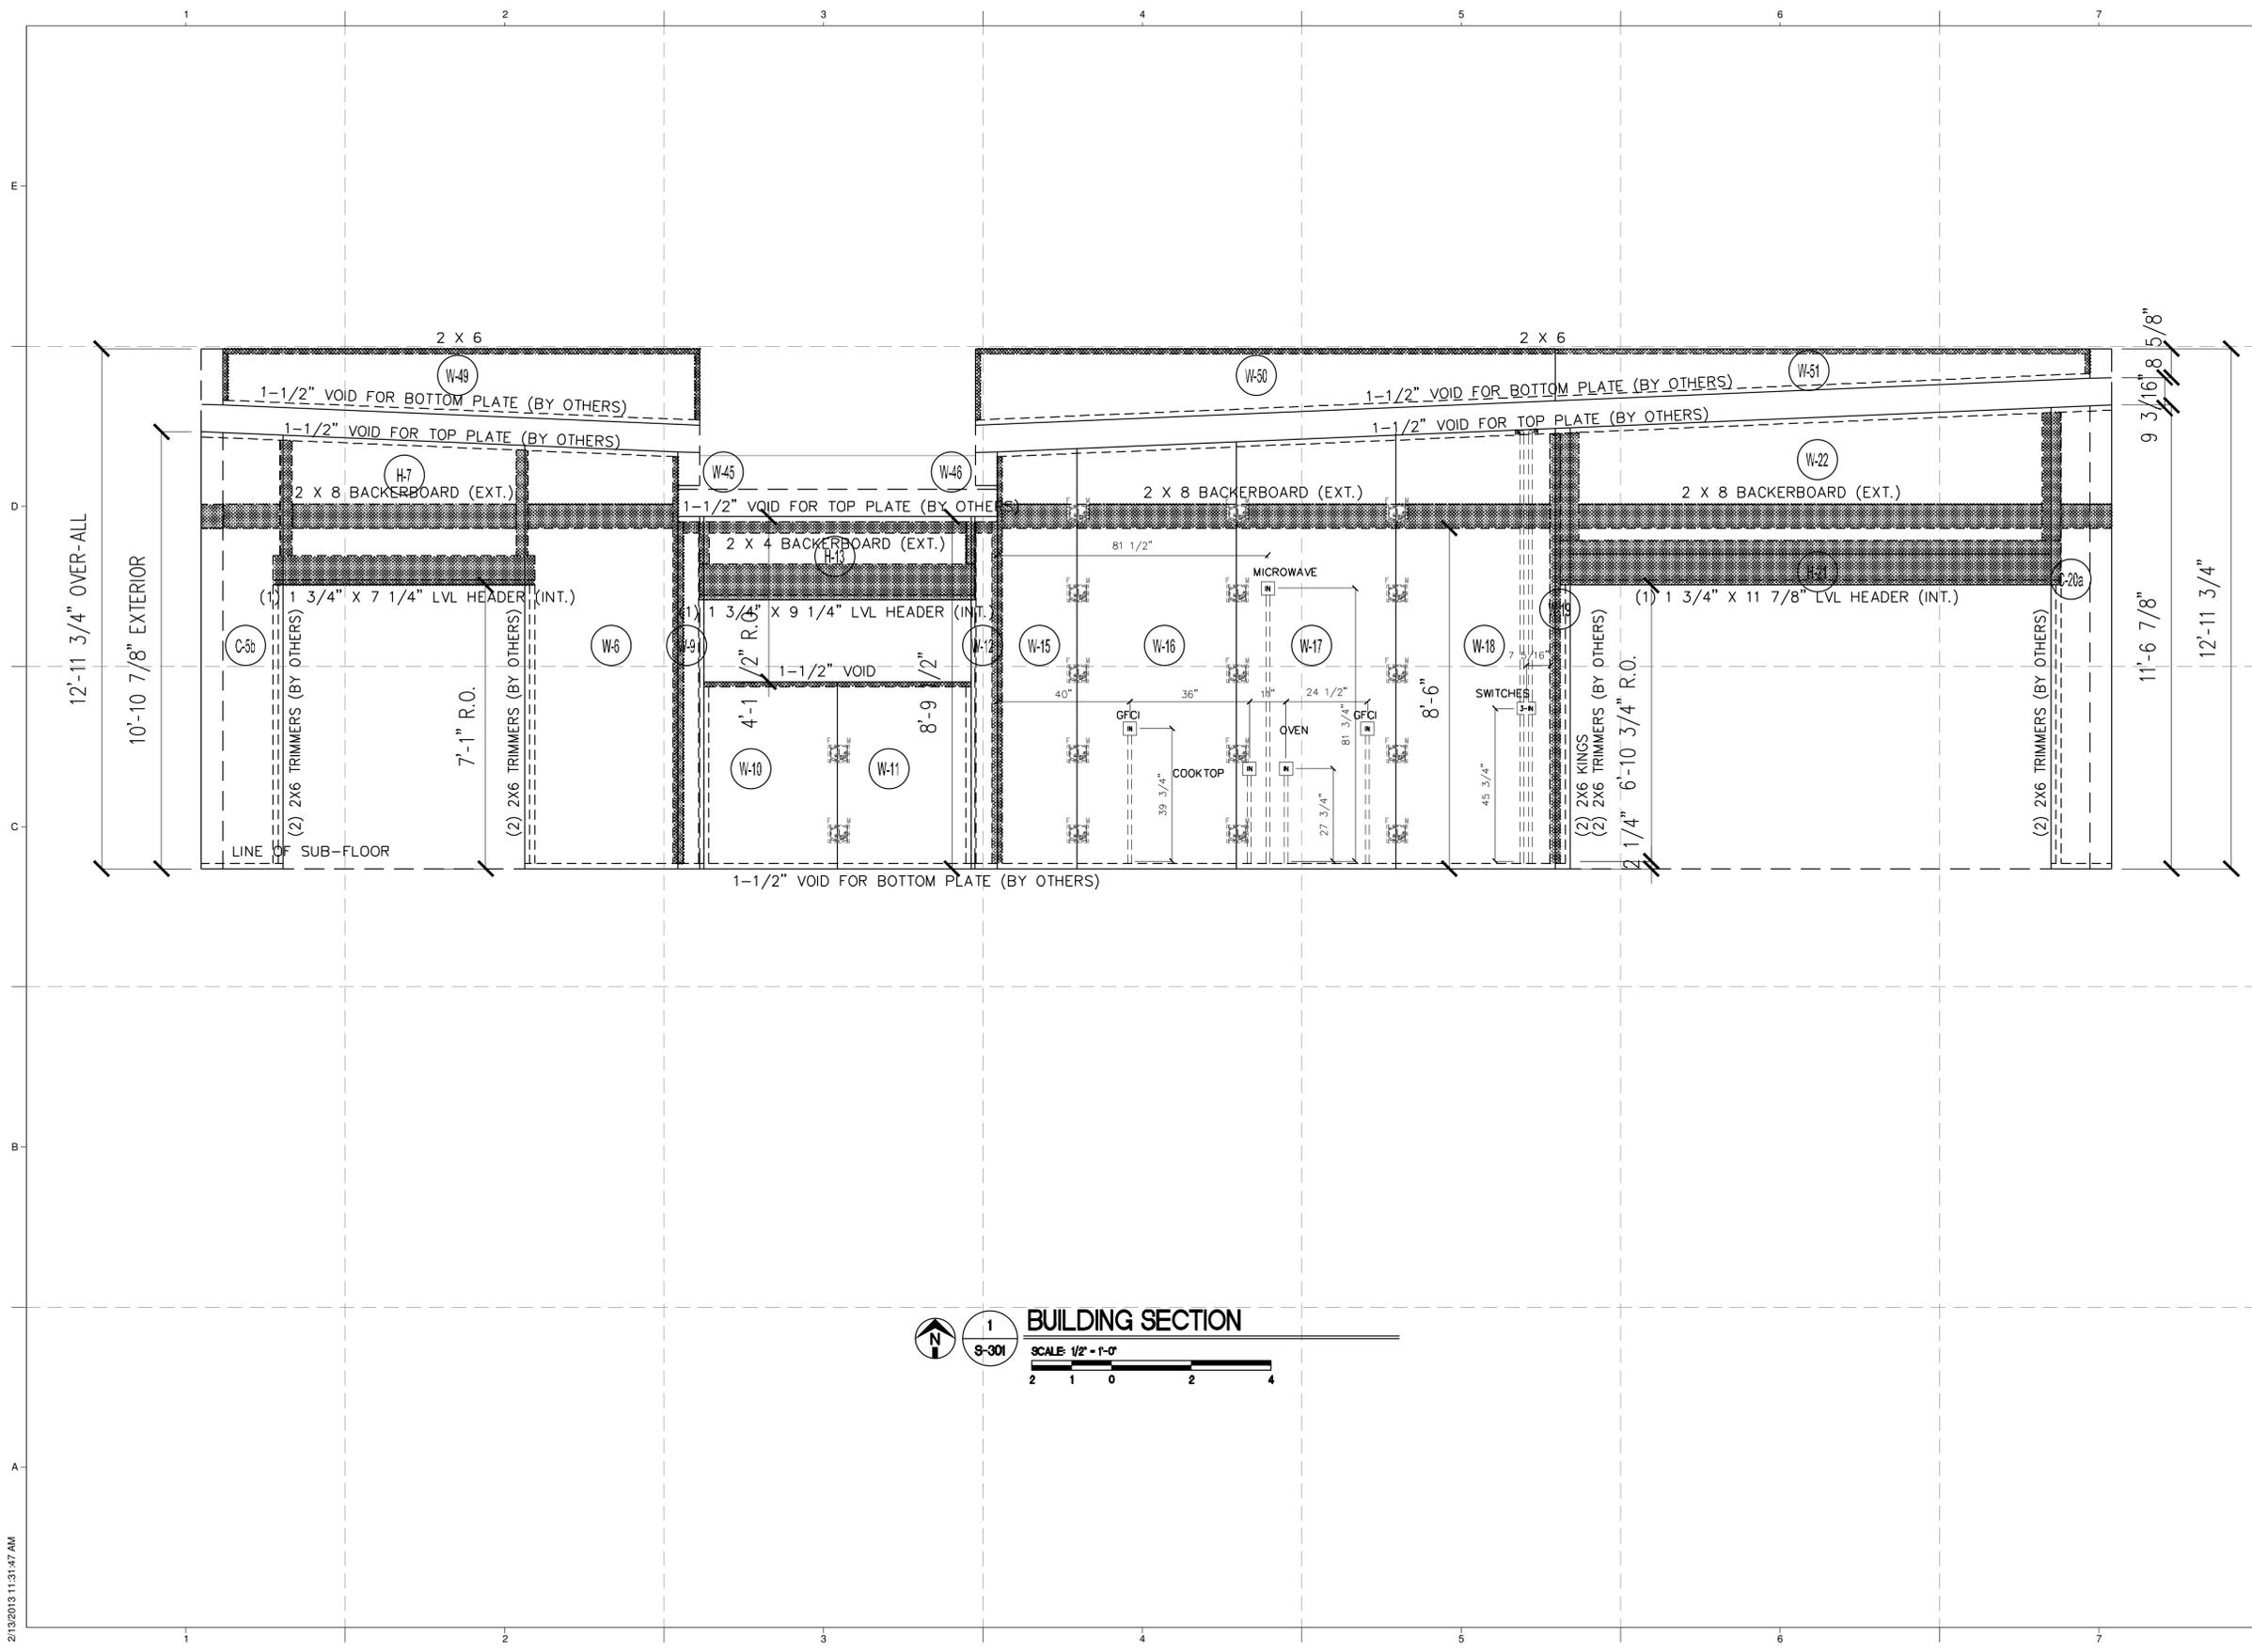


1 BUILDING SECTION
 S-301
 SCALE: 1/2" = 1'-0"
 2 1 0 2 4

2/13/2013 11:51:47 AM



TEAM NAME: TEAM TEXAS
 ADDRESS: The University of Texas at El Paso College of Engineering 500 West University Avenue El Paso, Texas 79968
 El Paso Community College Department of Architecture 919 Hunter Drive El Paso, Texas 79915
 CONTACT: teamtexasSD13@utep.edu

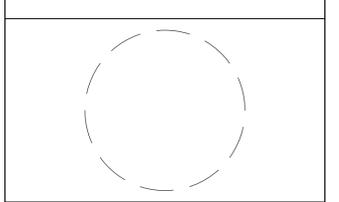

CLIENT
 U.S. DEPARTMENT OF ENERGY
 SOLAR DECATHLON 2013
 WWW.SOLARDECATHLON.GOV



01	10/11/2012	80% DOE/NR DD SUBMISSION
02	11/20/2012	80% DOE/NR RE-SUBMISSION
03	02/14/2013	95% DOE/NR CD SUBMISSION
04	04/05/2013	95% DOE/NR RE-SUBMISSION


MARK	DATE	DESCRIPTION
------	------	-------------

LOT NUMBER: 106
 DRAWN BY: TEAM TEXAS
 CHECKED BY:
 COPYRIGHT: NONE: PROJECT IS PUBLIC DOMAIN

SHEET TITLE

DECK DETAILS

S-521

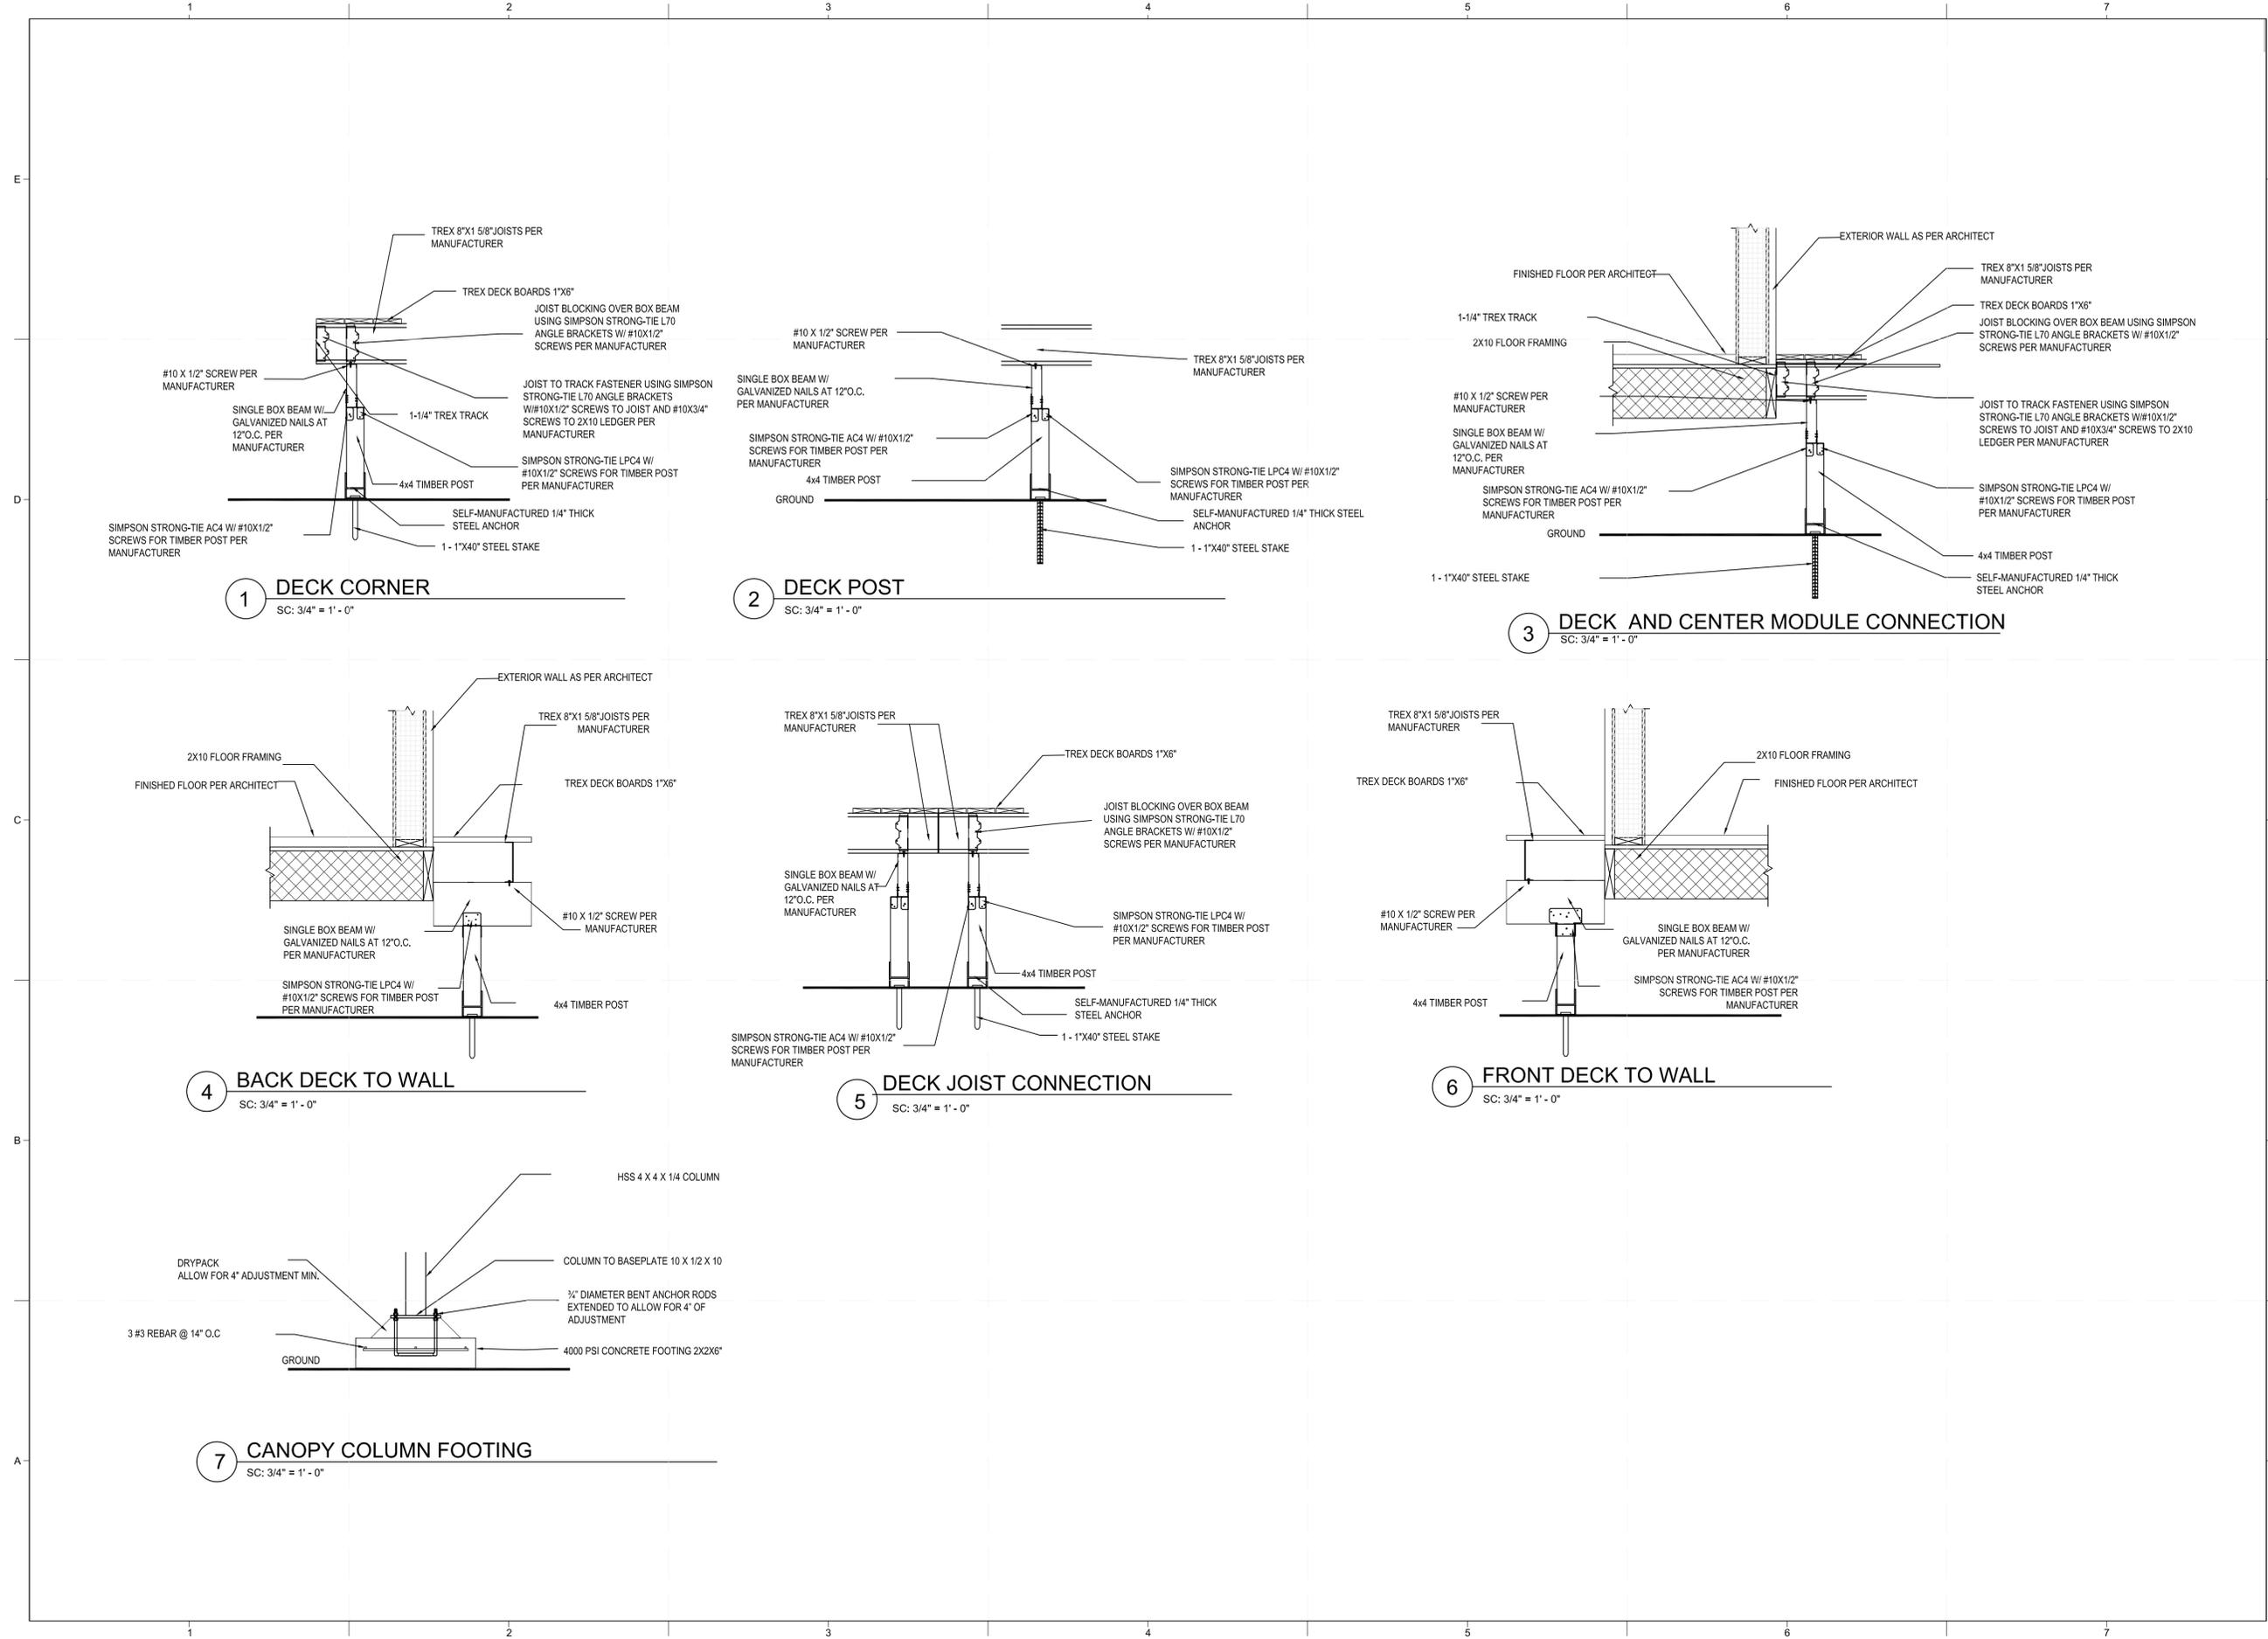


REFERENCE KEYNOTES


A LABEL	CLASS A DOOR	DEG	DEGREE	HDR	HEADER	PSI	POUNDS PER SQUARE INCH	TOJ	TOP OF JOIST
A/C UNIT	AIR CONDITIONING UNIT	DEMO	DEMOLITION, DEMONSTRATION	HDW	HARDWARE	PT	PAINT, PRESSURE TREATED	TOM	TOP OF MASONRY
AE	ARCHITECT/ENGINEER	DEPT	DEPARTMENT	HH	HAND HOLE	PTD	PAINTED, PAPER TOWEL DISPENSER	TOP	TOP OF PARAPET (PAVEMENT)
AAP	ALARM ANNUNCIATOR PANEL	DET	DETAIL	HM	HOLLOW METAL	PTDR	PAPER TOWEL DISPENSER / RECEPTACLE	TOPO	TOPOGRAPHY
AB	ANCHOR BOLT	DF	DRINKING FOUNTAIN	HORIZ	HORIZONTAL	HS	HAND SINK	TOW	TOP OF WALL
ABC	AGGREGATE BASE COURSE	DIA	DIAMETER	HT	HEIGHT	PTN	PARTITION	TPD	TOILET PAPER DISPENSER
ABV	ABOVE	DIAG	DIAGONAL, DIAGRAM	HVAC	HEATING, VENTILATING, AND AIR CONDITIONING	PTR	PAPER TOWEL RECEPTACLE	TPH	TOILET PAPER HOLDER
AC	ASBESTOS CEMENT, ASPHALTIC CONCRETE	DIM	DIMENSION			PVG	PAVEMENT, PAVING	TR	TOWEL RACK
ACC	ACCESS, ACCESSIBLE	DISP	DISPENSER			QT	QUARRY TILE	TRANS	TRANSOM, TRANSPARENT
ACP	ASPHALTIC CONCRETE PAVING, AUTOMATIC CONTROL PANEL	DIST	DISTANCE, DISTRICT	I	MOMENT OF INERTIA	OTB	QUARRY TILE BASE	TS	TUBE STEEL
ACST	ACOUSTICAL, ACOUSTIC	DJ	DOUBLE JOIST	I/O	INPUT / OUTPUT	OTF	QUARRY TILE FLOOR	TSH	TOWEL SHELF
ACT	ACOUSTICAL CEILING TILE	DL	DEAD LOAD	ID	INSIDE DIAMETER, IDENTIFICATION, INSIDE DIMENSION	QTY	QUANTITY	TSTAT	THERMOSTAT
AD	AREA DRAIN	DMPF	DAMP-PROOFING	IC	INCLUDE, INCLUDED, INCLUDING	R	RISER, RADIUS, RANGE	TV	TELEVISION
ADDL	ADDITIONAL	DMPR	DAMP-PROOFING	INCL	INCLUDE, INCLUDED, INCLUDING	RB	ROBE HOOK	TYP	TYPICAL
ADDM	ADDENDUM	DN	DOWN	INFO	INFORMATION	RB HK	ROBE HOOK	UC	UNDERCUT
ADH	ADHESIVE	DR	DOOR, DRIVE, DINING ROOM, DRESSING ROOM	INSUL	INSULATE, INSULATION, INSULATING, INSULATED	RCP	REFLECTED CEILING PLAN	UGND	UNDERGROUND
ADJ	ADJACENT, ADJOINING, ADJUSTABLE	DW	DOWNSPOUT	INT	INTERIOR	RCPTN	RECEPTION	UH	UNIT HEATER
ADJUST	ADJUSTABLE	DWG(S)	DRAWING(S)	INTERCOM	INTERCOMMUNICATIONS	RD	ROOF DRAIN, ROAD	UNFIN	UNFINISHED
AF	ABOVE FINISHED FLOOR	E	EAST, MODULUS OF ELASTICITY	INVERT	INVERT	REBAR	REINFORCING STEEL BARS	UNIV	UNIVERSAL
AFG	ABOVE FINISHED GRADE	E LABEL	CLASS E DOOR	JAN	JANITOR	REF	REFERENCE, REFRIGERATOR	UNO	UNLESS NOTED OTHERWISE
AGGR	AGGREGATE	EA	EACH	JAN CLO	JANITOR'S CLOSET	REFL	REFLECT, REFLECTED, REFLECTIVE, REFLECTOR	UPS	UNINTERRUPTIBLE POWER SUPPLY
AHU	AIR HANDLING UNIT	EB	EXPANSION BOLT	JBOX	JUNCTION BOX	REFR	REFRIGERATION	UR	URINAL
ALT	ALTERNATE, ALTITUDE	ECU	EVAPORATIVE COOLING UNIT			REG	REGISTER	UTIL	UTILITY
ALUM	ALUMINUM	EE	EACH END	K	KILO, THOUSAND	REIN	REINFORCE, REINFORCING	VAC	VACUUM
ANCD	ANODIZE	EE	EACH FACE, EXTERIOR FINISH	KIT	KITCHEN	REIN	REINFORCE, REINFORCING	VAN	VANITY
ANT	ANTENNA	EF	EXTERIOR FINISH SYSTEM	KNOCK	KNOCK OUT	REOD	REQUIRED	VAP PRF	VAPOR PROOF
AP	ACCESS PANEL	EFS	EXTERIOR FINISH SYSTEM	KPL	KICK PLATE	RESIL	RESILIENT	VAR	VARIABLE
APPROX	APPROXIMATE	EG	EDGE GRAIN			REST	RESTROOM	VB	VINYL BASE, VALVE BOX
ARCH	ARCHITECT	EGB	EXTERIOR GYPSUM BOARD	L	ANGLE, LITER	REV	REVISION	VCT	VINYL COMPOSITION TILE
ASC	ABOVE SUSPENDED CEILING	EGSB	EXTERIOR GYPSUM SHEATHING BOARD	LAB	LABORATORY	RFG	ROOFING	VEH	VEHICLE
ASPH	ASPHALT	EH	ELECTRIC HEATER	LAD	LADDER	RH	ROOF HATCH, RIGHT HAND	VENT	VENTILATION, VENTILATOR
ASSY	ASSEMBLY	EHD	ELECTRIC HAND DRYER	LAM	LAMINATE, LAMINATED	RHR	RIGHT HAND REVERSE	VERT	VERTICAL
ATM	AUTOMATIC TELLER MACHINE	EIFS	EXTERIOR INSULATION AND FINISH SYSTEM	LAM GL	LAMINATED GLASS	RL	ROOF LEADER	VEST	VESTIBULE
AUTO	AUTOMATIC	EJ	EXPANSION JOINT	LDR	LEADER	RM	ROOM	VG	VERTICAL GRAIN
AV	AUDIO VISUAL	EL	ELEVATION, EACH LAYER	LH	LEFT HAND	RO	ROUGH OPENING	VID	VIDEO
AVE	AVENUE	ELEC	ELECTRIC	LHR	LEFT HAND REVERSE	ROW	RIGHT OF WAY	VJ	V JOINT
		ELEV	ELEVATOR	LIB	LIBRARY	RS	ROUGH SAWN	VNR	VENEER
		EMER	EMERGENCY	LL	LIVE LOAD	RT	RIGHT	VOL	VOLUME
		EMS	ENERGY MANAGEMENT SYSTEM	LNG	LIQUID NATURAL GAS	RTF	RUBBER TILE FLOOR	VOLT	VOLTAGE
		ENCL	ENCLOSE, ENCLOSURE	LPT	LOW POINT	RTU	ROOF TOP UNIT	VR	VAPOR RETARDER
		ENGR	ENGINEER	LR	LIVING ROOM	RV	ROOF VENT, ROOF VENTILATOR	VRFY	VERIFY
		ENTR	ENTRANCE	LT	LIGHT			VTR	VENT THROUGH ROOF
		EPDM	ETHYLENE PROPYLENE DIENE MONOMER	LVR	LOUVER	LT	LIGHT	WVC	VINYL WALL COVERING
		EPS	EXPANDED POLYSTYRENE BOARD (INSULATION)	LWC	LIGHT WEIGHT CONCRETE	S	SOUTH	WVF	VINYL WALL FABRIC
		EQ	EQUAL	M	METER, MOMENT	SB	SPLASH BLOCK	W	WASTE, WEST, WIDE
		EQT	EQUIPMENT	MACH RM	MACHINE ROOM	SBS	STYRENE BUTADIENE STYRENE (ROOFING)	W/	WITHOUT
		EQUIP	EQUIPMENT	MAINT	MAINTENANCE	SC	SOLID CORE	W/O	WITHOUT
		ERD	EXISTING ROOF DRAIN	MATL	MATERIAL	SCHED	SCHEDULE	W/W	WALL TO WALL
		EST	ESTIMATED	MAX	MAXIMUM	SCHM	SCHEMATIC	WB	WOOD BASE
		EVAP	EVAPORATE	MB	MACHINE BOLT, MAIL BOX	SCP	SCUPPER	WBL	WOOD BLOCKING
		EW	EACH WAY	MBR	MASTER BEDROOM, MEMBER	SCR	SHOWER CURTAIN ROD	WC	WALL COVERING, WATER CLOSET
		EWG	ELECTRIC WATER COOLER	MC	MEDICINE CABINET	SCRN	SCREEN	WCO	WOOD CLEANOUT
		EWH	ELECTRIC WATER HEATER	MECH RM	MECHANICAL ROOM	SCWD	SOLID CORE WOOD DOOR	WD	WOOD, WOOD DOOR
		EWS	EYE WASH STATION	MEM	MEMBRANE	SECT	SECTION	WDW	WINDOW
		EXC	EXCAVATE	MEZ	MEZZANINE	SF	SQUARE FOOT (FEET), SUPPLY FAN	WF	WASH FOUNTAIN
		EXIST	EXISTING	MFR	MANUFACTURER	SH	SHINGLES, SINGLE HUNG (WINDOW)	WFAB	WALL FABRIC
		EXP	EXPOSED, EXPANSION, EXPAND	MH	MANHOLE	SHFT	SHAFT (ELEVATOR)	WGL	WIRED GLASS
		EXS	EXTRA STRONG	MIN	MINIMUM, MINUTE	SHLV	SHELVES, SHELVING	WH	WALL HUNG, WALL HYDRANT, WATER HEATER
		EXT	EXTERIOR, EXTERNAL, EXTINGUISHER	MIR	MIRROR	SHR	SHOWER	WHSE	WAREHOUSE
				MISC	MISCELLANEOUS	SHR HD	SHOWER HEAD	WI	WROUGHT IRON
				ML	METAL LATH, MONOLITHIC	SHT	SHEET	WLD	WELDED
				MLDG	MOULDING, MOLDING	SHT MTL	SHEET METAL FLASHING	WM	WATER METER, WIRE MESH
				MLWK	MILLWORK	FLASH	FLASH	WP	WATERPROOFING, WEATHERPROOFING
				MO	MASONRY OPENING	SHTHG	SHEATHING	WP	WATER REPELLENT, WEATHER RESISTANT, WIRE ROPE
				MOD	MODULUS, MODEL, MODIFY, MODULE	SH	SHEET	WR	WATER REPELLENT, WEATHER RESISTANT, WIRE ROPE
				MRB	MARBLE BASE	SIM COND	SIMILAR CONDITION	WSC	WAINSCOT
				MS	MOP SINK	SKLT	SKYLIGHT	WSL	WEATHER SEAL
				MT	MOUNT, MOUNTED, MOUNTING, METAL THRESHOLD	SLD WDW	HORIZONTAL SLIDING WINDOW	WT	WATER TIGHT, WEIGHT
				MTL	METAL	SND	SANITARY NAPKIN DISPENSER	WU	WINDOW UNIT
				MULL	MULLION	SNDU	SANITARY NAPKIN DISPOSAL UNIT	WWF	WELDED WIRE FABRIC
				MVBL	MOVABLE	STAND	STANDARD	WWM	WELDED WIRE MESH
				N	NORTH	SPEC(S)	SPECIFICATION(S)	X BRACE	CROSS BRACE
				NA	NOT APPLICABLE	SPKLR	SPRINKLER	X SECT	CROSS SECTION
				NAT	NATURAL	SQ	SQUARE	XBRA	CROSSBRACING
				NOT IN CONTRACT		SO IN	SQUARE INCH	XFER	TRANSFER
				NO	NUMBER	SO YD	SQUARE YARD	XFMR	TRANSFORMER
				NOM	NOMINAL	SS	SERVICE SINK	XL	EXTRA LARGE
				NR	NOISE REDUCTION	STA	STATION	XPS	EXTRUDED POLYSTYRENE BOARD (INSULATION)
				NRC	NOISE REDUCTION COEFFICIENT	STC	SOUND TRANSMISSION CLASS		
				NTS	NOT TO SCALE	STD	STANDARD		
				OA	OVERALL	STOR	STORAGE	YCO	YARD CLEANOUT
				OC	ON CENTER	STR	STAIR(S)	YD	YARD, YARD DRAIN
				OD	OUTSIDE DIAMETER, OUTSIDE DIMENSION	STRUCT	STRUCTURE, STRUCTURAL	YH	YARD HYDRANT
				OF/CI	OWNER FURNISHED / CONTRACTOR INSTALLED	SUH	SUSPENDED UNIT HEATER	YI	YARD INLET
				OF/OI	OWNER FURNISHED / OWNER INSTALLED	SV	SHEET VINYL	YR	YEAR
				OFD	OVERFLOW DRAIN	SWBD	SWITCHBOARD	Z	MODULUS OF SECTION
				OFF	OFFICE	SYM	SYMBOL		
				OH	OPPOSITE HAND, OVERHANG, OVERHEAD	SYS	SYSTEM		
				OPNG	OPENING	T	TREAD		
				OPP	OPPOSITE	T&B	TOP AND BOTTOM		
				OSB	ORIENTED STRAND BOARD	T&G	TONGUE AND GROOVE		
				PA	PUBLIC ADDRESS	T/S	TUB / SHOWER		
				PAR	PARALLEL	TB	TOWEL BAR, THROUGH BOLT		
				PB	PANIC BAR, PANELBOARD, PAINTED BASE, PULL BOX, PUSHBUTTON	TC	TERRA COTTA		
				PBD	PARTICLE BOARD	TCA	TELEPHONE CONTROL PANEL		
				PCB	PAPER CUP DISPENSER	TD	TOWEL DISPENSER, TRENCH DRAIN		
				PCF	POUNDS PER CUBIC FOOT	TDR	TOWEL DISPENSER / RECEPTACLE		
				PEO	PEDESTAL	TEL	TELEPHONE		
				PERF	PERFORATE(D)	TEMP	TEMPERATURE, TEMPORARY		
				PERFAB	PREFABRICATE(D)	TER	TELEPHONE EQUIPMENT ROOM		
				PERIM	PERIMETER	TFA	TO FLOOR ABOVE		
				PFE	PORTABLE FIRE EXTINGUISHER	TFB	TO FLOOR BELOW		
				PG	PRESSURE GAUGE	THD	THREAD		
				PLAM	PLASTIC LAMINATE	THK	THICKNESS, THICK		
				PLYWD	PLYWOOD	THRES	THRESHOLD		
				PNL	PANEL	THRU	THROUGH		
				PR	PAIR, PIPE RAIL	THRUOUT	THROUGHOUT		
				PREFIN	PREFINISHED	TK BD	TACK BOARD		
				PRKG	PARKING	TMPD GL	TEMPERED GLASS		
				PSF	POUNDS PER SQUARE FOOT	TN	TRUE NORTH		
						TOB	TOP OF BEAM		
						TOC	TOP OF CONCRETE (CURB)		
						TOC FTG	TOP OF CONCRETE FOOTING		
						TOC WALL	TOP OF CONCRETE WALL		
						TOF	TOP OF FOOTING (FLOOR, FRAME)		

WALL LEGEND


A CORRUGATED METAL PANEL EXTERIOR WALLS

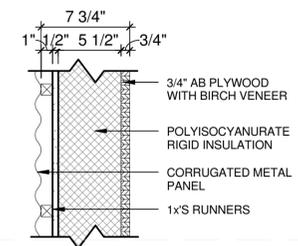


B CORTEN METAL PANEL EXTERIOR WALLS

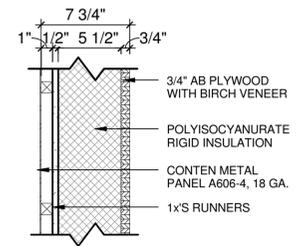


C CORTEN METAL PANEL EXTERIOR WALLS

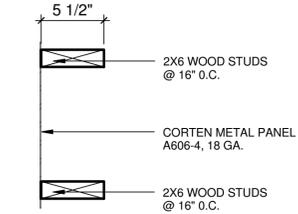

D WOOD STUD INTERIOR WALLS

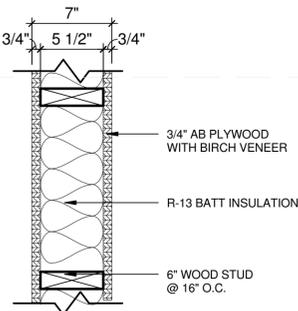

E WOOD STUD INTERIOR WALLS

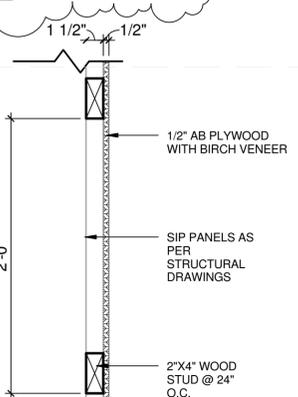

TEAM NAME: TEAM TEXAS

ADDRESS: ORANGE COUNTY GREAT PARK
IRVINE, CALIFORNIA
LOT #106

CONTACT: ASMARSHALL@UTEP.EDU
SOLARDECATHLON.UTEP.EDU

CONSULTANTS

CLIENT
U.S. DEPARTMENT OF ENERGY
SOLAR DECATHLON 2013
WWW.SOLARDECATHLON.GOV



01	10/11/2012	80% DOE/RE SUBMISSION
02	11/20/2012	80% DOE/RE SUBMISSION
03	02/14/2013	95% DOE/RE SUBMISSION
03	04/05/2013	95% DOE/RE SUBMISSION
04	08/22/2013	AS BUILTS

1	Date 1	Revision 1
MARK	DATE	DESCRIPTION

LOT NUMBER: #106

DRAWN BY: TEAM TEXAS

CHECKED BY:

COPYRIGHT: NONE; PROJECT IS PUBLIC DOMAIN

SHEET TITLE

ARCHITECTURAL
SYMBOLS AND NOTES

A-001

TEAM NAME: TEAM TEXAS
 ADDRESS: ORANGE COUNTY GREAT PARK
 IRVINE, CALIFORNIA
 LOT #106
 CONTACT: ASMARSHALL@UTEP.EDU
 SOLARDECATHLON.UTEP.EDU

CONSULTANTS



CLIENT
 U.S. DEPARTMENT OF ENERGY
 SOLAR DECATHLON 2013
 WWW.SOLARDECATHLON.GOV




01	10/11/2012	80% DCENR DD SUBMISSION
02	11/20/2012	80% DCENR DD RE-SUBMISSION
03	02/14/2013	95% DCENR CD SUBMISSION
03	04/05/2013	95% DCENR RE-SUBMISSION

MARK	DATE	DESCRIPTION
------	------	-------------


LOT NUMBER: #106
 DRAWN BY: TEAM TEXAS
 CHECKED BY:
 COPYRIGHT: NONE: PROJECT IS PUBLIC DOMAIN

SHEET TITLE
ARCHITECTURAL SITE PLAN


A-101

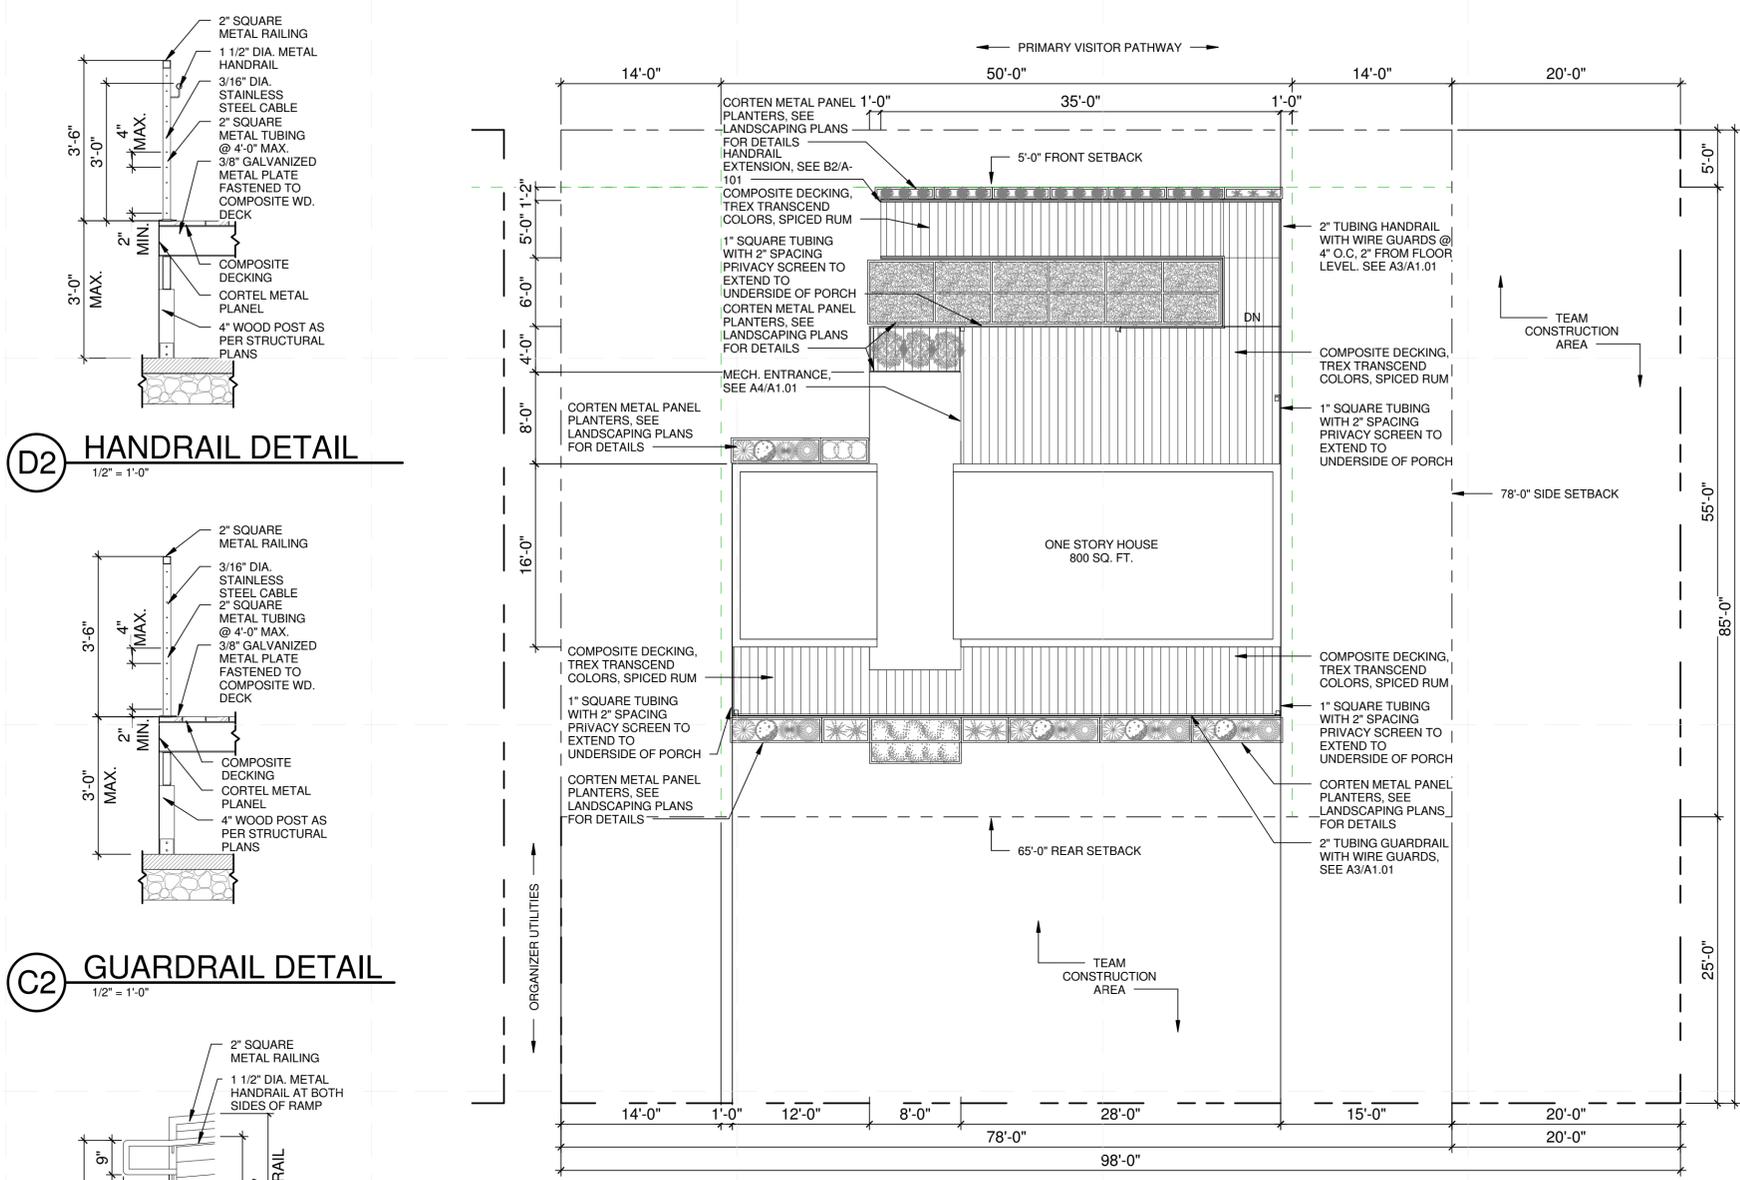

D2 HANDRAIL DETAIL
 1/2" = 1'-0"

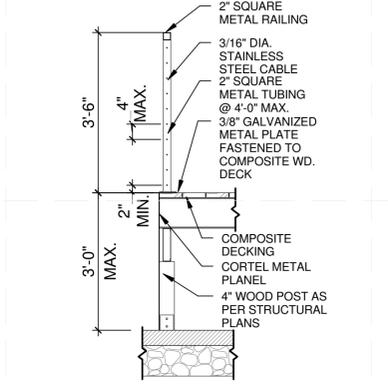


C2 GUARDRAIL DETAIL
 1/2" = 1'-0"

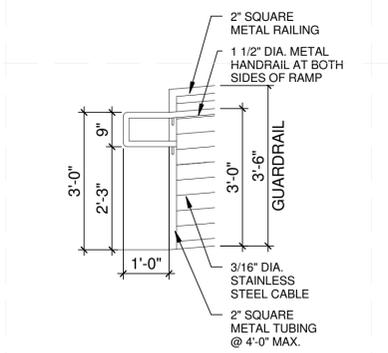

B2 DETAIL EXTENSION
 1/2" = 1'-0"



B3 SITE PLAN
 1/8" = 1'-0"

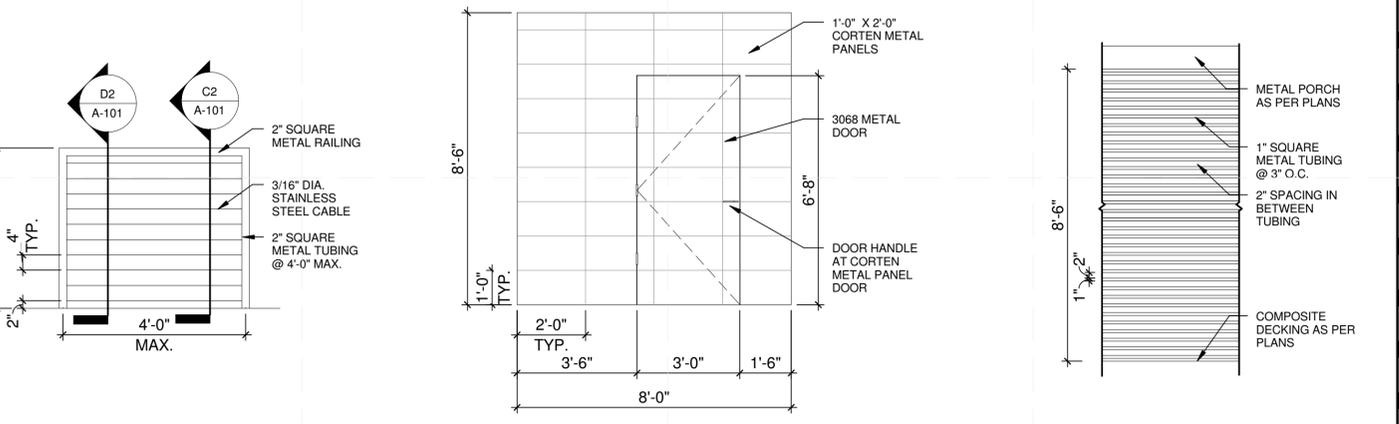

A3 TYP. RAILING ELEV.
 1/2" = 1'-0"

A4 PATIO / MECH. ROOM ELEV.
 3/8" = 1'-0"

A5 PRIVACY SCREEN
 3/8" = 1'-0"



TEAM NAME: TEAM TEXAS
 ADDRESS: ORANGE COUNTY GREAT PARK
 IRVINE, CALIFORNIA
 LOT #106
 CONTACT: ASMARSHALL@UTEP.EDU
 SOLARDECATHLON.UTEP.EDU

CONSULTANTS

CLIENT
 U.S. DEPARTMENT OF ENERGY
 SOLAR DECATHLON 2013
 WWW.SOLARDECATHLON.GOV




01	10/11/2012	80% DOE/NR DD SUBMISSION
02	11/20/2012	80% DOE/NR DD RE-SUBMISSION
03	02/14/2013	95% DOE/NR CD SUBMISSION
03	04/05/2013	95% DOE/NR RE-SUBMISSION
04	08/22/2013	AS BUILTS

MARK	DATE	Revision 1	DESCRIPTION


LOT NUMBER: #106
 DRAWN BY: TEAM TEXAS
 CHECKED BY:
 COPYRIGHT: NONE; PROJECT IS PUBLIC DOMAIN

SHEET TITLE
FIRST FLOOR PLAN


A-111

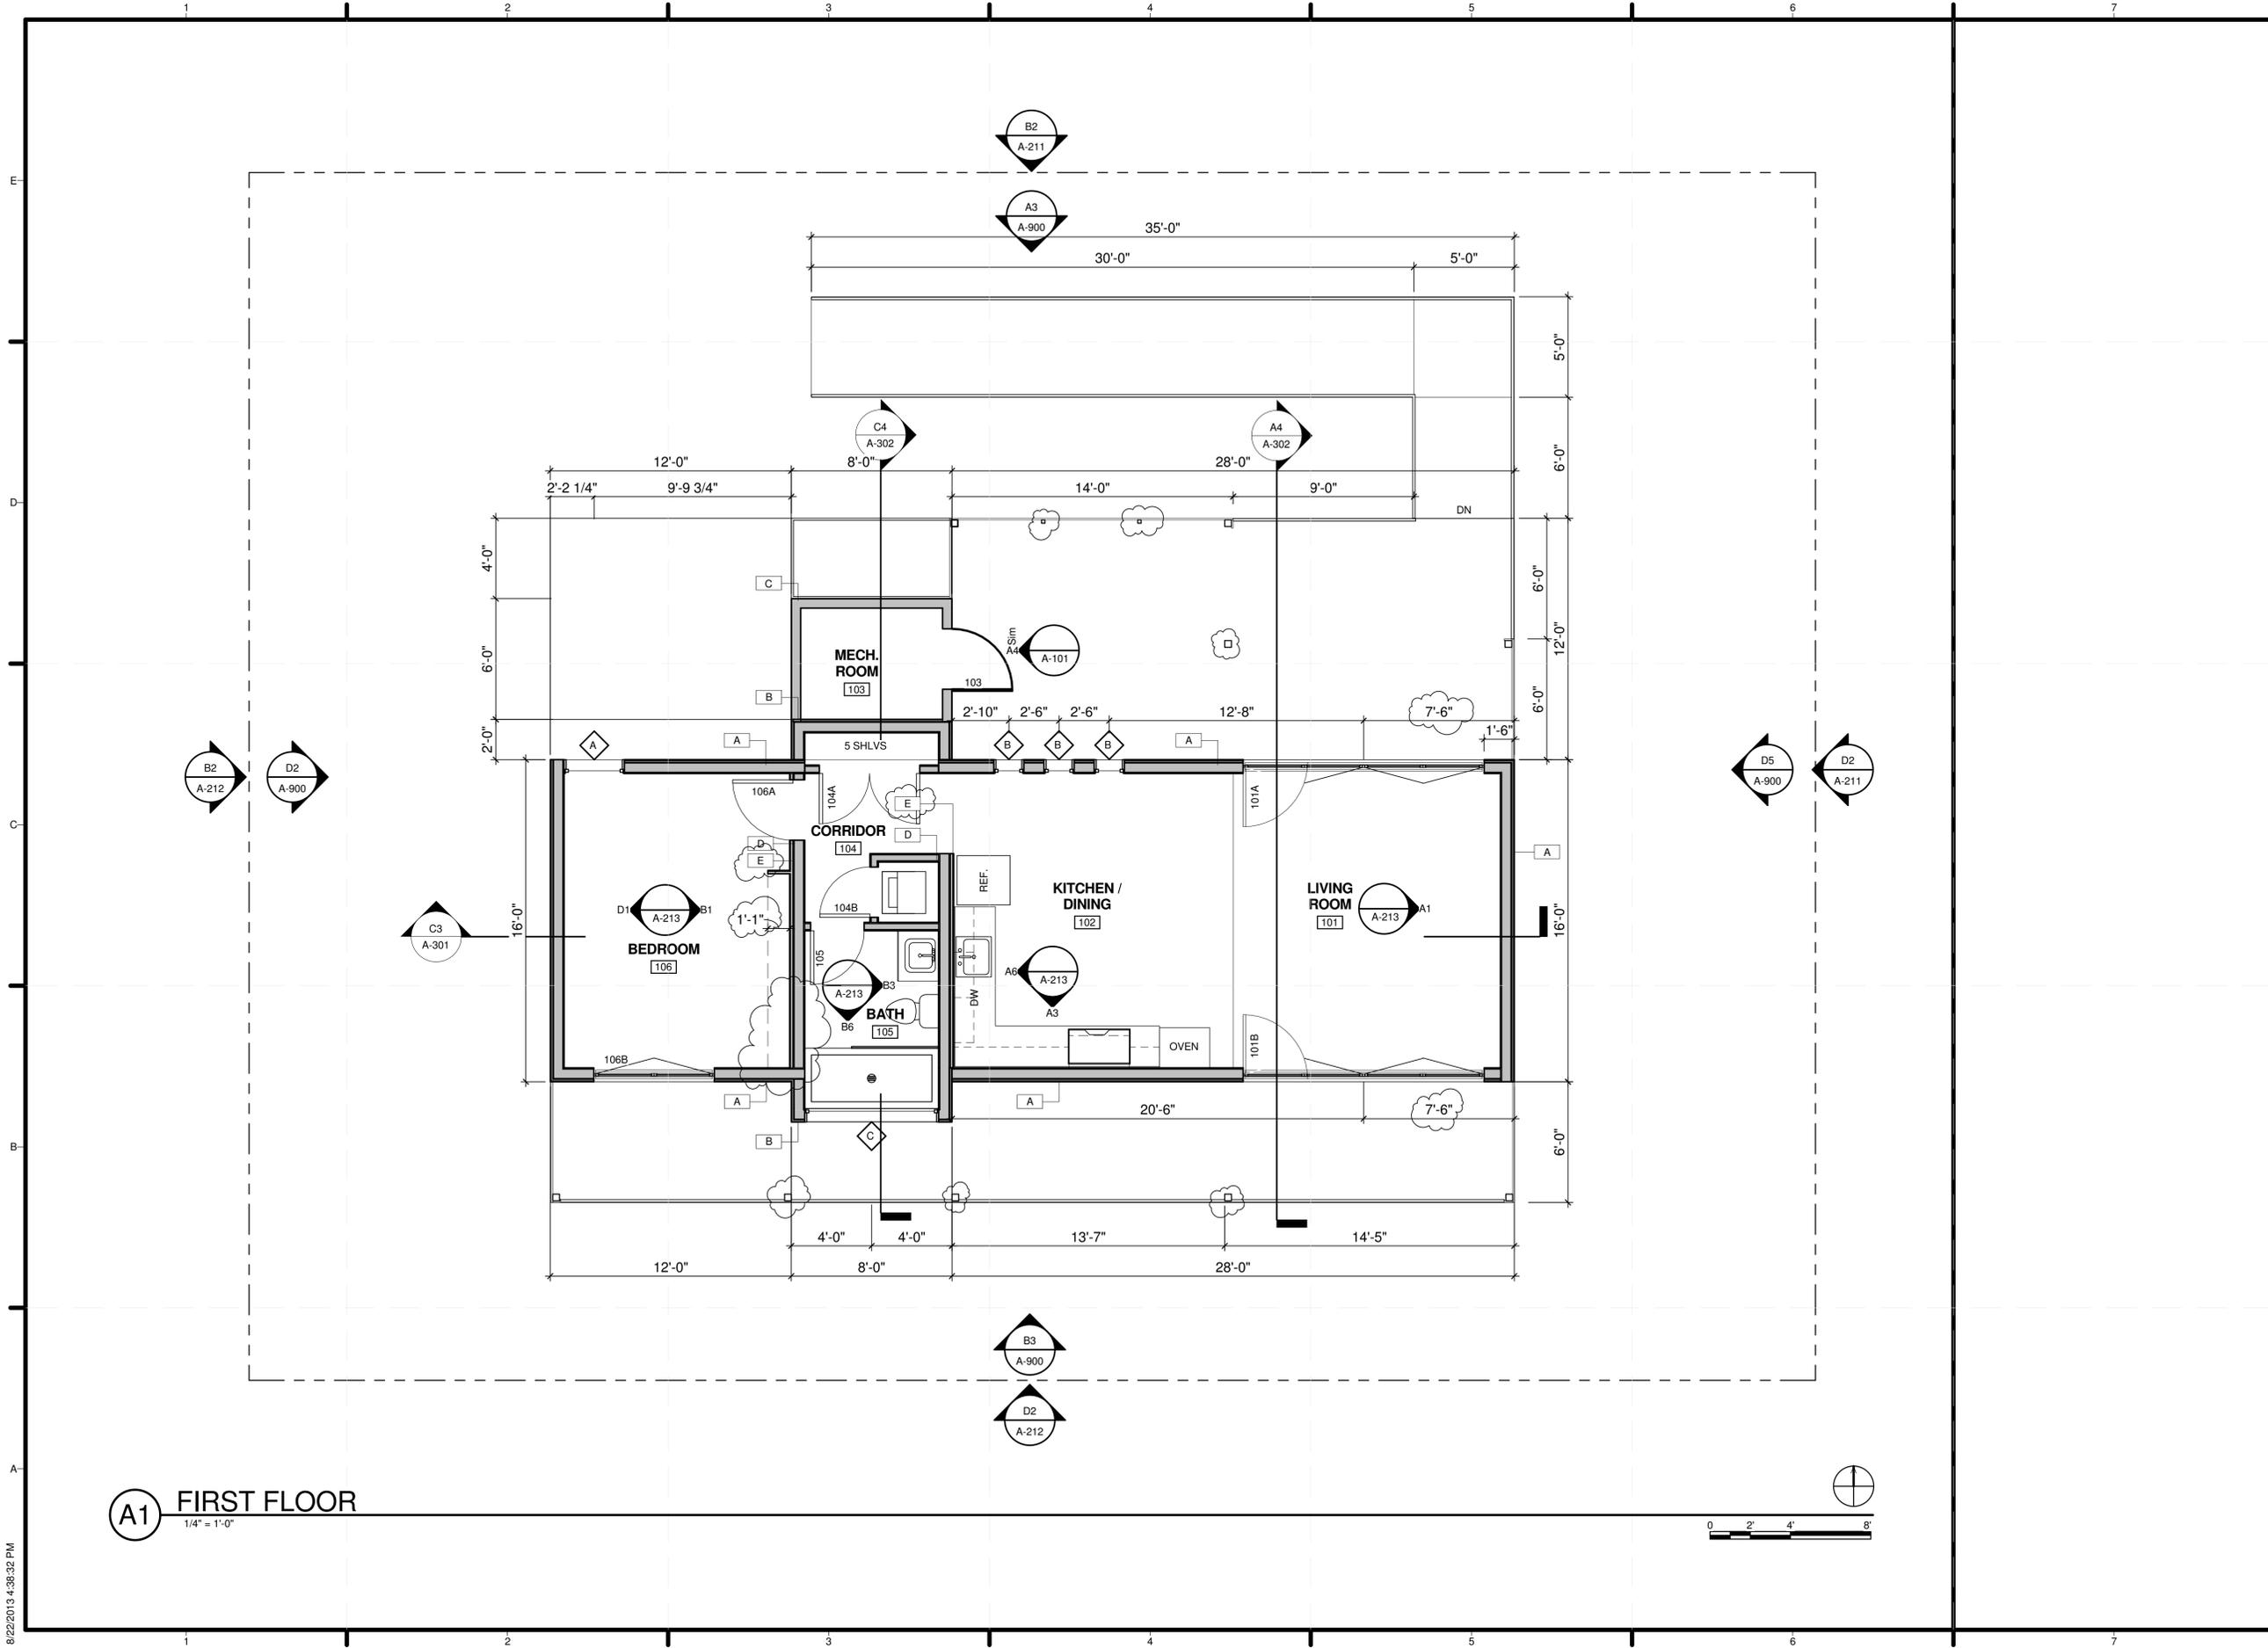


(A1) FIRST FLOOR
 1/4" = 1'-0"

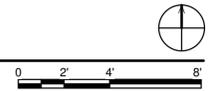


8/22/2013 4:38:32 PM

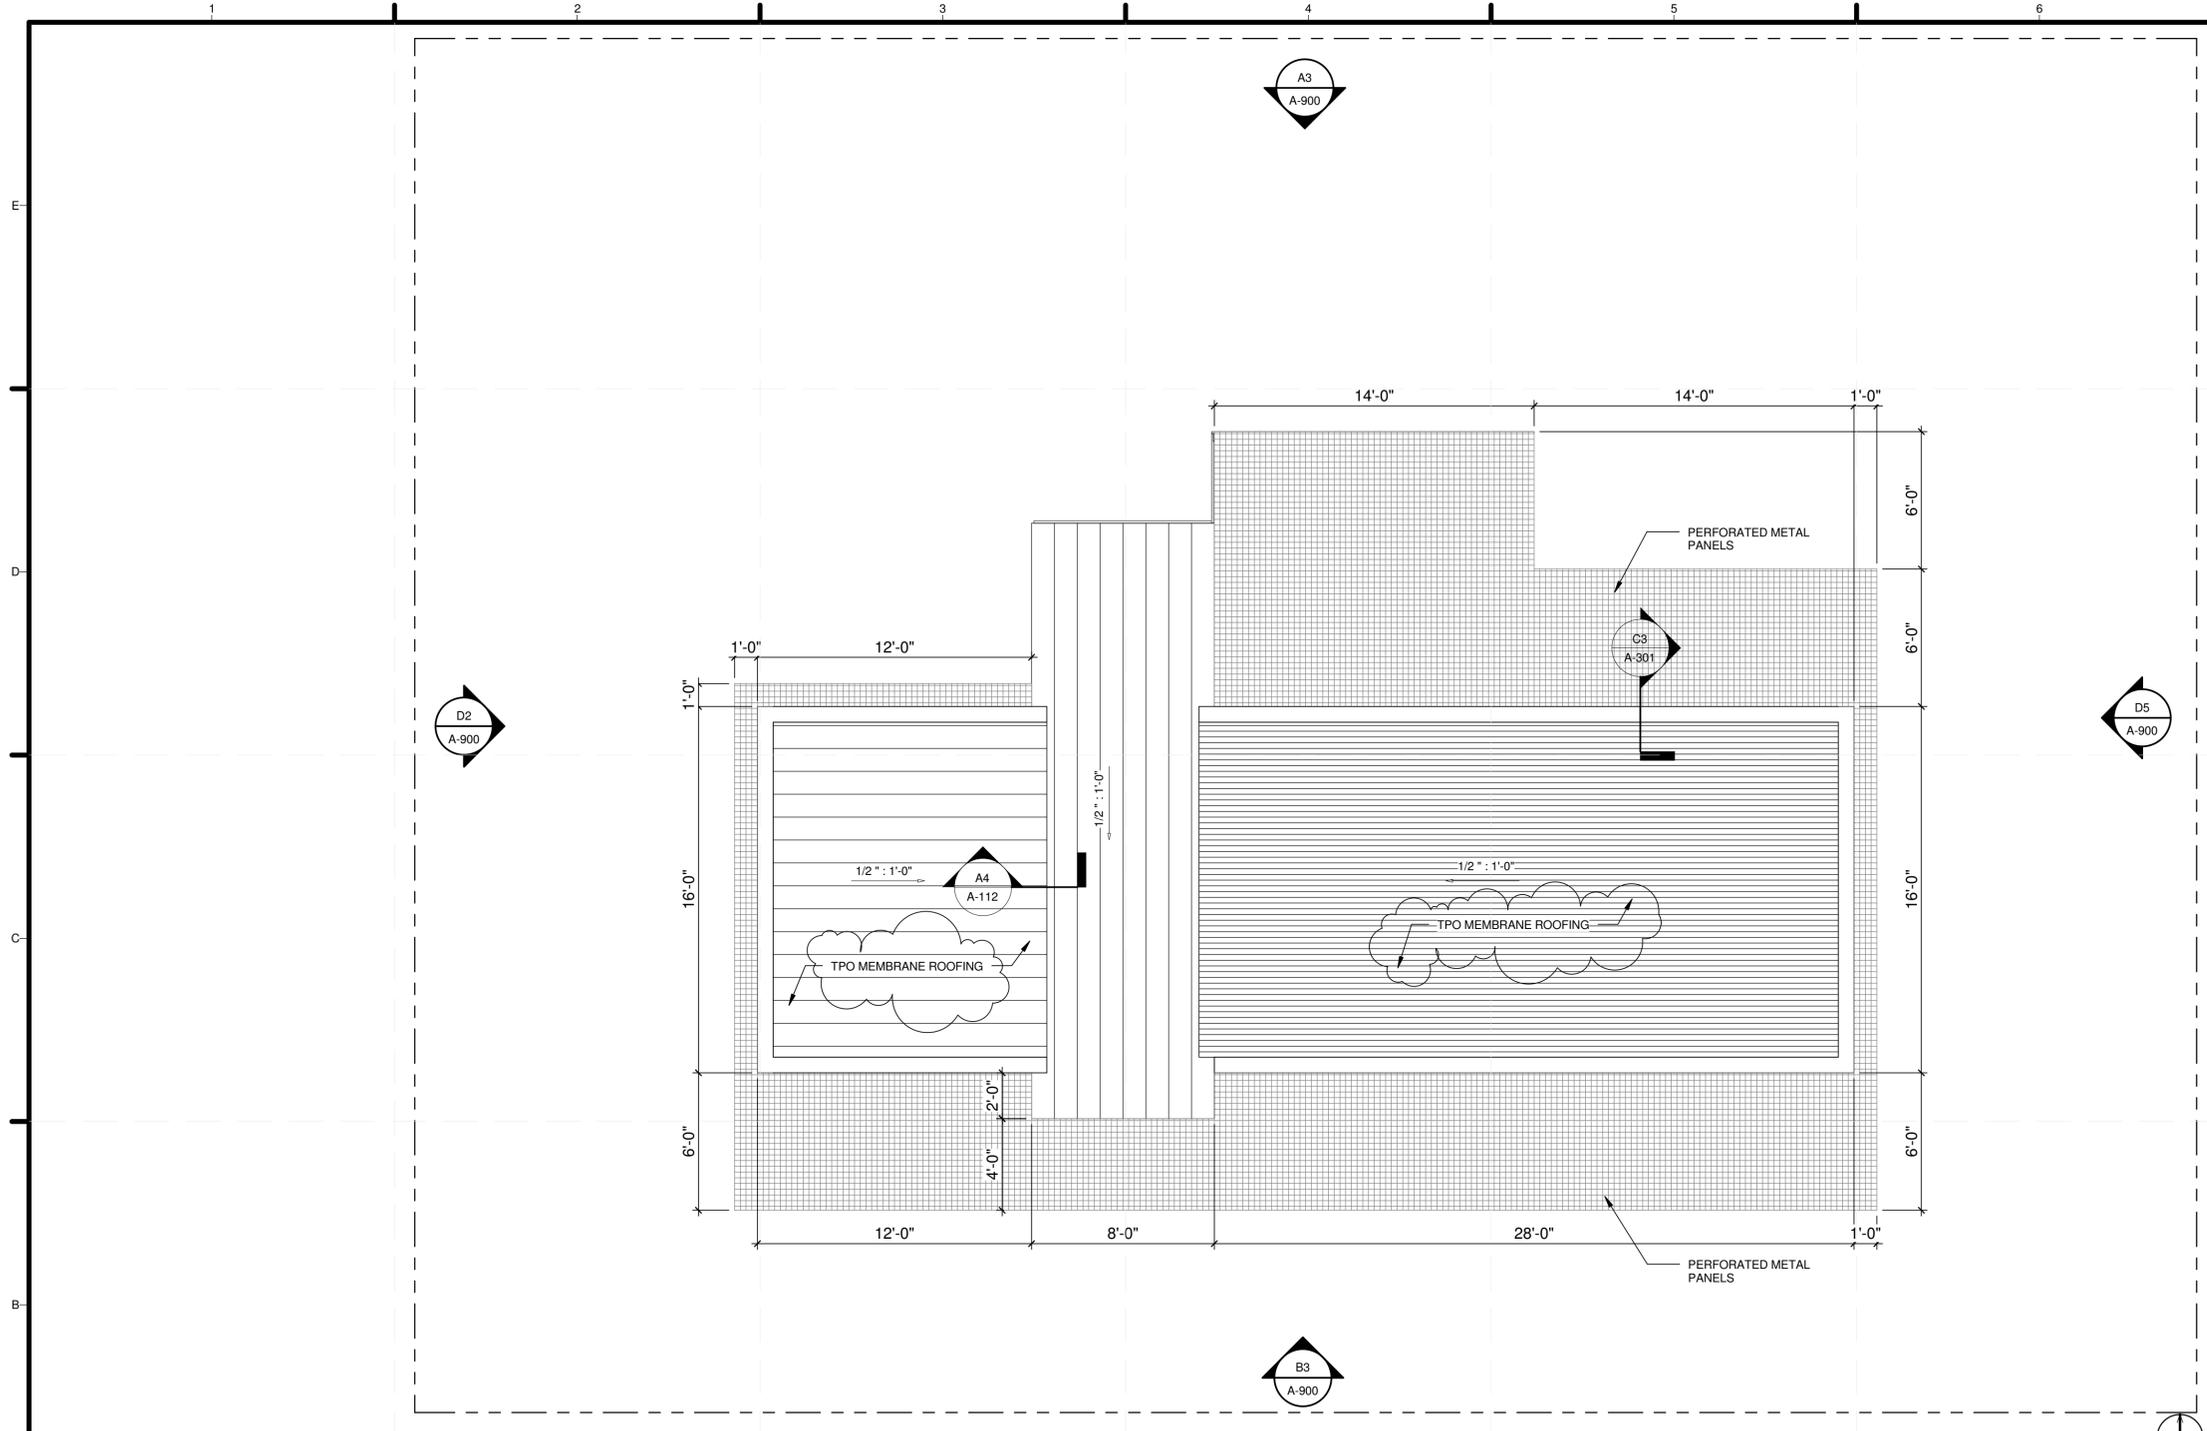

B2 ROOF PLAN
1/4" = 1'-0"

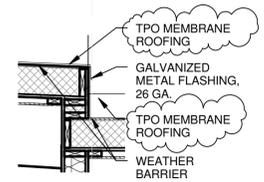


A4 MID. ROOF DTL.
1/2" = 1'-0"

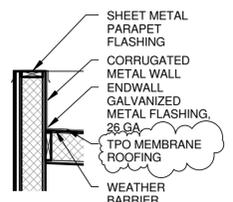

A6 TYP. FLASHING DTL.
1/2" = 1'-0"

REFERENCE KEYNOTES

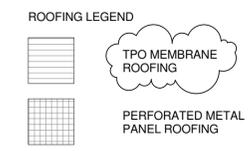

TEAM NAME: TEAM TEXAS
 ADDRESS: ORANGE COUNTY GREAT PARK
 IRVINE, CALIFORNIA
 LOT #106
 CONTACT: ASMARSHALL@UTEP.EDU
 SOLARDECATHLON.UTEP.EDU

CONSULTANTS



CLIENT
 U.S. DEPARTMENT OF ENERGY
 SOLAR DECATHLON 2013
 WWW.SOLARDECATHLON.GOV




01	10/11/2012	80% DOE/NR DD SUBMISSION
02	11/20/2012	80% DOE/NR DD RE-SUBMISSION
03	02/14/2013	95% DOE/NR CD SUBMISSION
03	04/05/2013	95% DOE/NR RE-SUBMISSION
04	08/22/2013	AS BUILTS

MARK	DATE	Revision 1	DESCRIPTION
------	------	------------	-------------

LOT NUMBER: #106
 DRAWN BY: TEAM TEXAS
 CHECKED BY: CONSULTANTS
 COPYRIGHT: NONE; PROJECT IS PUBLIC DOMAIN

SHEET TITLE
ROOF PLAN

A-112

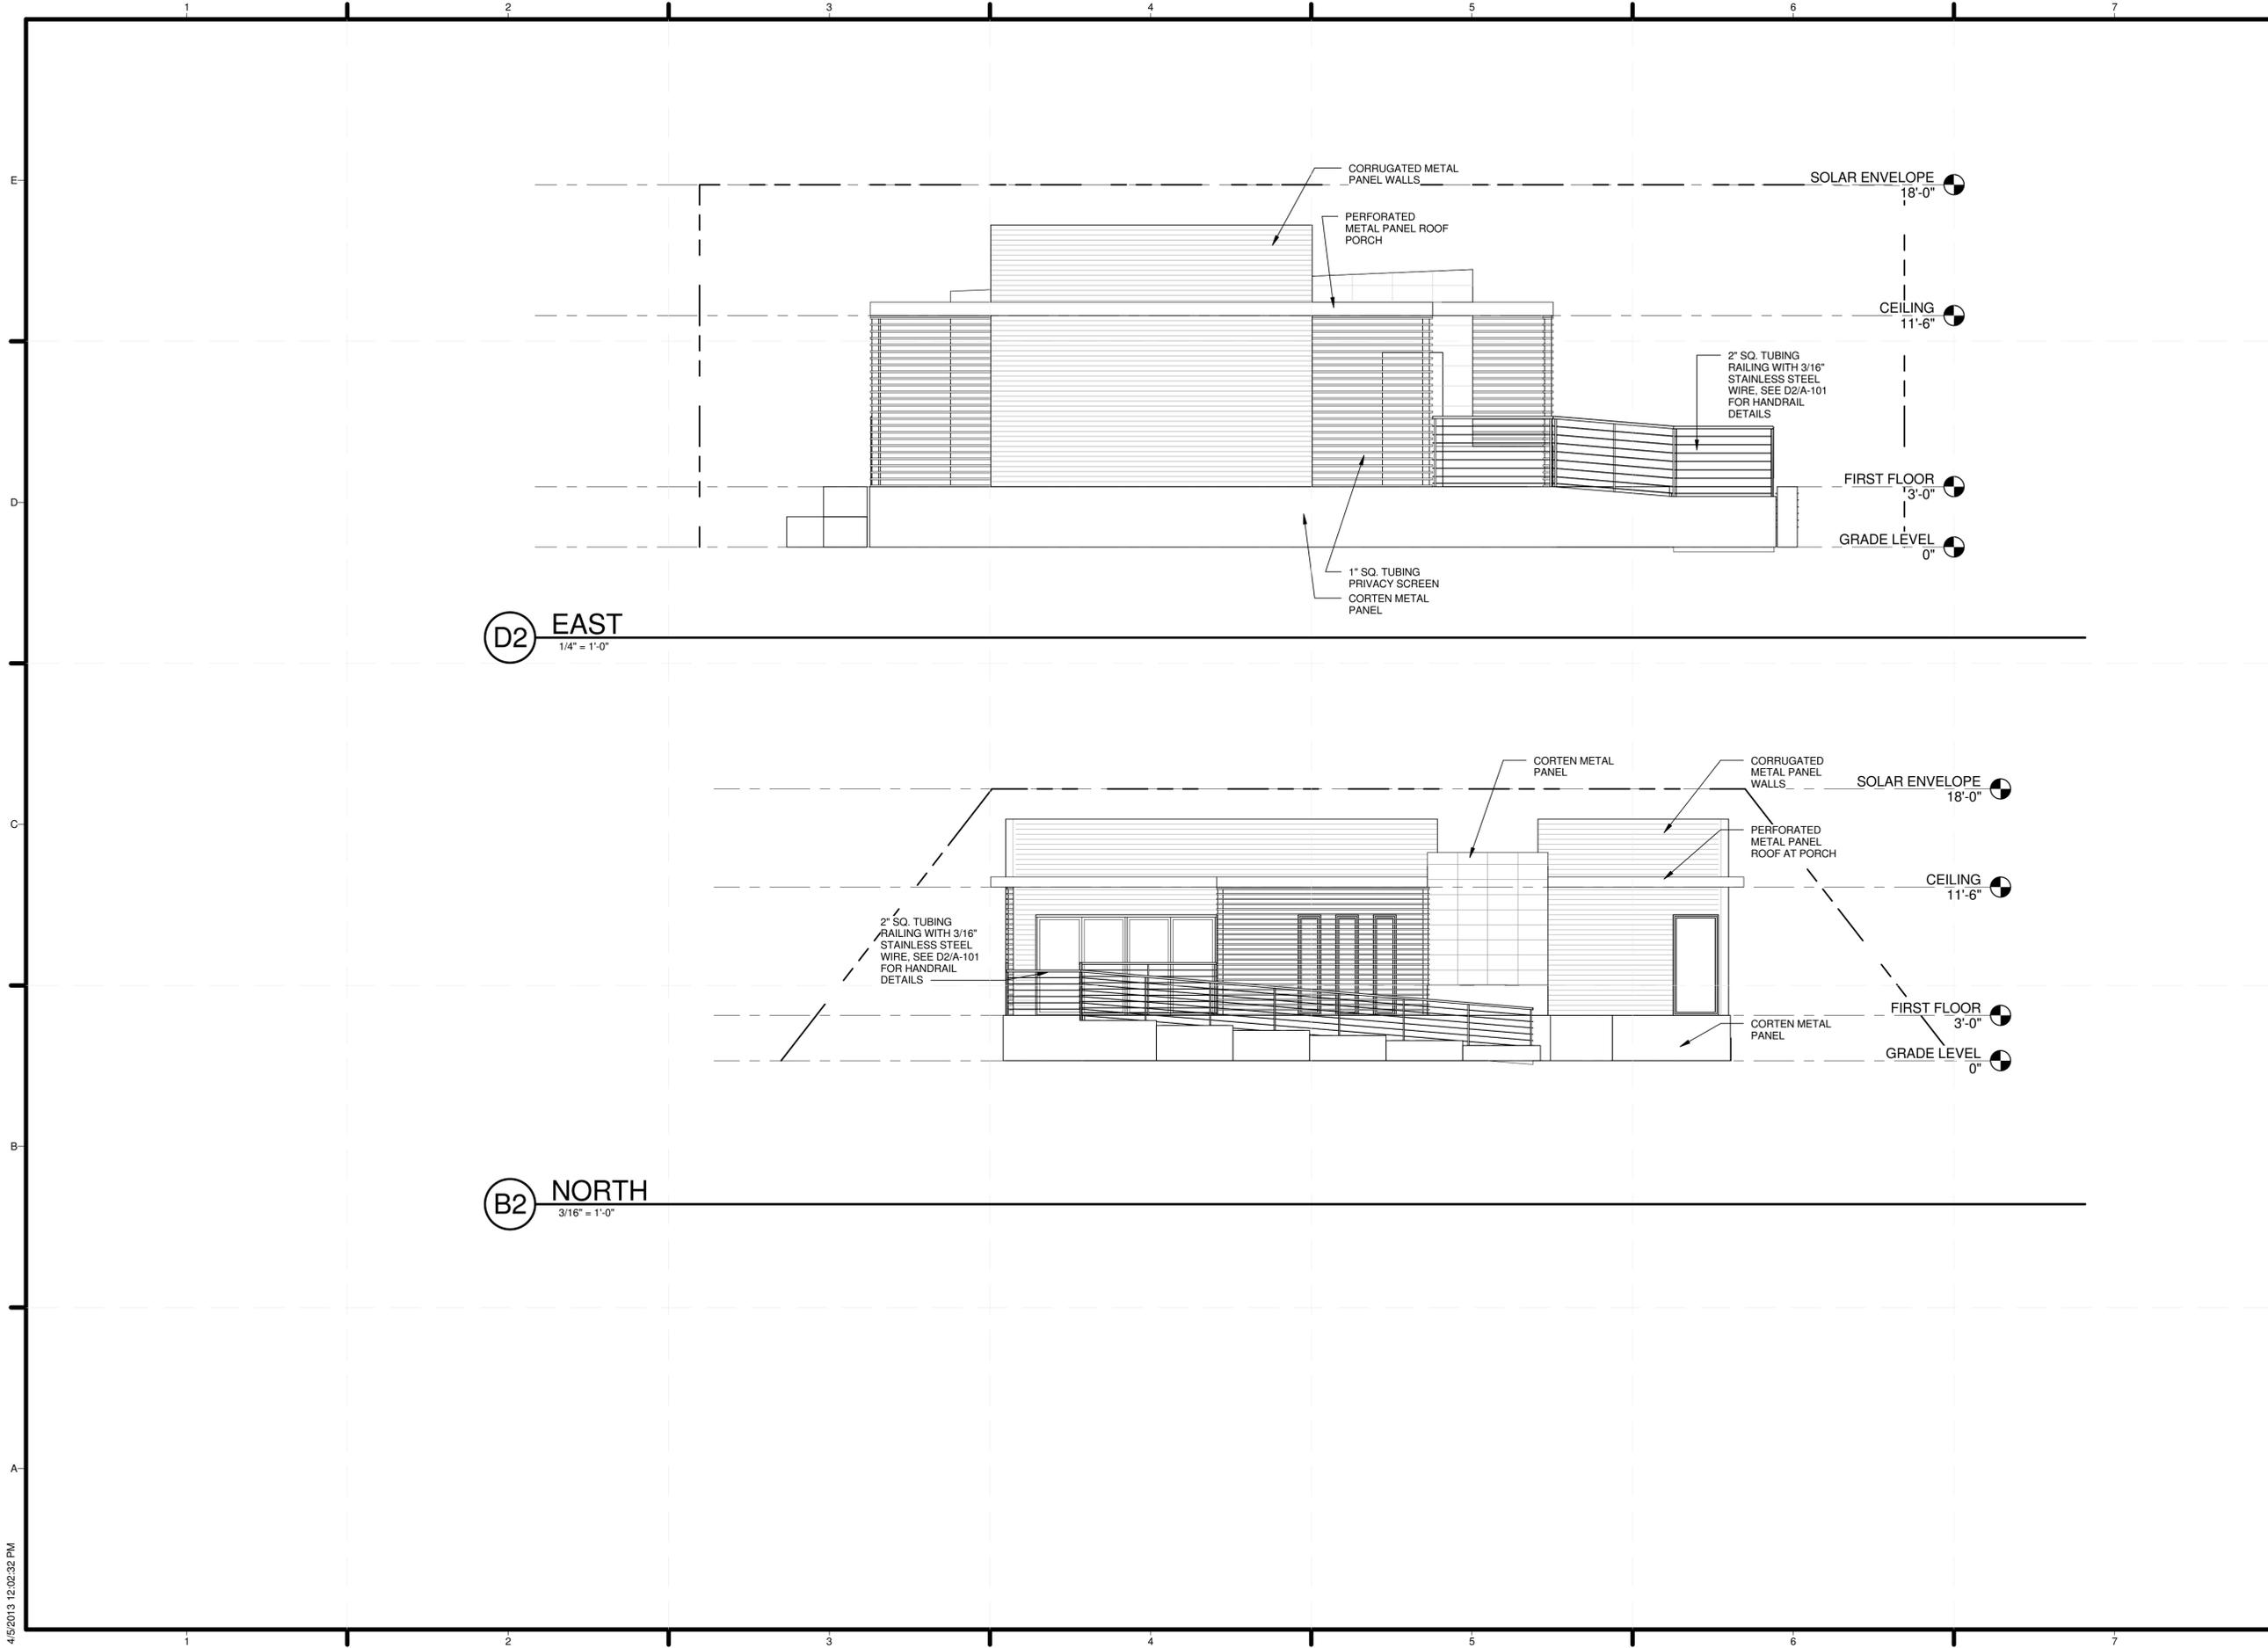

D2 EAST
1/4" = 1'-0"

B2 NORTH
3/16" = 1'-0"



TEAM NAME: TEAM TEXAS
 ADDRESS: ORANGE COUNTY GREAT PARK
 IRVINE, CALIFORNIA
 LOT #106
 CONTACT: ASMARSHALL@UTEP.EDU
 SOLARDECATHLON.UTEP.EDU

CONSULTANTS



CLIENT
 U.S. DEPARTMENT OF ENERGY
 SOLAR DECATHLON 2013
 WWW.SOLARDECATHLON.GOV




01	10/11/2012	80% DCENR DD SUBMISSION
02	11/20/2012	80% DCENR DD RE-SUBMISSION
03	02/14/2013	95% DCENR CD SUBMISSION
03	04/05/2013	95% DCENR RE-SUBMISSION

MARK	DATE	DESCRIPTION
------	------	-------------

LOT NUMBER: #106
 DRAWN BY: AUTHOR
 CHECKED BY: CHECKER
 COPYRIGHT: NONE: PROJECT IS PUBLIC DOMAIN

SHEET TITLE
ELEVATIONS

A-211

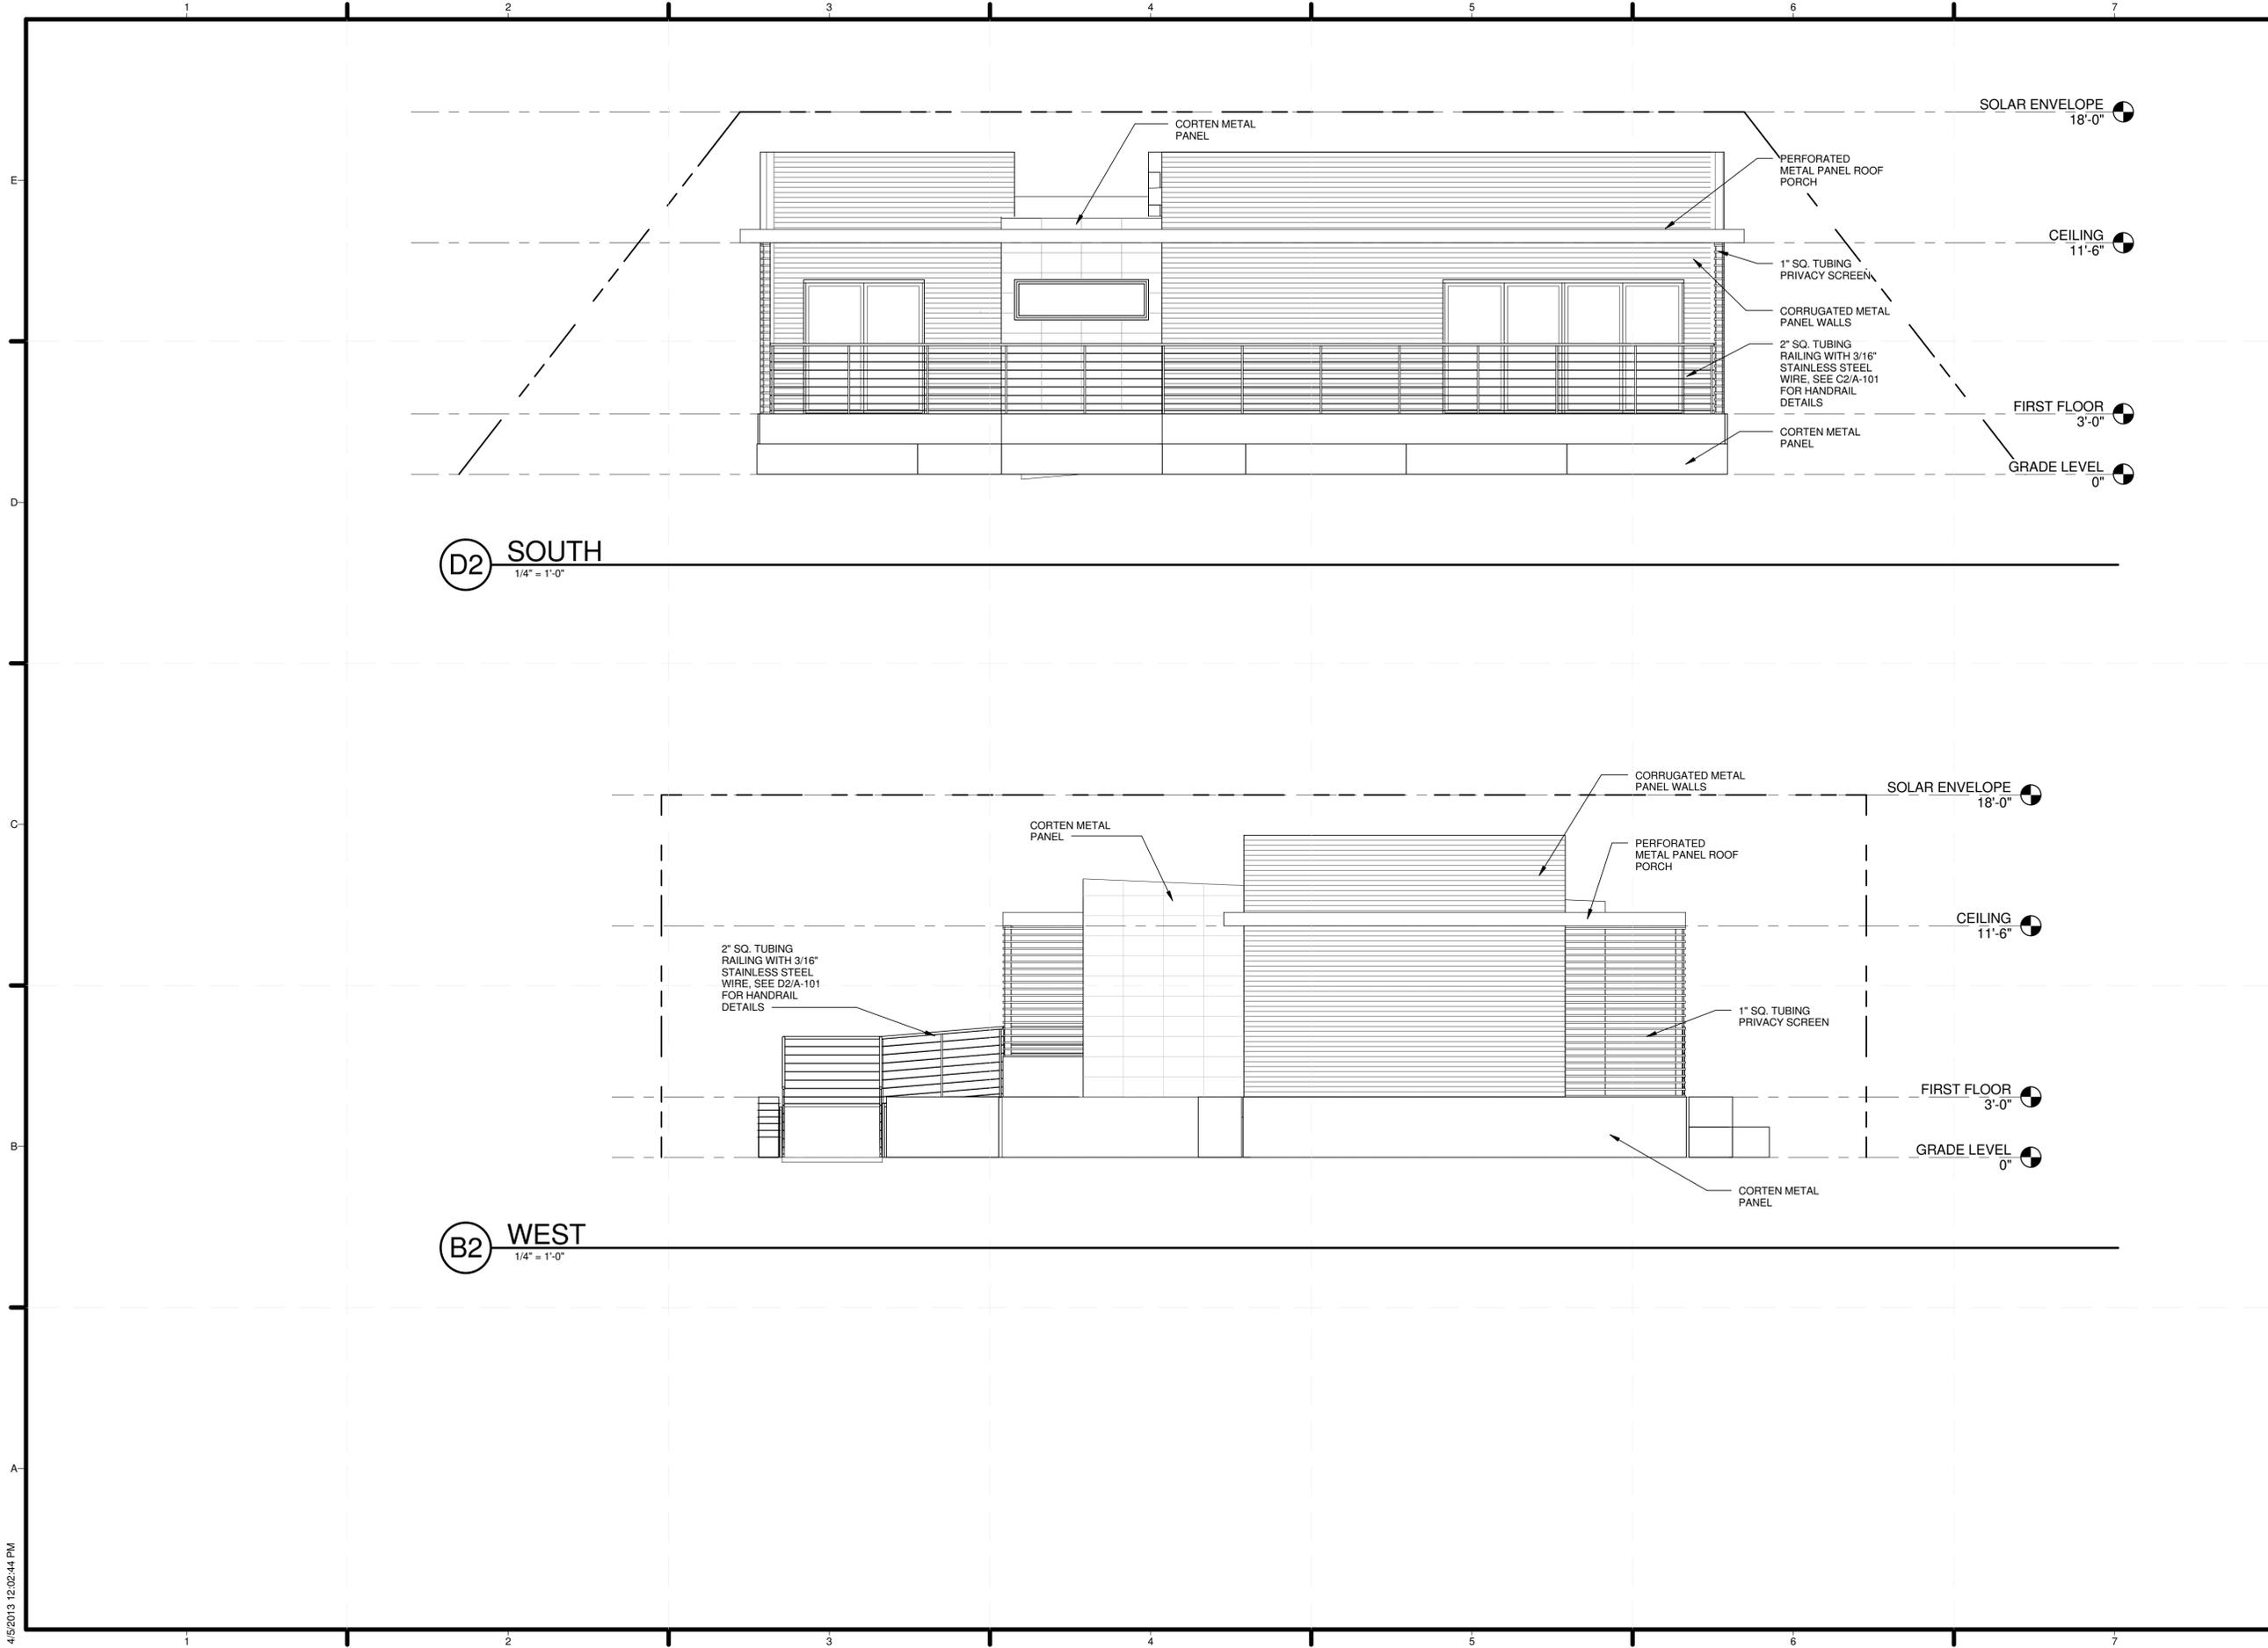

D2 SOUTH
1/4" = 1'-0"

B2 WEST
1/4" = 1'-0"



TEAM NAME: TEAM TEXAS
 ADDRESS: ORANGE COUNTY GREAT PARK
 IRVINE, CALIFORNIA
 LOT #106
 CONTACT: ASMARSHALL@UTEP.EDU
 SOLARDECATHLON.UTEP.EDU

CONSULTANTS



CLIENT
 U.S. DEPARTMENT OF ENERGY
 SOLAR DECATHLON 2013
 WWW.SOLARDECATHLON.GOV



01	10/11/2012	80% DCENR DD SUBMISSION
02	11/20/2012	80% DCENR DD RE-SUBMISSION
03	02/14/2013	95% DCENR CD SUBMISSION
03	04/05/2013	95% DCENR RE-SUBMISSION

MARK	DATE	DESCRIPTION
------	------	-------------

LOT NUMBER: #106
 DRAWN BY: AUTHOR
 CHECKED BY: CHECKER
 COPYRIGHT: NONE: PROJECT IS PUBLIC DOMAIN

SHEET TITLE
ELEVATIONS

A-212

TEAM NAME: TEAM TEXAS
 ADDRESS: ORANGE COUNTY GREAT PARK
 IRVINE, CALIFORNIA
 LOT #106
 CONTACT: ASMARSHALL@UTEP.EDU
 SOLARDECATHLON.UTEP.EDU

CONSULTANTS

CLIENT
 U.S. DEPARTMENT OF ENERGY
 SOLAR DECATHLON 2013
 WWW.SOLARDECATHLON.GOV



01	10/11/2012	80% DOE/RR DD SUBMISSION
02	11/20/2012	80% DOE/RR DD RE-SUBMISSION
03	02/14/2013	95% DOE/RR CD SUBMISSION
03	04/05/2013	95% DOE/RR RE-SUBMISSION
04	08/22/2013	AS BUILTS


MARK	DATE	Revision 1	DESCRIPTION

LOT NUMBER: #106
 DRAWN BY: AUTHOR
 CHECKED BY: CHECKER
 COPYRIGHT: NONE; PROJECT IS PUBLIC DOMAIN

SHEET TITLE


INTERIOR ELEVATIONS

A-213

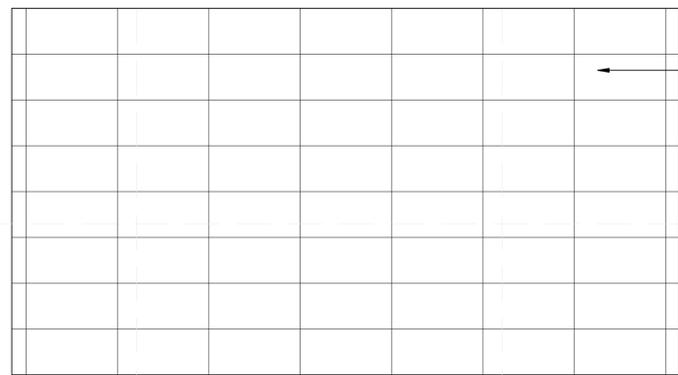


ACCENT WALL:
 SIERRA DESIGNED CORK TILE
 11.75" X 23.75"

D1 INTERIOR ELEVATION - BEDROOM
 1/2" = 1'-0"

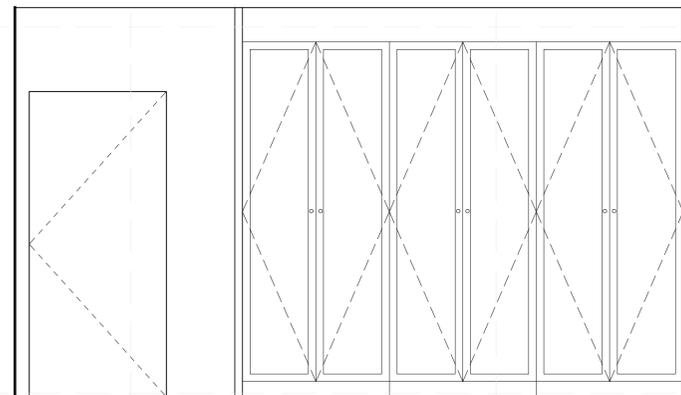


B1 INTERIOR ELEVATION - BEDROOM
 1/2" = 1'-0"

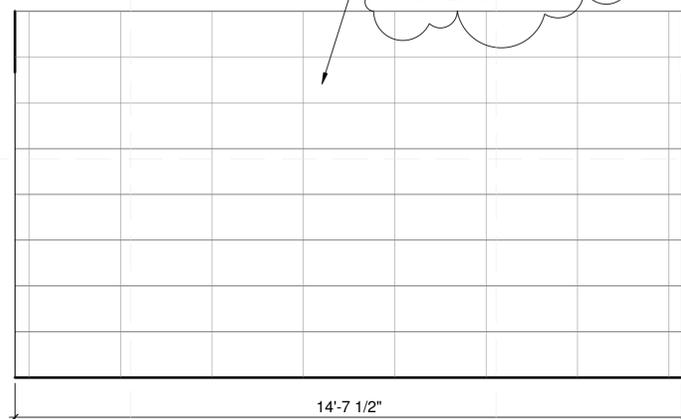


ACCENT WALL:
 SIERRA DESIGNED CORK TILE
 11.75" X 23.75"


A1 INTERIOR ELEVATION - MEDIA CENTER
 1/2" = 1'-0"

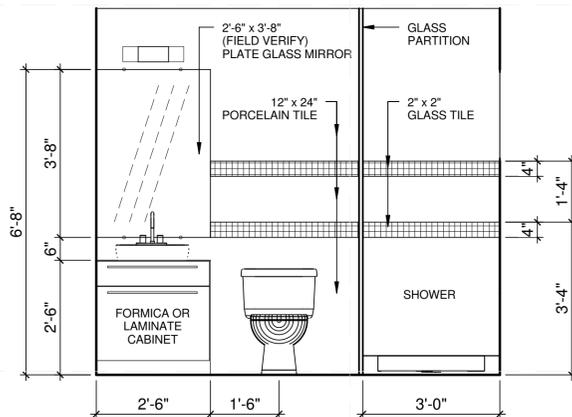


B3 INTERIOR ELEVATION - BATH
 1/2" = 1'-0"

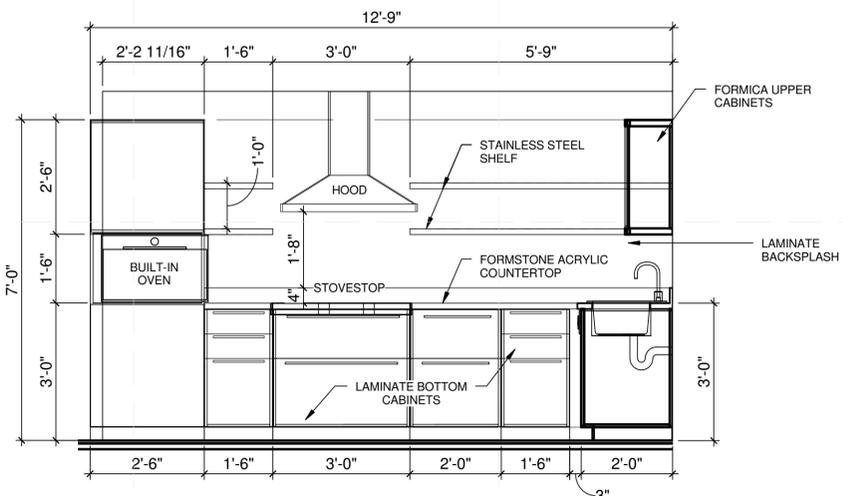


A3 INTERIOR ELEVATION - KITCHEN
 1/2" = 1'-0"

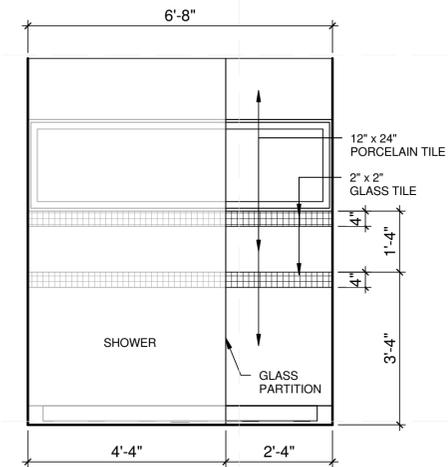

B6 INTERIOR ELEVATION - BATH 2
 1/2" = 1'-0"

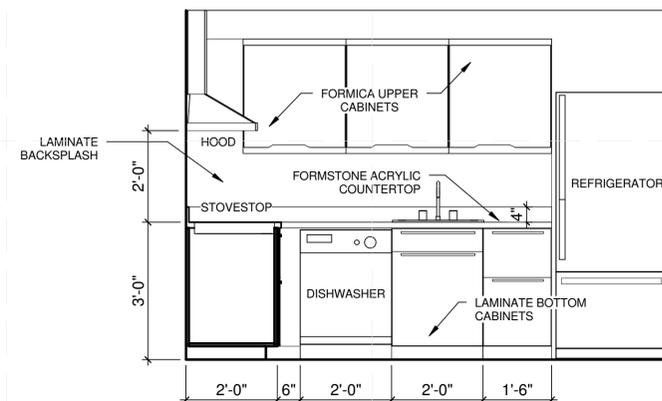

A6 INTERIOR ELEVATION - KITCHEN
 1/2" = 1'-0"

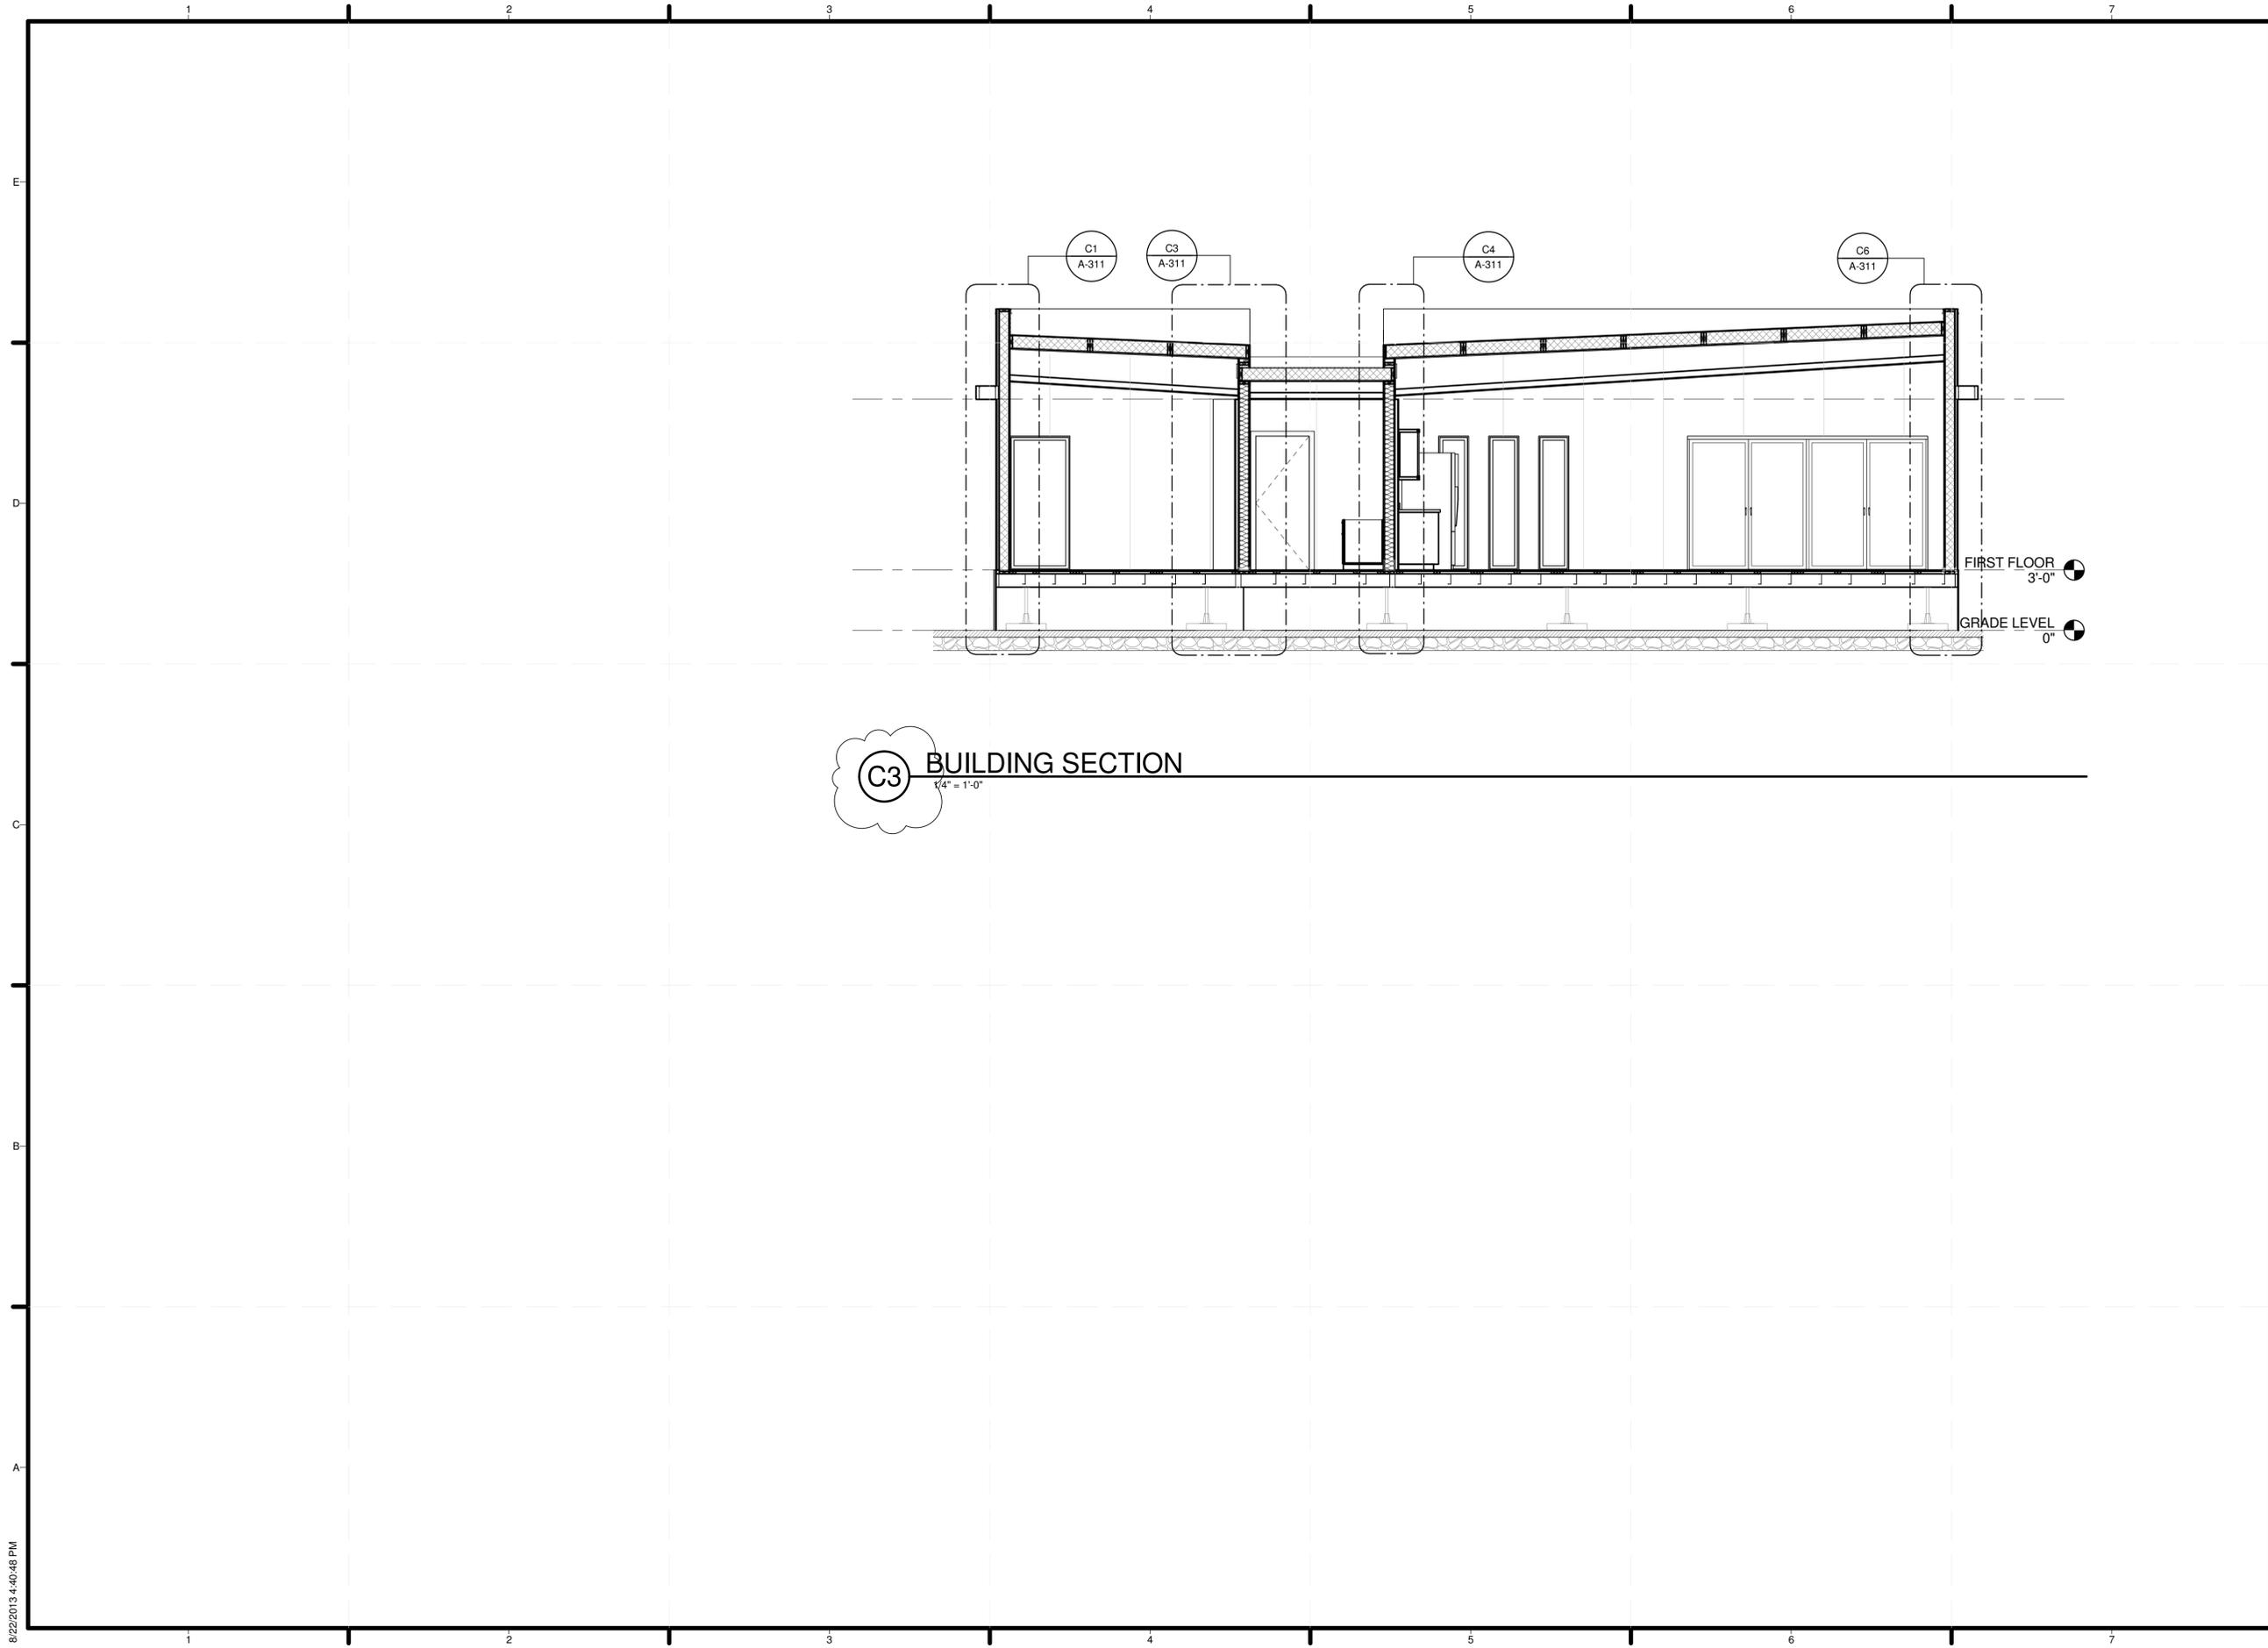

TEAM NAME: TEAM TEXAS
 ADDRESS: ORANGE COUNTY GREAT PARK
 IRVINE, CALIFORNIA
 LOT #106
 CONTACT: ASMARSHALL@UTEP.EDU
 SOLARDECATHLON.UTEP.EDU

CONSULTANTS

FIRST FLOOR 3'-0"
 GRADE LEVEL 0"

C3 BUILDING SECTION
 1/4" = 1'-0"

CLIENT
 U.S. DEPARTMENT OF ENERGY
 SOLAR DECATHLON 2013
 WWW.SOLARDECATHLON.GOV



01	10/11/2012	80% DOE NR DD SUBMISSION
02	11/20/2012	80% DOE NR DD RE-SUBMISSION
03	02/14/2013	95% DOE NR CD SUBMISSION
03	04/05/2013	95% DOE NR RE-SUBMISSION
04	08/22/2013	AS BUILTS


MARK	DATE	REVISION 1	DESCRIPTION

LOT NUMBER: #106
 DRAWN BY: AUTHOR
 CHECKED BY: CHECKER
 COPYRIGHT: NONE; PROJECT IS PUBLIC DOMAIN


SHEET TITLE

BUILDING SECTIONS

A-301

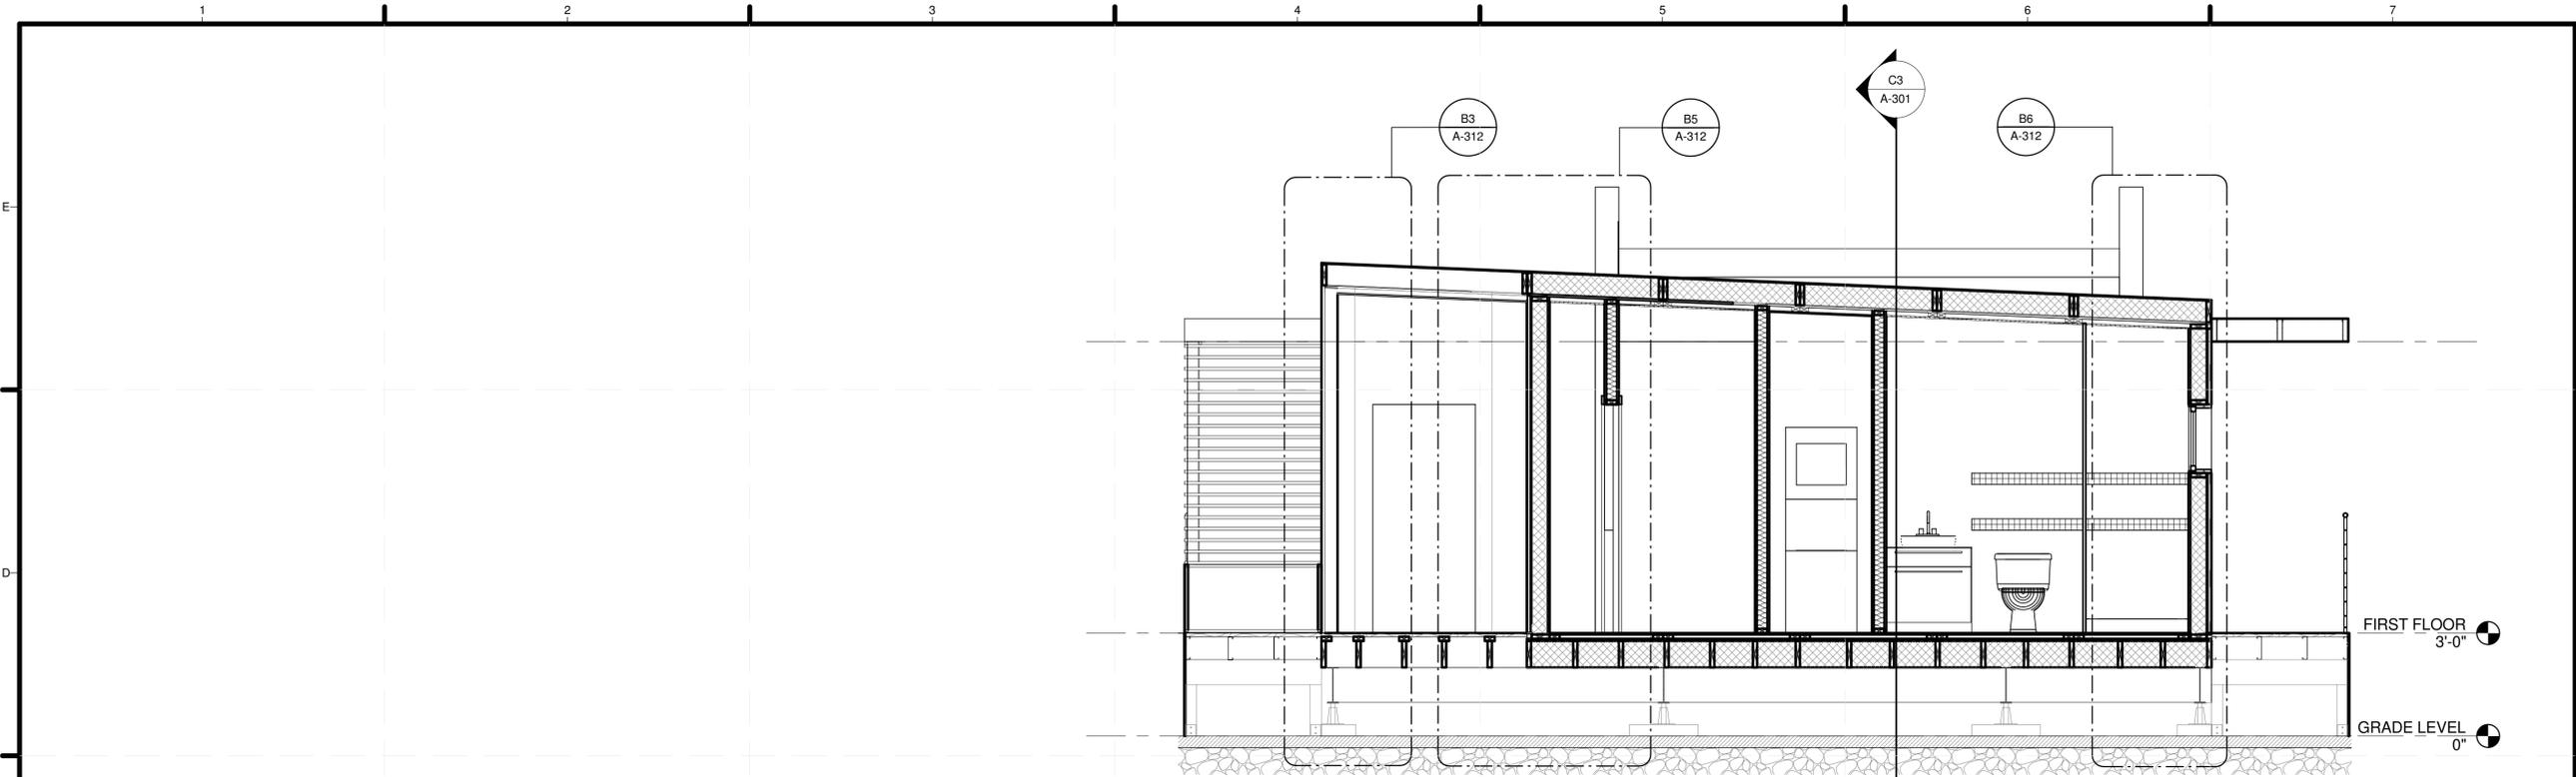

C4 BUILDING SECTION - CENTER
3/8" = 1'-0"

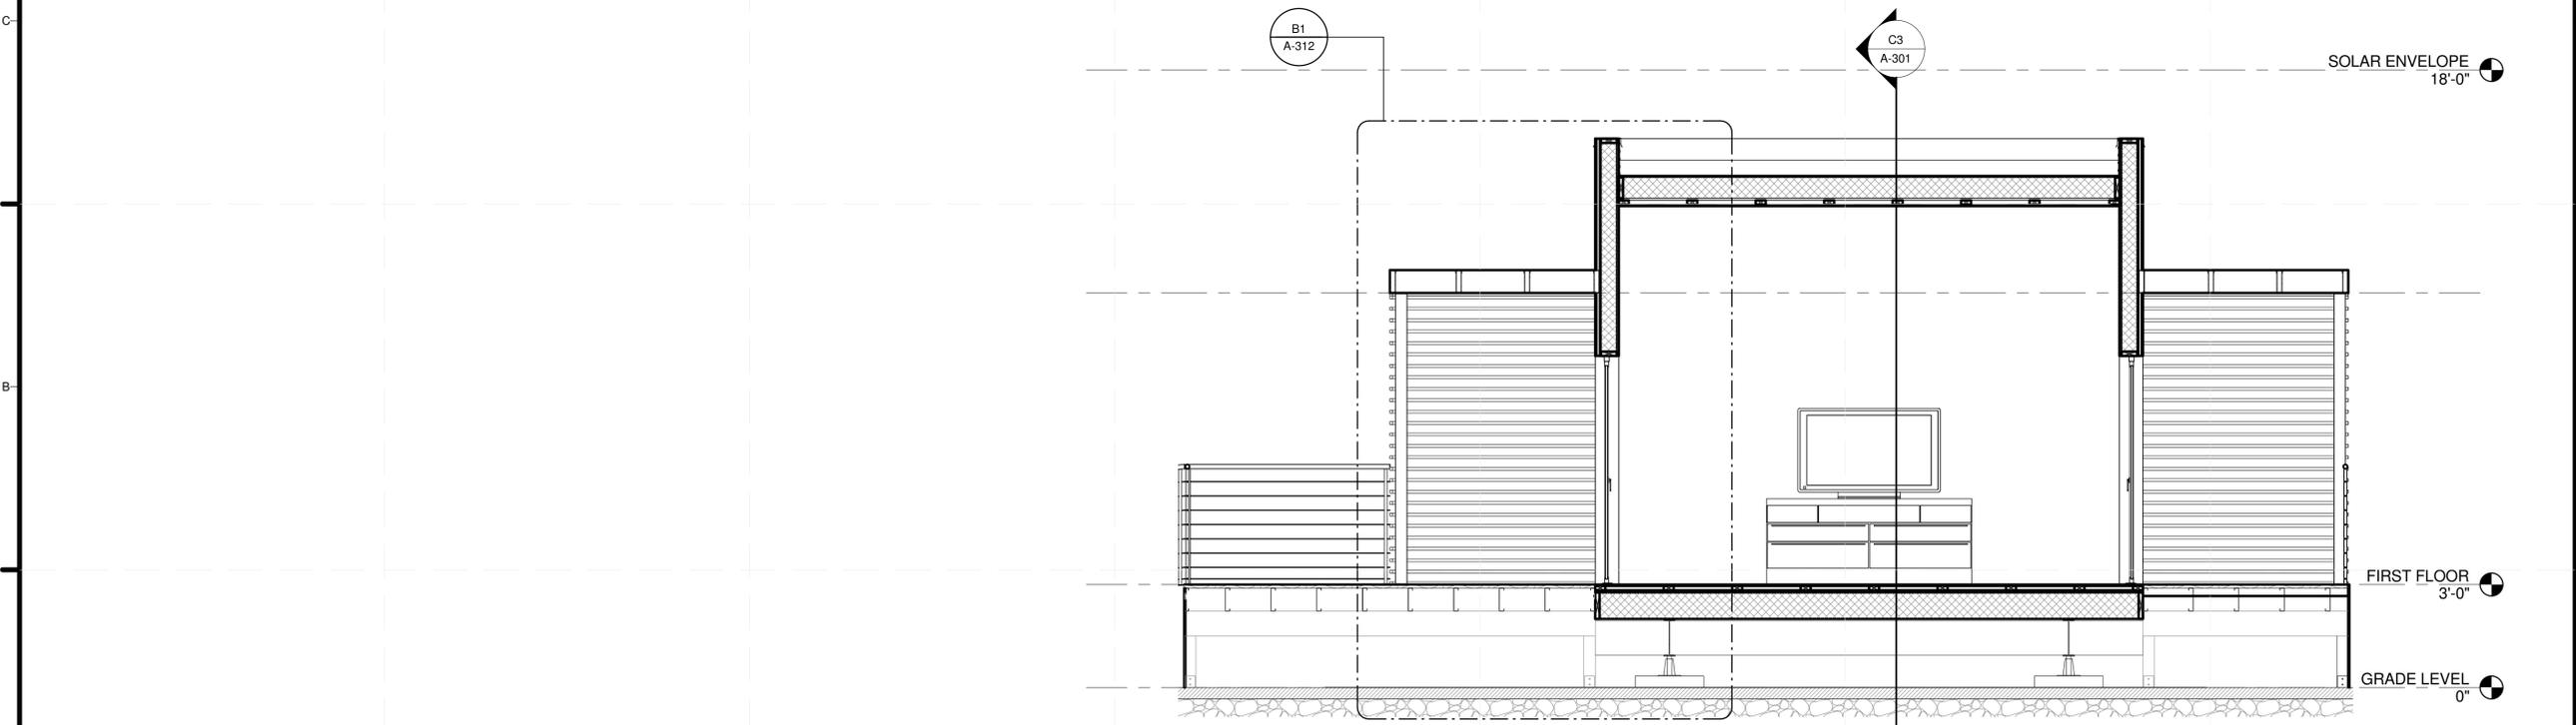

A4 BUILDING SECTION - ENTRETAINMENT
3/8" = 1'-0"



TEAM NAME: TEAM TEXAS
 ADDRESS: ORANGE COUNTY GREAT PARK
 IRVINE, CALIFORNIA
 LOT #106
 CONTACT: ASMARSHALL@UTEP.EDU
 SOLARDECATHLON.UTEP.EDU

CONSULTANTS

FIRST FLOOR 3'-0"

GRADE LEVEL 0"

CLIENT
 U.S. DEPARTMENT OF ENERGY
 SOLAR DECATHLON 2013
 WWW.SOLARDECATHLON.GOV



01	10/11/2012	80% DCENR DD SUBMISSION
02	11/20/2012	80% DCENR DD RE-SUBMISSION
03	02/14/2013	95% DCENR CD SUBMISSION
03	04/05/2013	95% DCENR RE-SUBMISSION

MARK	DATE	DESCRIPTION
------	------	-------------

LOT NUMBER: #106
 DRAWN BY: AUTHOR
 CHECKED BY: CHECKER
 COPYRIGHT: NONE; PROJECT IS PUBLIC DOMAIN

SHEET TITLE

BUILDING SECTIONS

A-302

TEAM NAME: TEAM TEXAS
 ADDRESS: ORANGE COUNTY GREAT PARK
 IRVINE, CALIFORNIA
 LOT #106
 CONTACT: ASMARSHALL@UTEP.EDU
 SOLARDECATHLON.UTEP.EDU

CONSULTANTS



CLIENT
 U.S. DEPARTMENT OF ENERGY
 SOLAR DECATHLON 2013
 WWW.SOLARDECATHLON.GOV



01	10/11/2012	80% DOE/NER DD SUBMISSION
02	11/20/2012	80% DOE/NER DD RE-SUBMISSION
03	02/14/2013	95% DOE/NER CD SUBMISSION
03	04/05/2013	95% DOE/NER RE-SUBMISSION
04	08/22/2013	AS BUILTS


MARK	DATE	Revision 1	DESCRIPTION
------	------	------------	-------------

LOT NUMBER: #106
 DRAWN BY: AUTHOR
 CHECKED BY: CHECKER
 COPYRIGHT: NONE; PROJECT IS PUBLIC DOMAIN


SHEET TITLE

WALL SECTIONS


A-311

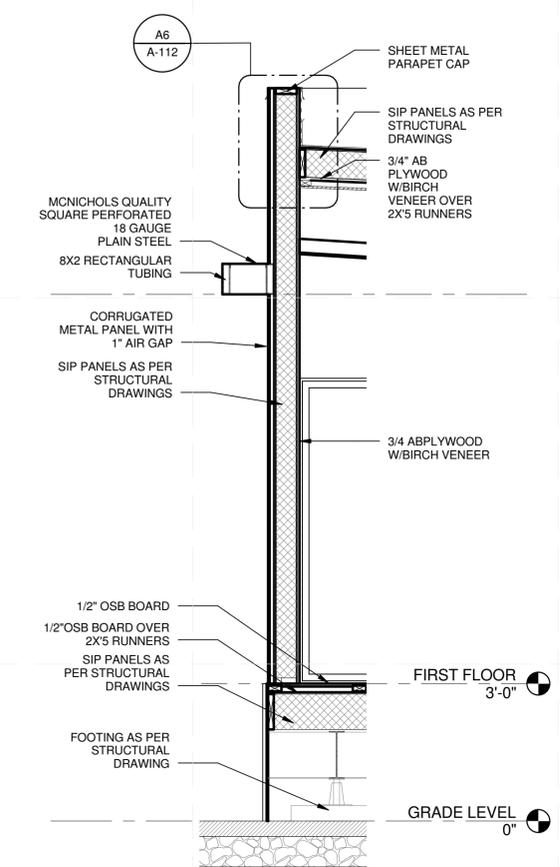


C1 WALL SECTION D
 1/2" = 1'-0"

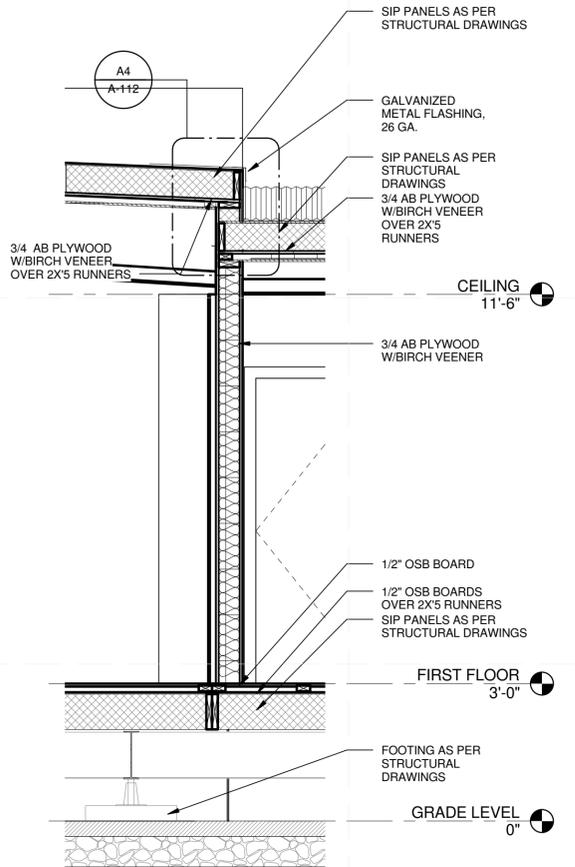




C3 WALL SECTION C
 1/2" = 1'-0"

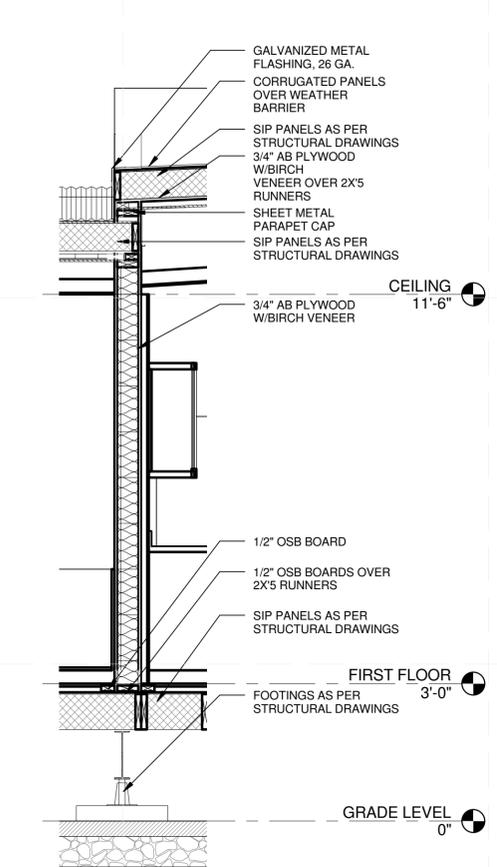

C4 WALL SECTION B
 1/2" = 1'-0"

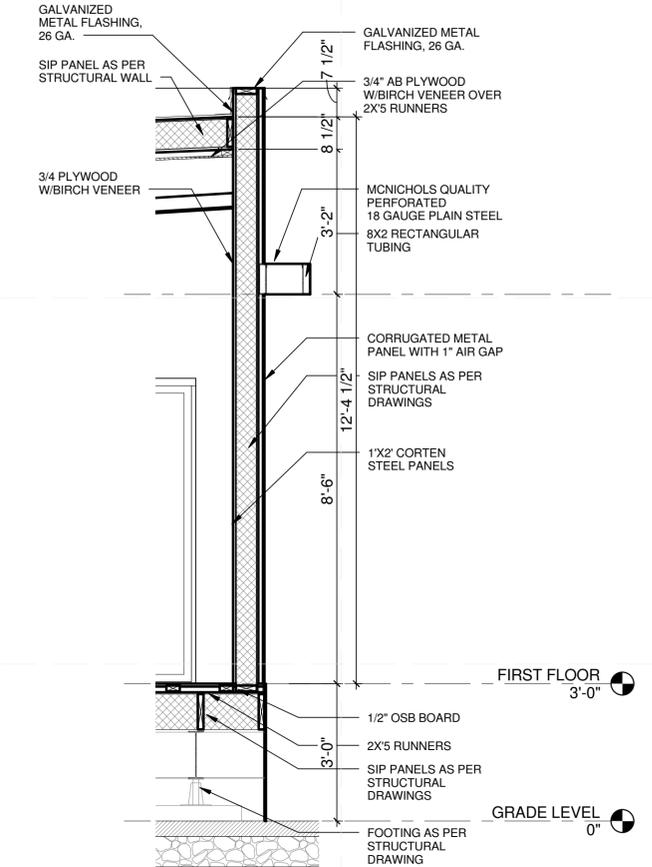

C6 WALL SECTION A
 1/2" = 1'-0"

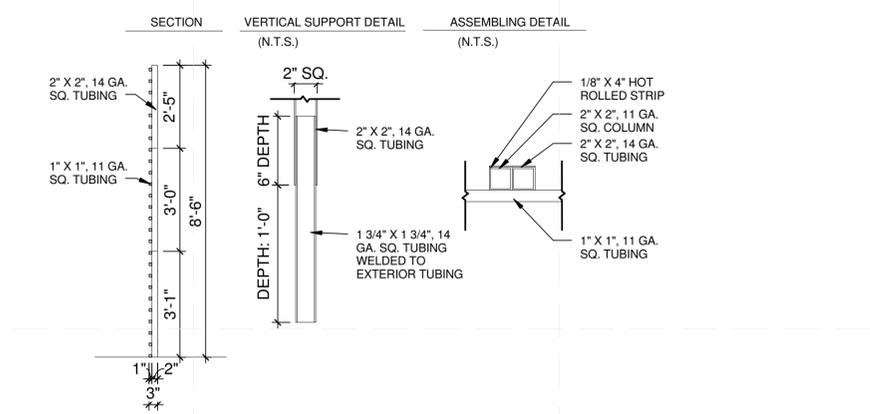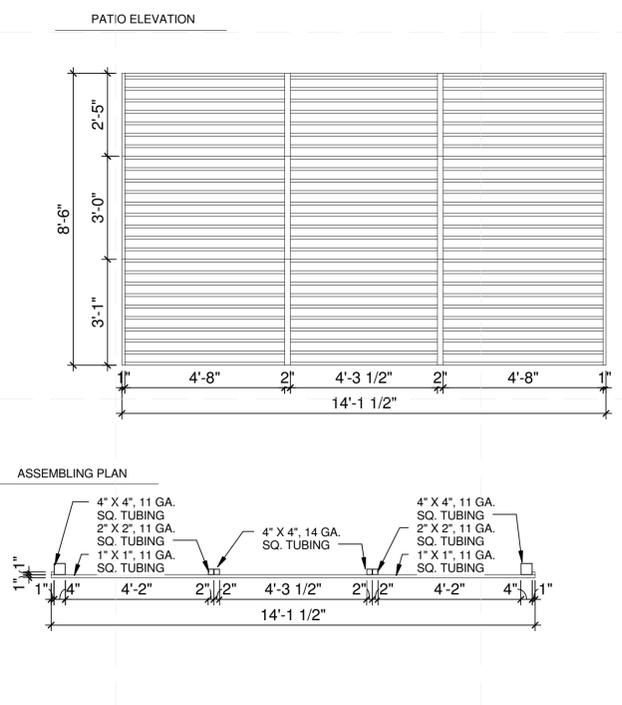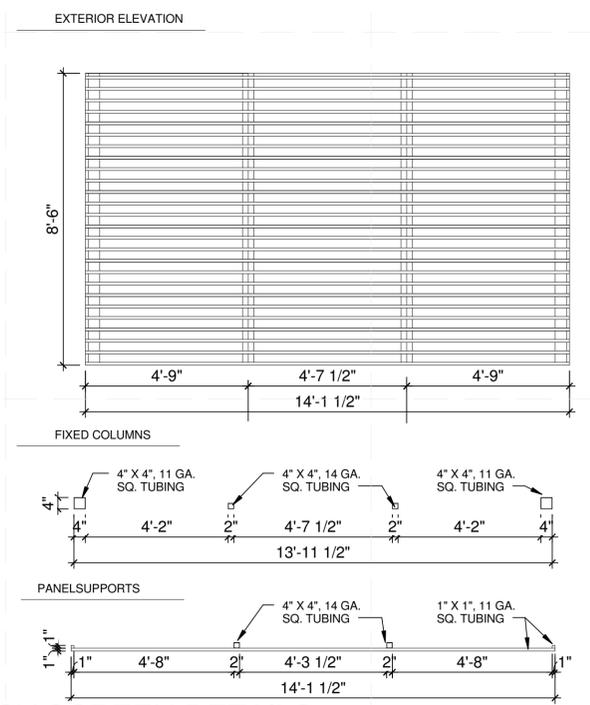

A1 PRIVACY SCREEN DETAILS
 3/8" = 1'-0"

TEAM NAME: TEAM TEXAS
 ADDRESS: ORANGE COUNTY GREAT PARK
 IRVINE, CALIFORNIA
 LOT #106
 CONTACT: ASMARSHALL@UTEP.EDU
 SOLARDECATHLON.UTEP.EDU

CONSULTANTS
 .
 .
CLIENT
 U.S. DEPARTMENT OF ENERGY
 SOLAR DECATHLON 2013
 WWW.SOLARDECATHLON.GOV




01	10/11/2012	80% DCENR DD SUBMISSION
02	11/20/2012	80% DCENR DD RE-SUBMISSION
03	02/14/2013	95% DCENR CD SUBMISSION
03	04/05/2013	95% DCENR RE-SUBMISSION

MARK	DATE	DESCRIPTION
------	------	-------------

LOT NUMBER: #106
 DRAWN BY: TEAM TEXAS
 CHECKED BY: CONSULTANTS
 COPYRIGHT: NONE: PROJECT IS PUBLIC DOMAIN

SHEET TITLE
WALL SECTIONS

A-312

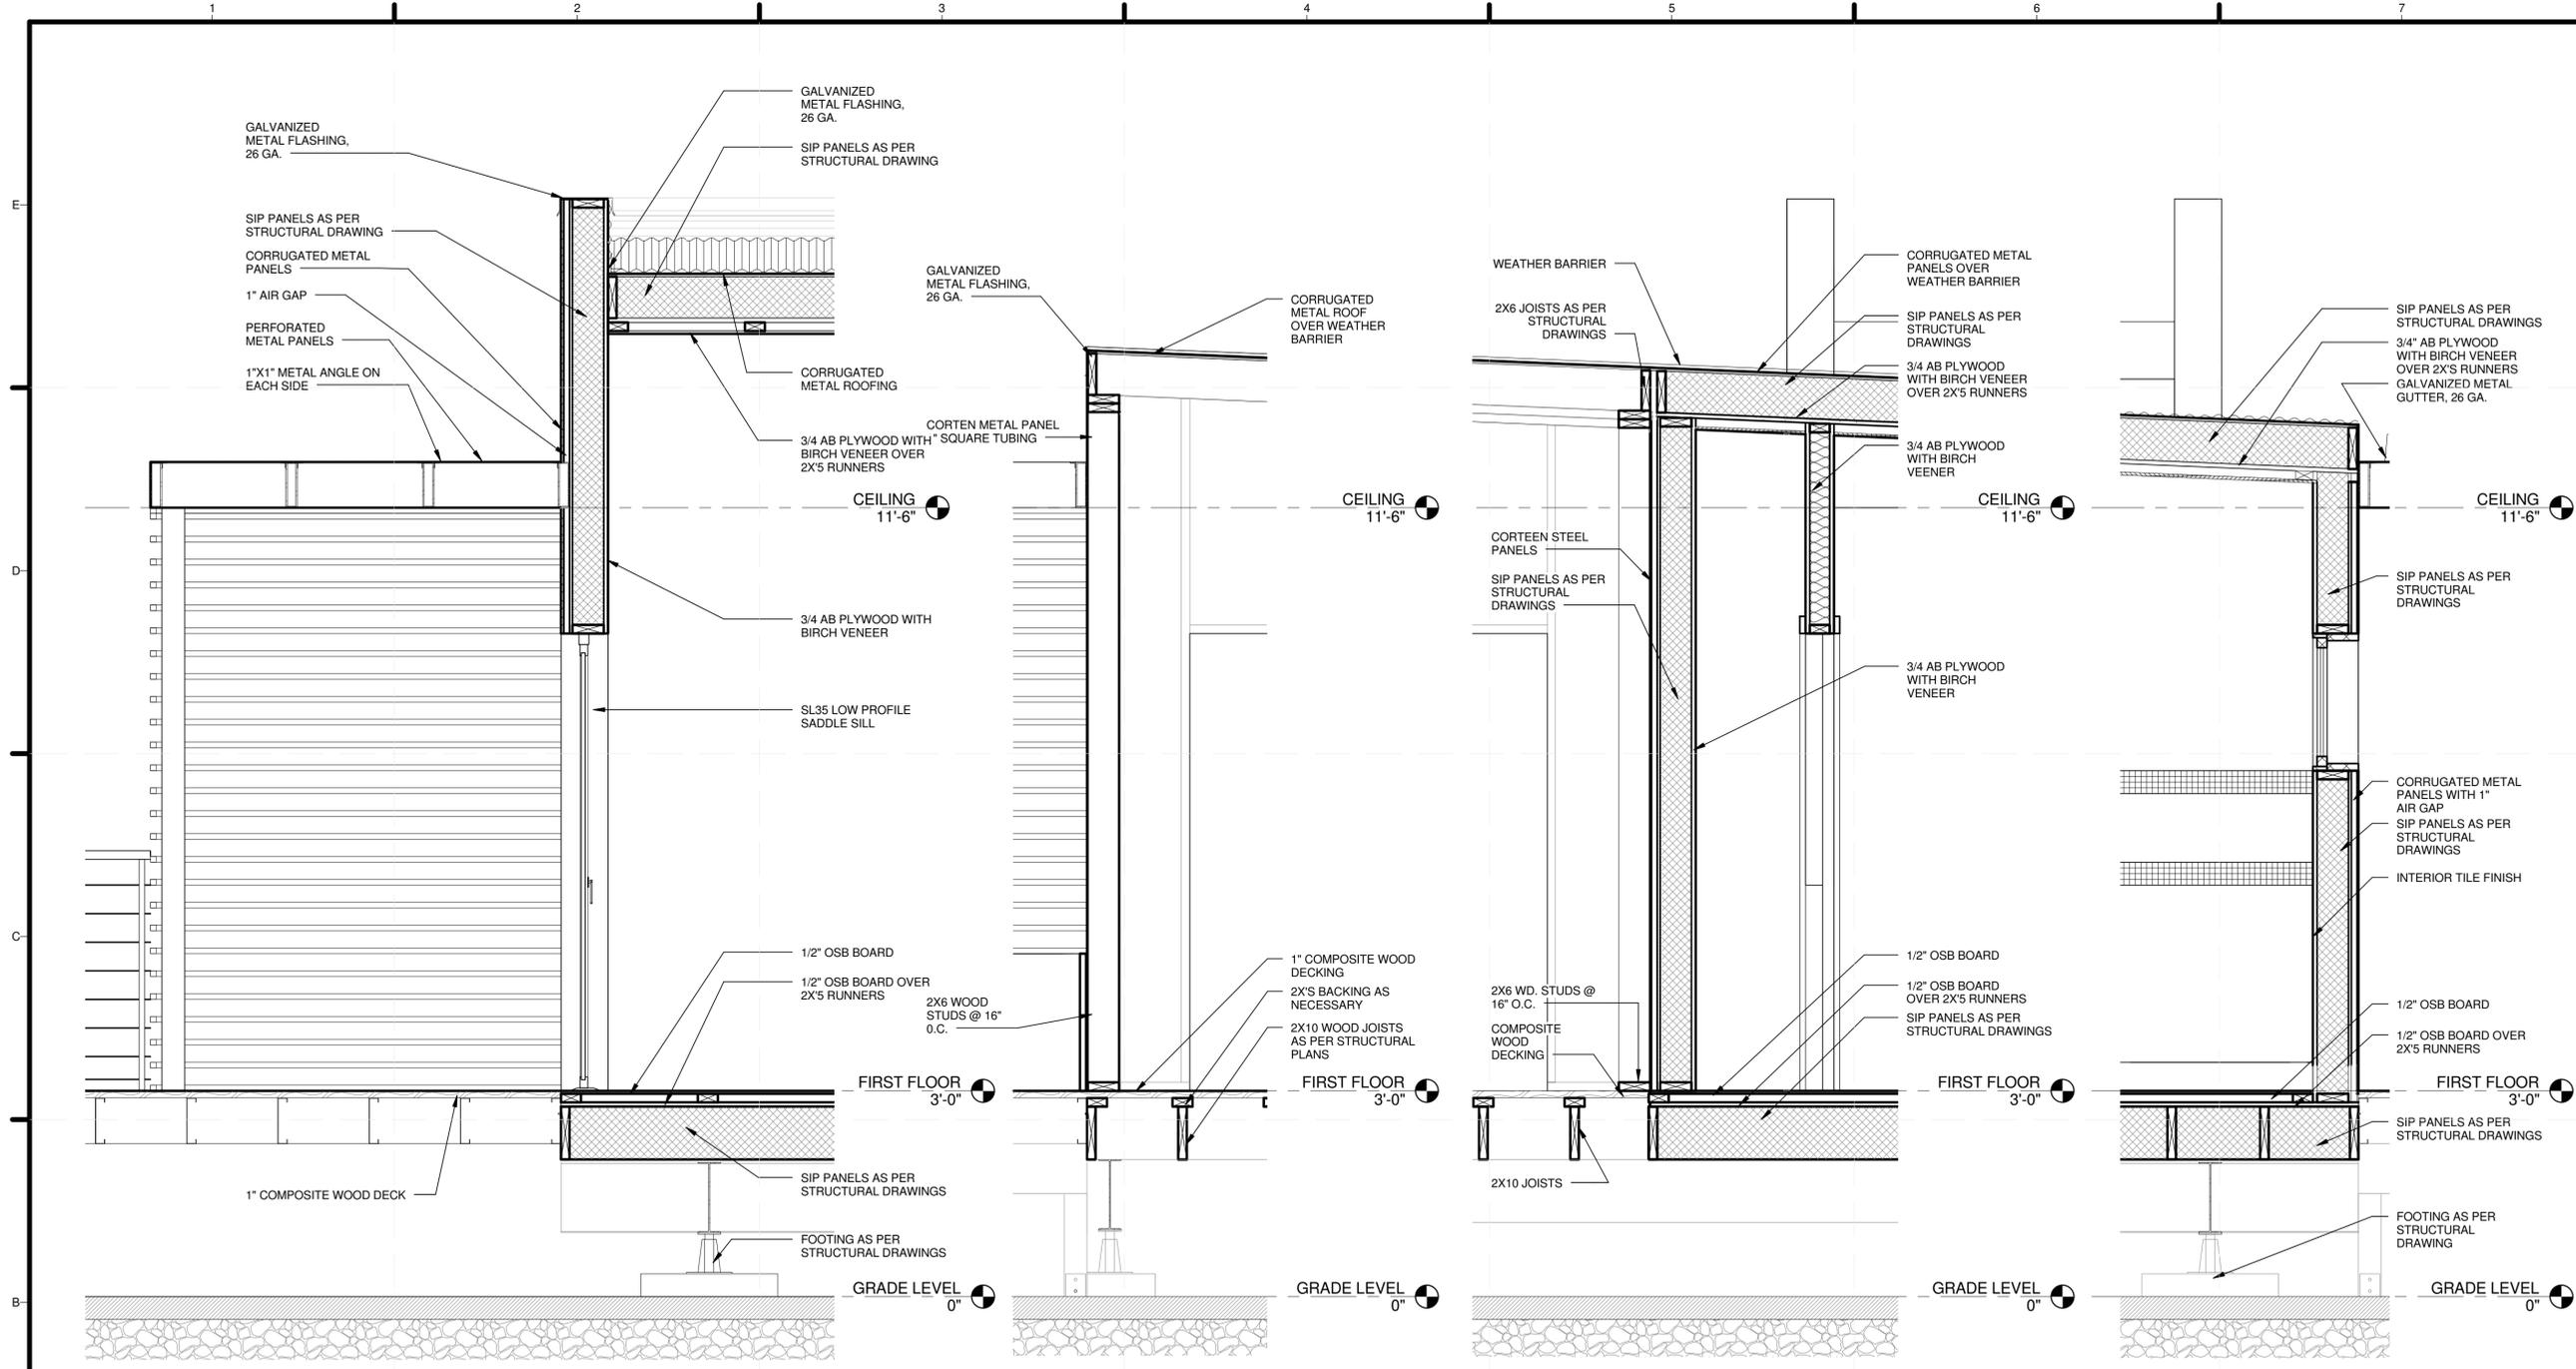


(B1) WALL SECTION 4
 3/4" = 1'-0"


(B3) WALL SECTION 3
 3/4" = 1'-0"

(B5) WALL SECTION 2
 3/4" = 1'-0"


(B6) WALL SECTION 1
 3/4" = 1'-0"

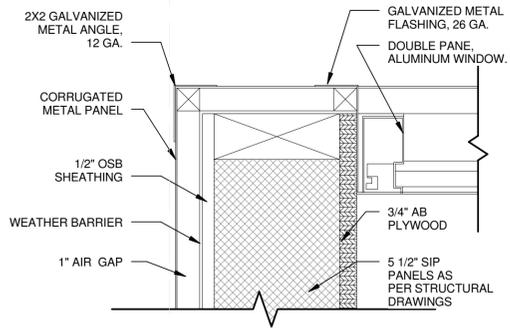


D2 BEDROOM/BATH JAMB DETAIL
3" = 1'-0"

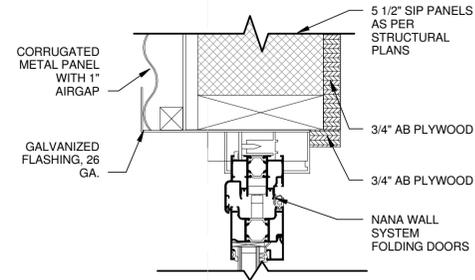


D4 NANA WALL HEAD DETAIL
3" = 1'-0"

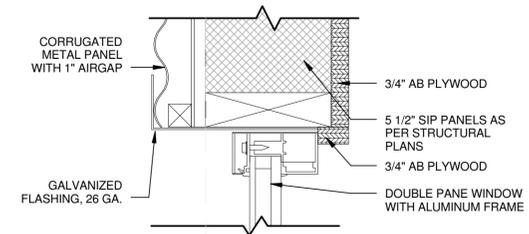


D6 TYPICAL HEAD DETAIL
3" = 1'-0"

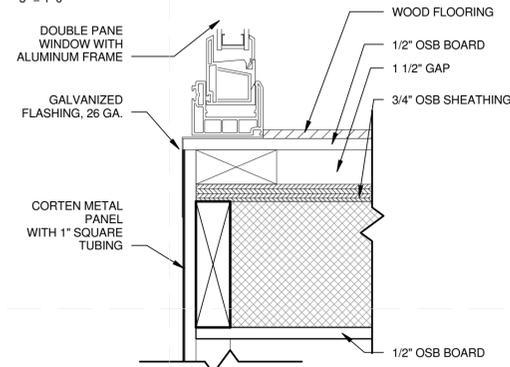


C2 BEDROOM SILL DETAIL
3" = 1'-0"

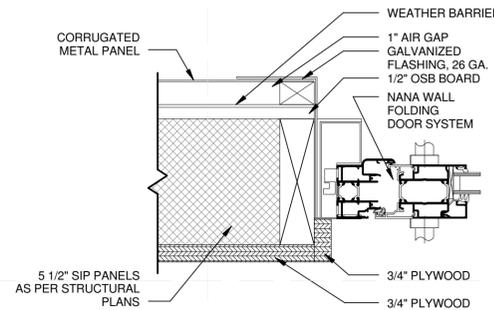


C4 NANA WALL JAMB DETAIL
3" = 1'-0"

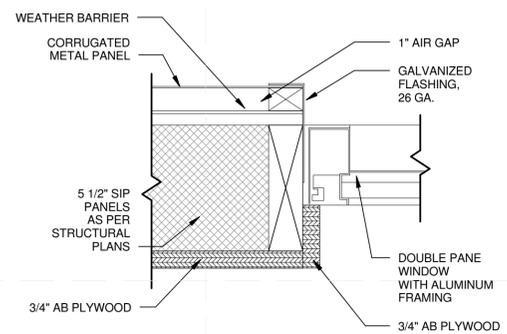

C6 TYPICAL JAMB DETAIL
3" = 1'-0"

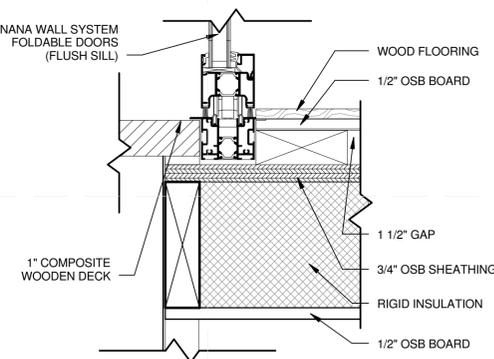

B4 NANA WALL SILL DETAIL
3" = 1'-0"

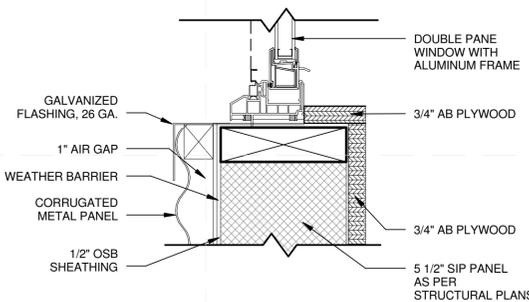

B6 TYPICAL SILL DETAIL
3" = 1'-0"

TEAM NAME: TEAM TEXAS
ADDRESS: ORANGE COUNTY GREAT PARK IRVINE, CALIFORNIA LOT #106
CONTACT: ASMARSHALL@UTEP.EDU SOLARDECATHLON.UTEP.EDU

CONSULTANTS

CLIENT
U.S. DEPARTMENT OF ENERGY
SOLAR DECATHLON 2013
WWW.SOLARDECATHLON.GOV





01	10/11/2012	80% DCENR DD SUBMISSION
02	11/20/2012	80% DCENR DD RE-SUBMISSION
03	02/14/2013	95% DCENR CD SUBMISSION
03	04/05/2013	95% DCENR RE-SUBMISSION

MARK	DATE	DESCRIPTION
------	------	-------------


LOT NUMBER: #106
DRAWN BY: Author
CHECKED BY: Checker
COPYRIGHT: NONE: PROJECT IS PUBLIC DOMAIN

SHEET TITLE
WINDOW DETAILS


A-531

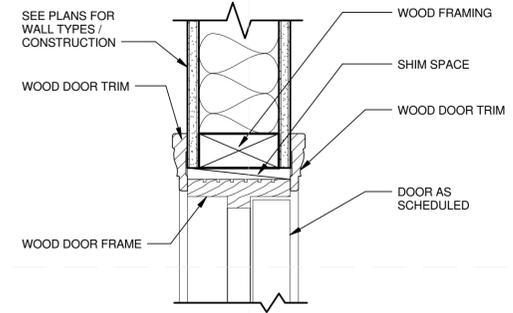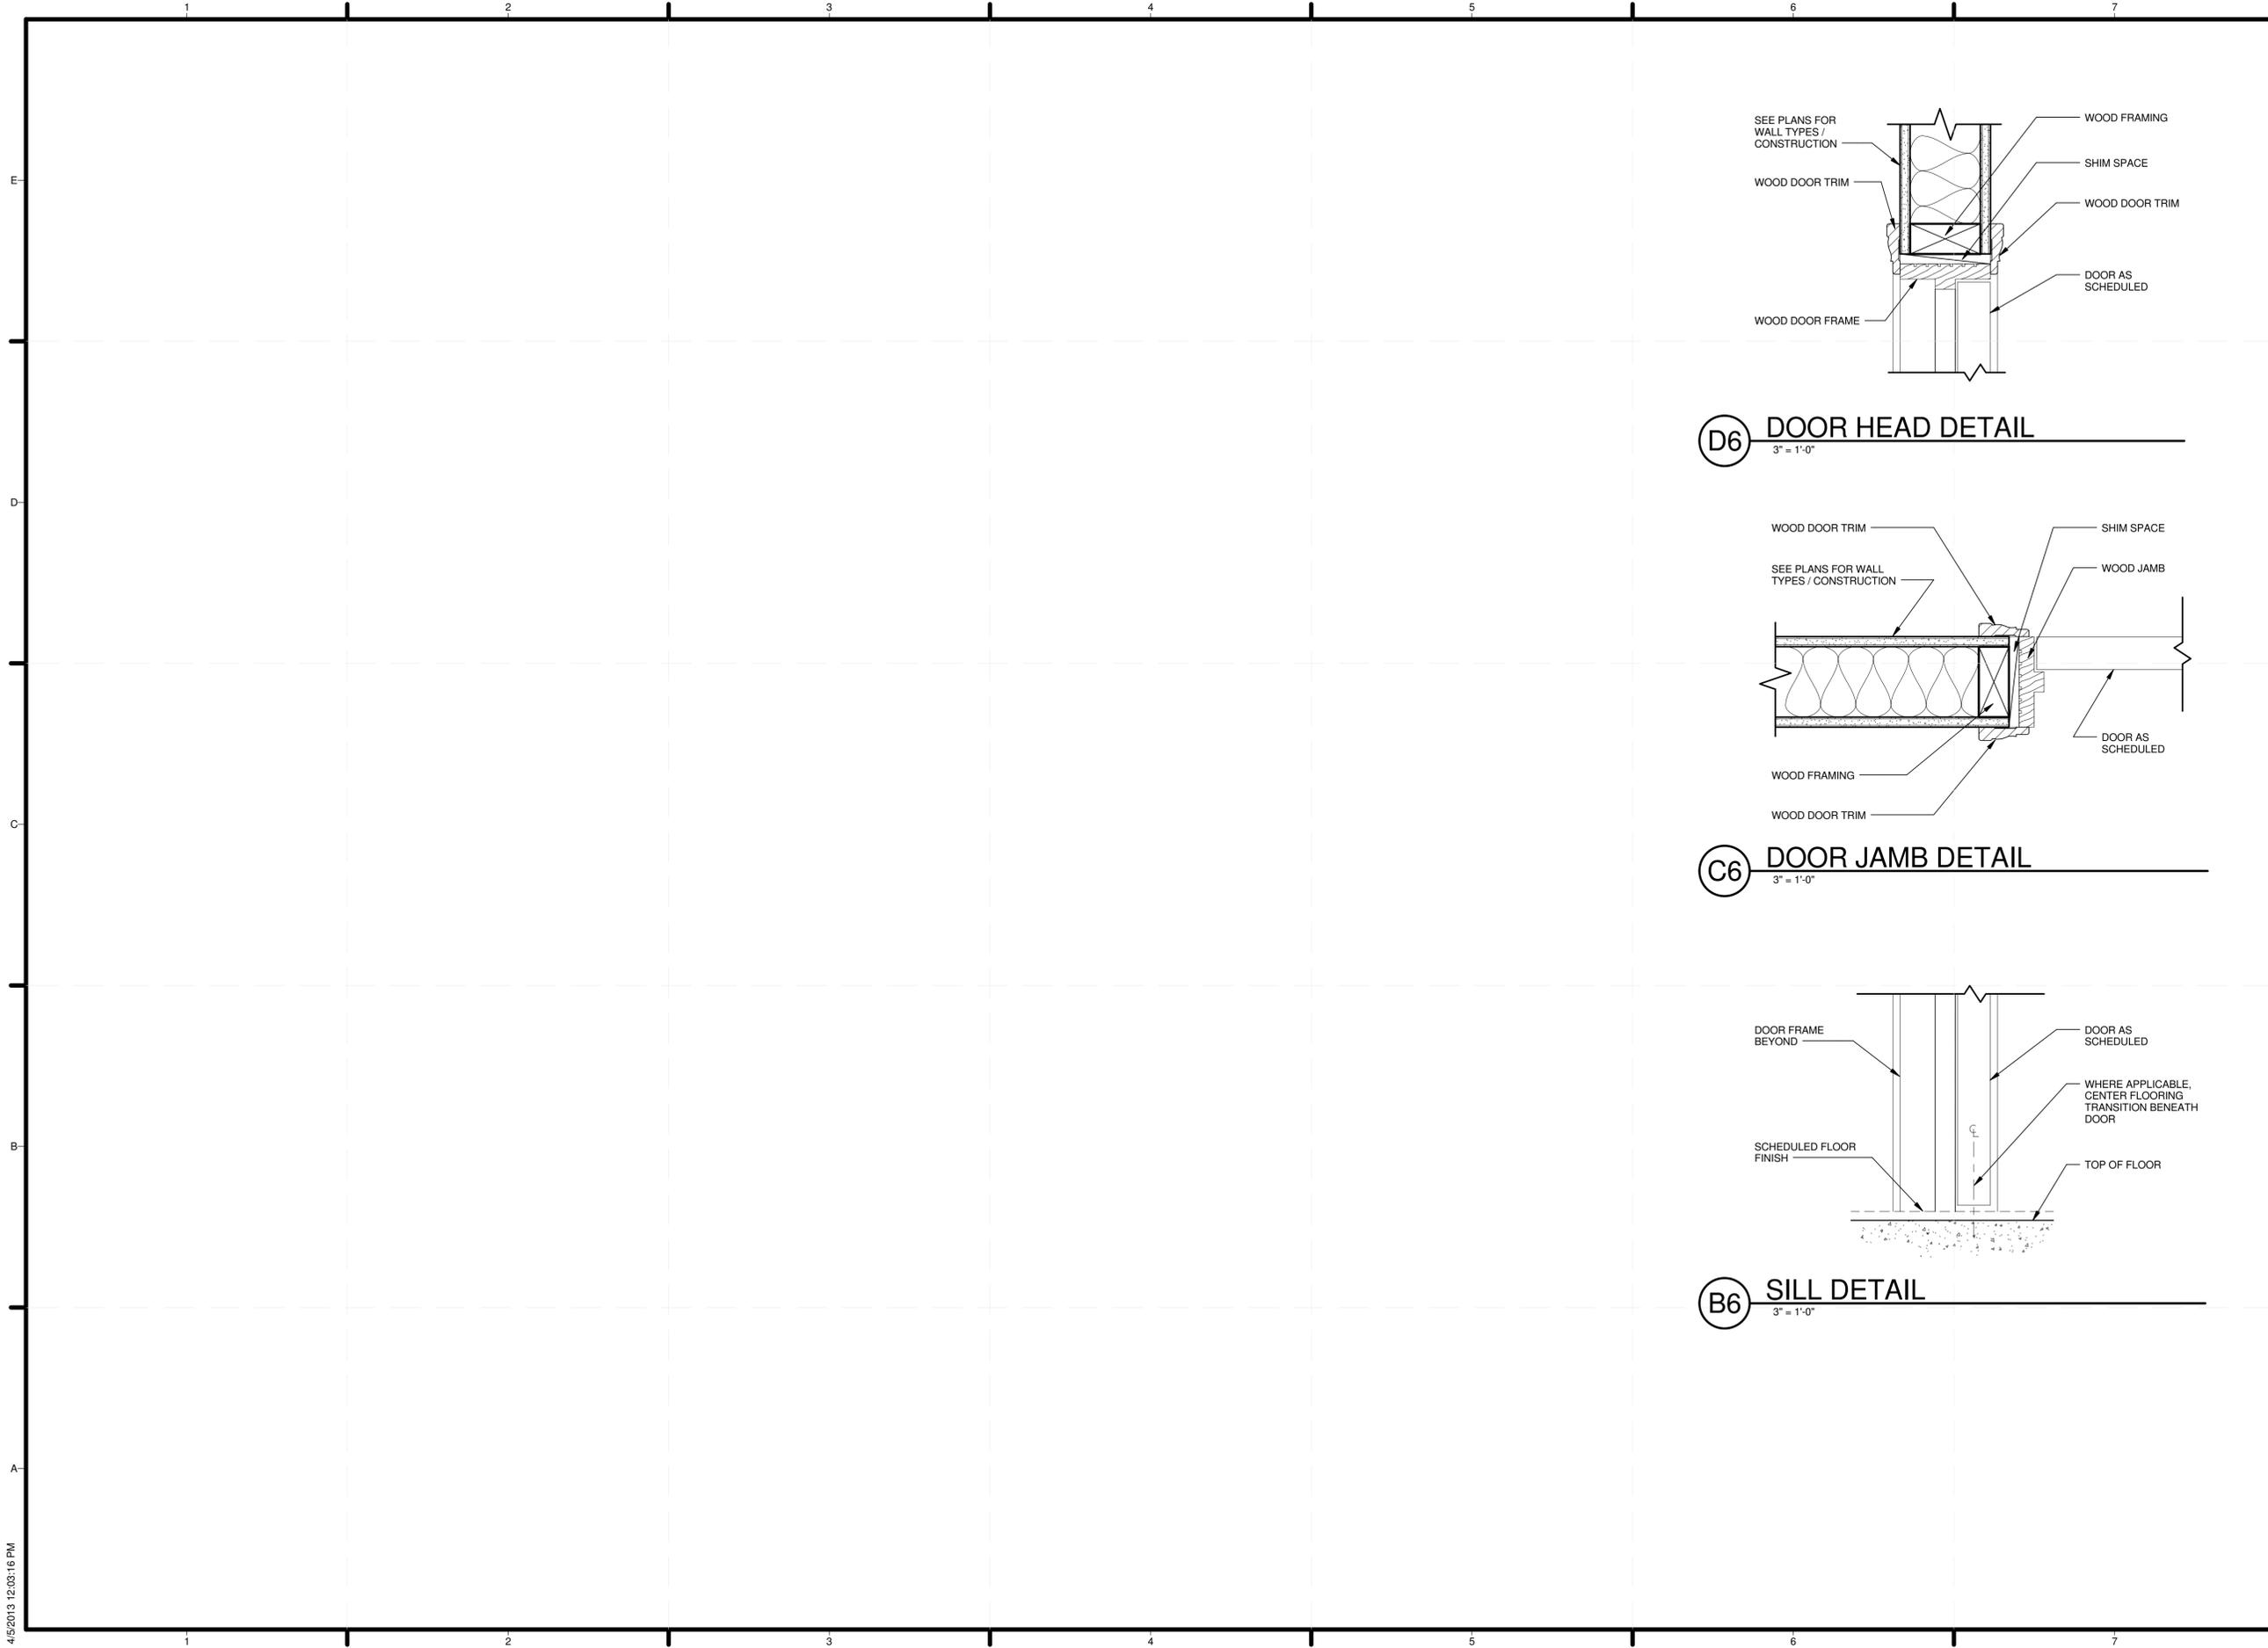

D6 DOOR HEAD DETAIL
3" = 1'-0"

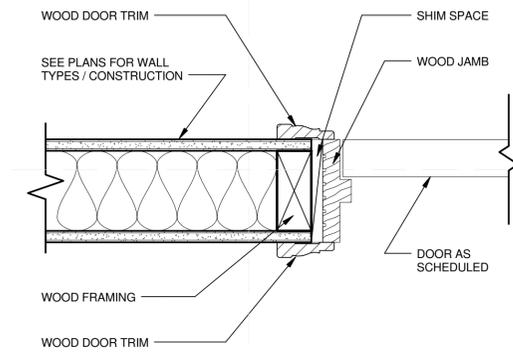

C6 DOOR JAMB DETAIL
3" = 1'-0"

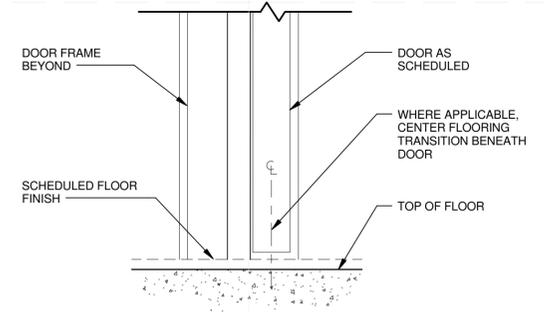

B6 SILL DETAIL
3" = 1'-0"



TEAM NAME: TEAM TEXAS
 ADDRESS: ORANGE COUNTY GREAT PARK
 IRVINE, CALIFORNIA
 LOT #106
 CONTACT: ASMARSHALL@UTEP.EDU
 SOLARDECATHLON.UTEP.EDU

CONSULTANTS



CLIENT
 U.S. DEPARTMENT OF ENERGY
 SOLAR DECATHLON 2013
 WWW.SOLARDECATHLON.GOV



01	10/11/2012	80% DCENR DD SUBMISSION
02	11/20/2012	80% DCENR DD RE-SUBMISSION
03	02/14/2013	95% DCENR CD SUBMISSION
03	04/05/2013	95% DCENR RE-SUBMISSION

MARK	DATE	DESCRIPTION
------	------	-------------

LOT NUMBER: #106
 DRAWN BY: Author
 CHECKED BY: Checker
 COPYRIGHT: NONE: PROJECT IS PUBLIC DOMAIN

SHEET TITLE
DOOR DETAILS

A-532

TEAM NAME: TEAM TEXAS
 ADDRESS: ORANGE COUNTY GREAT PARK
 IRVINE, CALIFORNIA
 LOT #106
 CONTACT: ASMARSHALL@UTEP.EDU
 SOLARDECATHLON.UTEP.EDU

CONSULTANTS

CLIENT
 U.S. DEPARTMENT OF ENERGY
 SOLAR DECATHLON 2013
 WWW.SOLARDECATHLON.GOV



01	10/11/2012	80% DOE/NR DD SUBMISSION
02	11/20/2012	80% DOE/NR DD RE-SUBMISSION
03	02/14/2013	95% DOE/NR CD SUBMISSION
03	04/05/2013	95% DOE/NR RE-SUBMISSION


MARK	DATE	DESCRIPTION
------	------	-------------

LOT NUMBER: #106
 DRAWN BY: AUTHOR
 CHECKED BY: CHECKER
 COPYRIGHT: NONE: PROJECT IS PUBLIC DOMAIN

SHEET TITLE


SCHEDULES

A-601

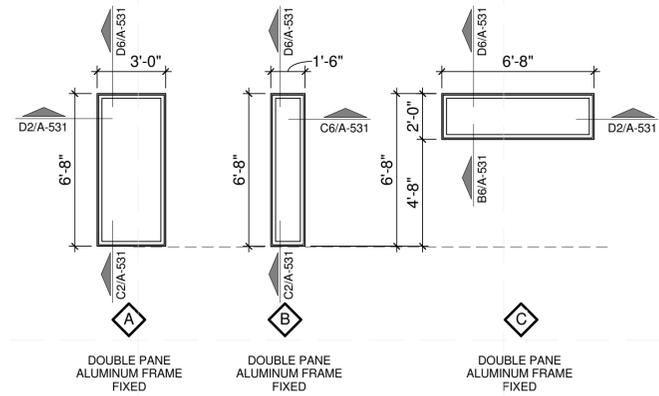

WINDOW LEGEND


1/4" = 1'-0"

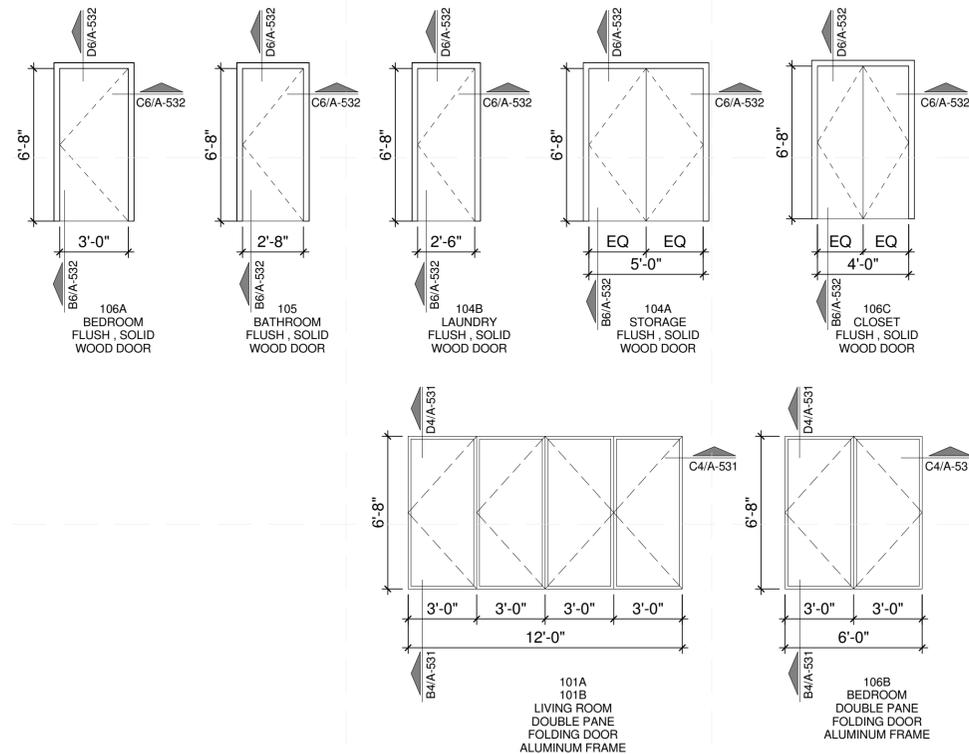

DOOR LEGEND

1/4" = 1'-0"

ROOM FINISH SCHEDULE						
ROOM NO	ROOM NAME	FINISH				COMMENTS
		FLOOR	BASE	WALL	CEILING	
101	LIVING ROOM	WOOD FLOOR	WOOD	PLYWOOD FINISHED / METAL DECK	PLYWOOD FINISHED	CLNG.HEIGHT VARIES
102	KITCHEN / DINING	WOOD FLOOR	WOOD	PLYWOOD FINISHED	PLYWOOD FINISHED	CLNG.HEIGHT VARIES
103	MECH. ROOM	COMPOSITE DECK	WOOD	METAL PANELS	PLYWOOD FINISHED	CLNG.HEIGHT VARIES
104	CORRIDOR	WOOD FLOOR	WOOD	PLYWOOD FINISHES	PLYWOOD FINISHED	CLNG.HEIGHT VARIES
105	BATH	TILE	WOOD	TILE / PLYWOOD FINISHED	PLYWOOD FINISHED	CLNG.HEIGHT VARIES
106	BEDROOM	WOOD FLOOR	WOOD	PLYWOOD FINISHED / WOOD PLANKS	PLYWOOD FINISHED	CLNG.HEIGHT VARIES

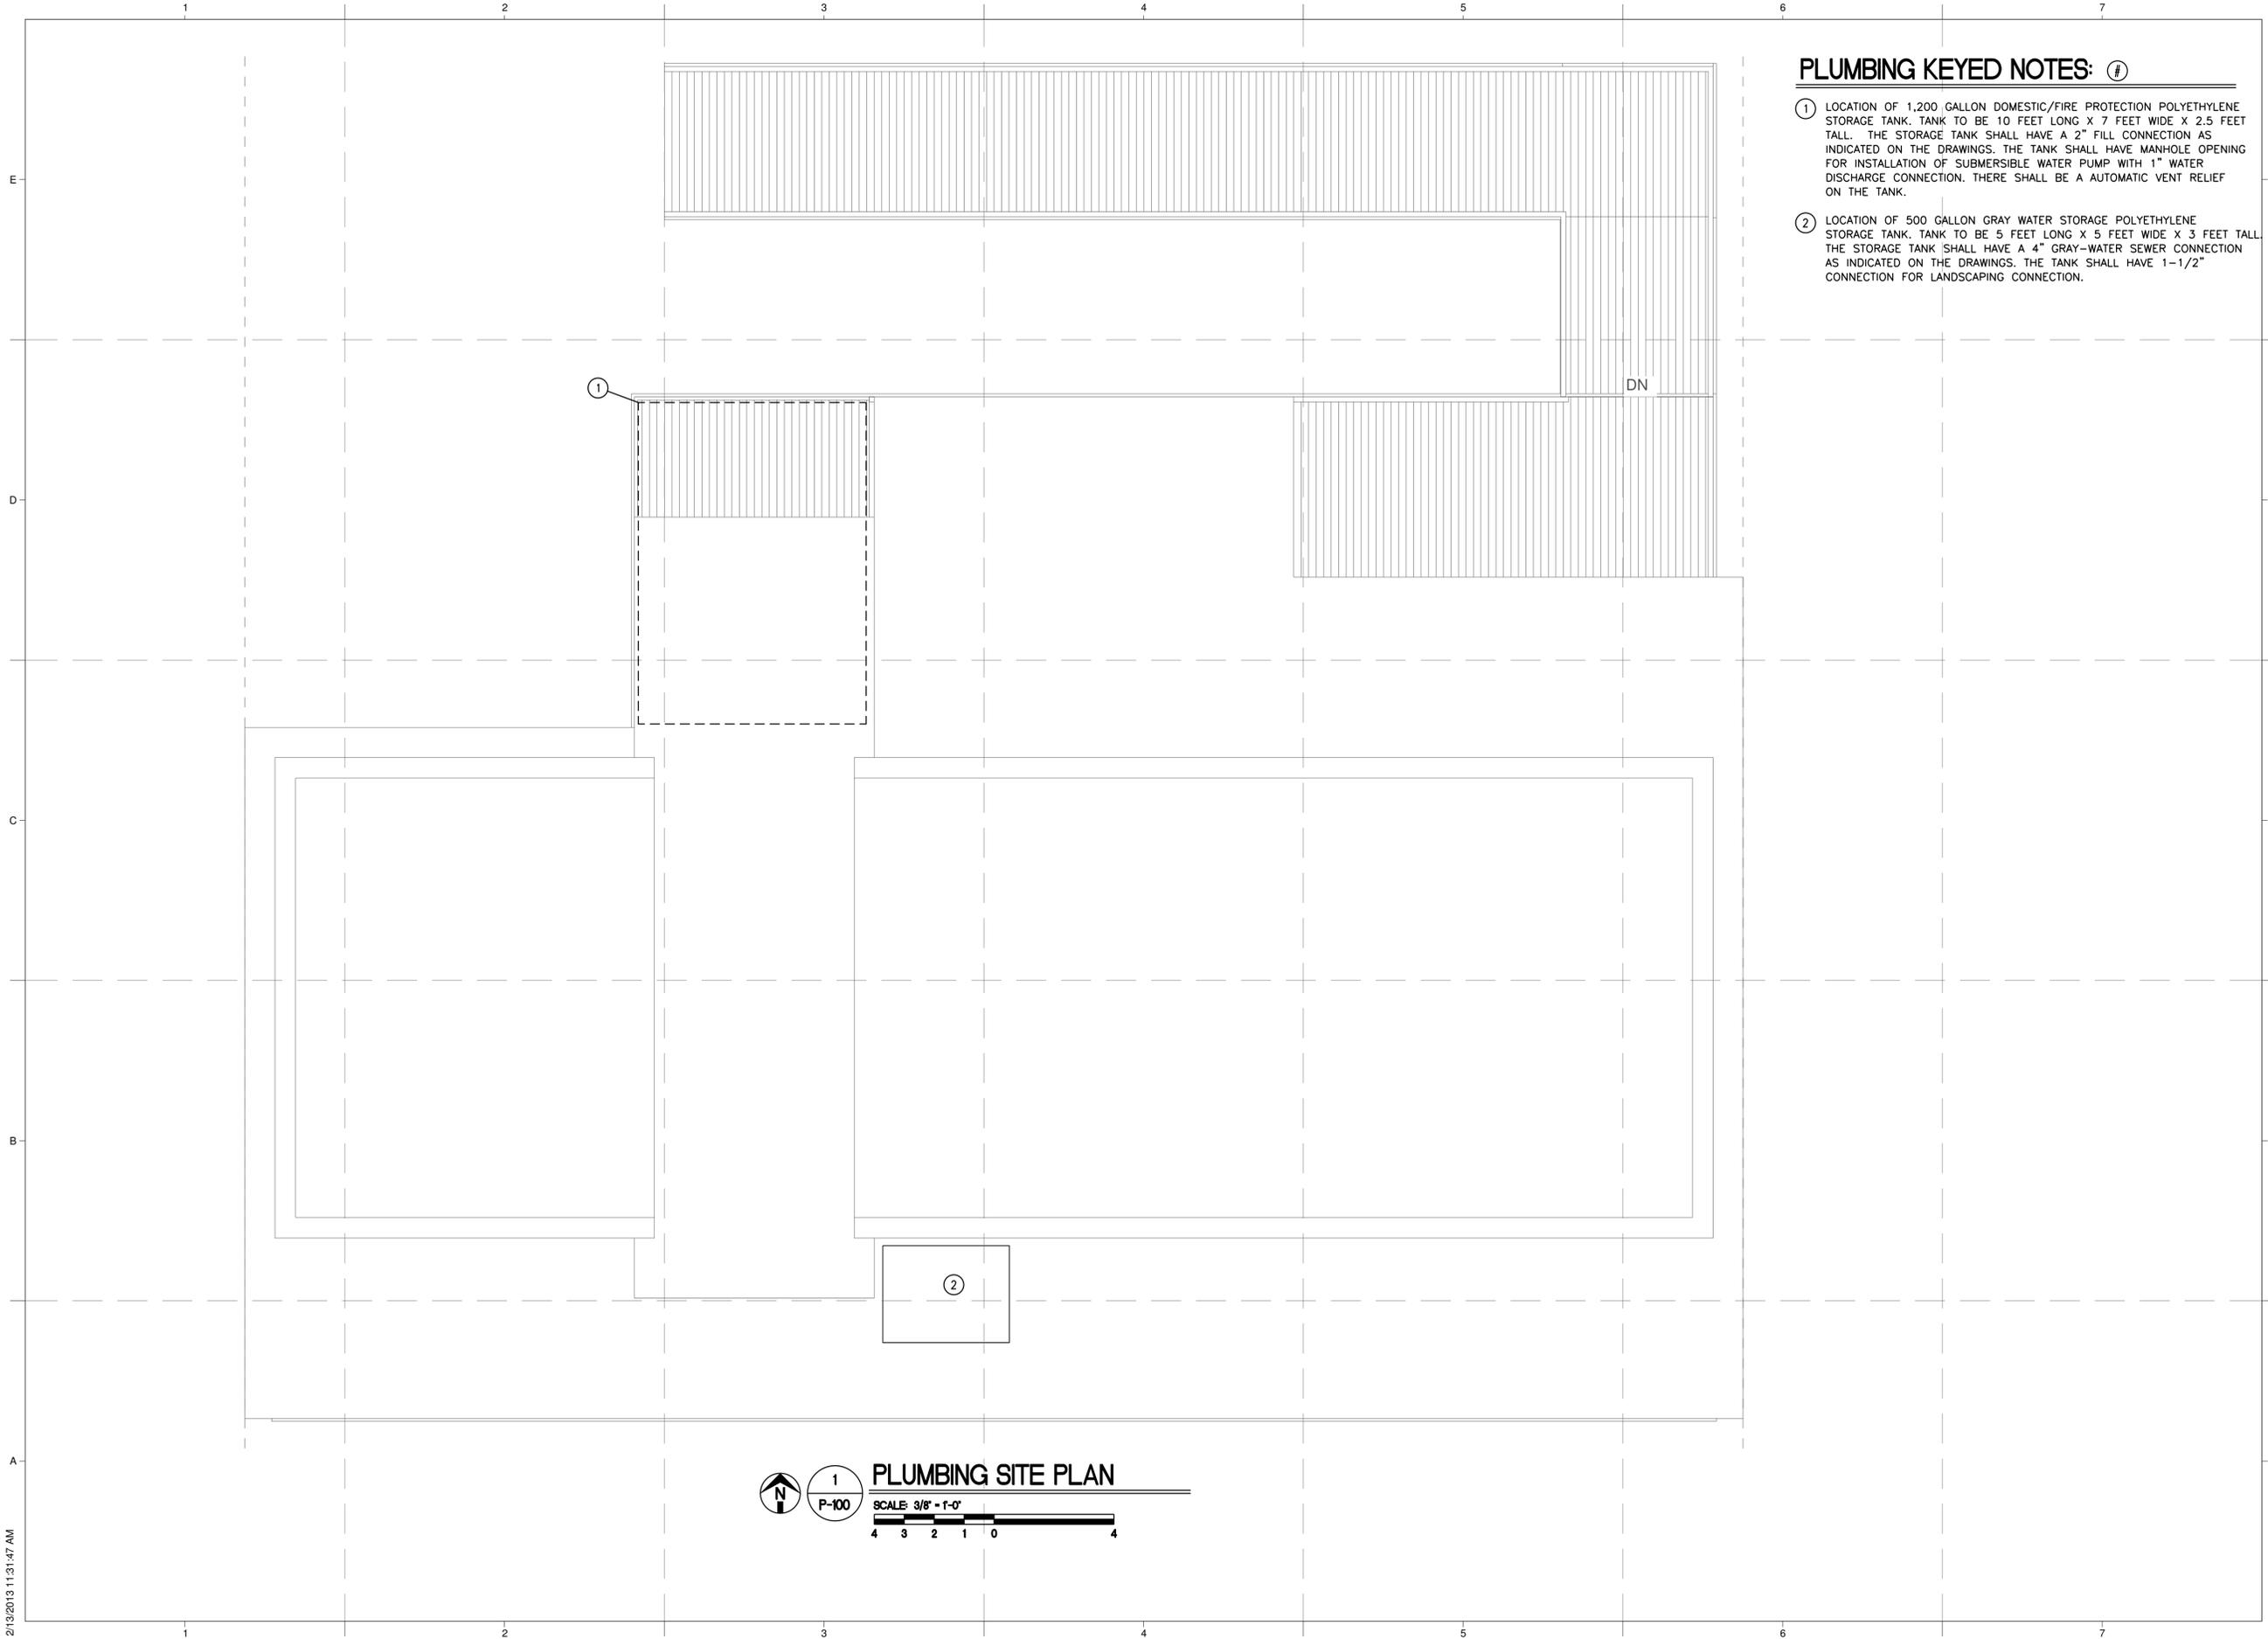

PLUMBING KEYED NOTES: ①

- ① LOCATION OF 1,200 GALLON DOMESTIC/FIRE PROTECTION POLYETHYLENE STORAGE TANK. TANK TO BE 10 FEET LONG X 7 FEET WIDE X 2.5 FEET TALL. THE STORAGE TANK SHALL HAVE A 2" FILL CONNECTION AS INDICATED ON THE DRAWINGS. THE TANK SHALL HAVE MANHOLE OPENING FOR INSTALLATION OF SUBMERSIBLE WATER PUMP WITH 1" WATER DISCHARGE CONNECTION. THERE SHALL BE A AUTOMATIC VENT RELIEF ON THE TANK.
- ② LOCATION OF 500 GALLON GRAY WATER STORAGE POLYETHYLENE STORAGE TANK. TANK TO BE 5 FEET LONG X 5 FEET WIDE X 3 FEET TALL. THE STORAGE TANK SHALL HAVE A 4" GRAY-WATER SEWER CONNECTION AS INDICATED ON THE DRAWINGS. THE TANK SHALL HAVE 1-1/2" CONNECTION FOR LANDSCAPING CONNECTION.



TEAM NAME: TEAM TEXAS
 ADDRESS: ORANGE COUNTY GREAT PARK
 IRVINE, CALIFORNIA
 LOT #106
 CONTACT: ASMARSHALL@UTEP.EDU
 SOLARDECATHLON.UTEP.EDU

CLIENT
 U.S. DEPARTMENT OF ENERGY
 SOLAR DECATHLON 2013
 WWW.SOLARDECATHLON.GOV




01	10/11/2012	80% DOENR DD SUBMISSION
02	11/20/2012	80% DOENR DD RE-SUBMISSION
03	02/14/2013	95% DOENR CD SUBMISSION
03	04/05/2013	95% DOENR RE-SUBMISSION

MARK	DATE	DESCRIPTION
LOT NUMBER:	#106	
DRAWN BY:	TEAM TEXAS	
CHECKED BY:	CONSULTANTS	
COPYRIGHT:	NONE; PROJECT IS PUBLIC DOMAIN	

SHEET TITLE
PLUMBING SITE PLAN AND PLUMBING KEYED NOTES

P-100

1
 P-100
 SCALE: 3/8" = 1'-0"
 4 3 2 1 0 4

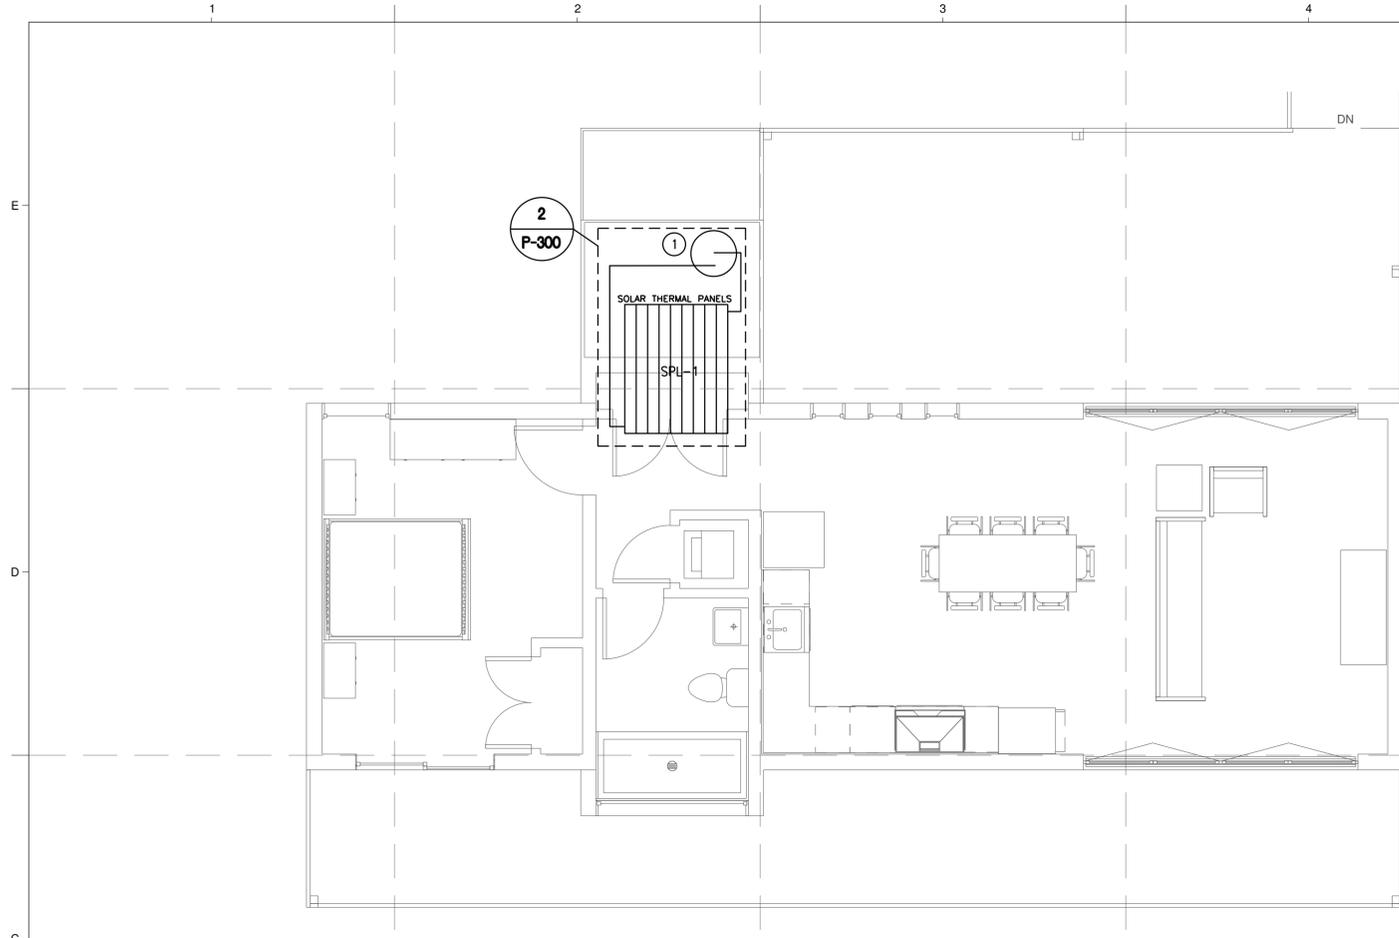

1 PLUMBING SOLAR SYSTEM FLOOR PLAN
 SCALE: 1/4" = 1'-0"
 P-300

PLUMBING KEYED NOTES:

- 1 WATER HEATER (WH-1) AT FLOOR IN TOWER OF POWER PER SCHEMATIC 2/P-400, REFER TO SOLAR DRAWINGS FOR ADDITIONAL PIPING INFORMATION.

SOLAR SYSTEM SCHEDULE	
SOLAR COLLECTOR	SOL
DESIGNATION	SPL-1
TYPE	HEAT PIPE EVACUATED TUBE
SIZE	80"H X 86"W X 6"D
NUMBER OF PANELS	1
NUMBER OF TUBES PER PANEL	30
TUBE DIAMETER AND LENGTH	2.28" DIA X 80"
MINIMUM PANEL CAPACITY BTUH/DAY	43,000
PUMPING SYSTEM	SOL-1
MOUNTING	IN-LINE
CONNECTION SIZES (IN)	3/4"
FLOW (GPM)	5
TOTAL DEVELOPED HEAD (FT)	20
SPEED (RPM)	1750
MOTOR HORSEPOWER	1/3
ELECTRICAL POWER	120V /1P
PANEL WEIGHT (LB)	300
CINCO SOLAR MODEL	CS-03-BS

- NOTES**
- SOLAR COLLECTOR SYSTEM ARE SCHEDULED TO BE BY CINCO SOLAR, INC. ALL OTHER SYSTEMS REQUIRE PRIOR APPROVAL OF THE ENGINEER.
 - PROVIDE HIGH ANGLE FRAME KIT AND ASSOCIATED SUPPORT FRAMING.
 - SOLAR SYSTEM TO BE MOUNTED ON STRUCTURAL CANOPY, COORDINATE INSTALLATION WITH GENERAL CONTRACTOR.
 - PANEL TO BE MOUNTED AT 35 DEGREE ELEVATION FROM HORIZONTAL FACING SOUTH.
 - CONTRACTOR TO PROVIDE PIPING, INSULATION, AND VALVES AS REQUIRED FOR A COMPLETE SYSTEM.
 - REFER TO SOLAR SPECIFICATIONS FOR FURTHER INFORMATION.
 - PROVIDE CHECKOUT AND STARTUP WITH CHECK-OUT AND START-UP SERVICES FROM AN AUTHORIZED SOLAR SYSTEM MANUFACTURER'S REPRESENTATIVE.



TEAM NAME: TEAM TEXAS
 ADDRESS: ORANGE COUNTY GREAT PARK
 IRVINE, CALIFORNIA
 LOT #106
 CONTACT: ASMARSHALL@UTEP.EDU
 SOLARDECATHLON.UTEP.EDU

CLIENT
 U.S. DEPARTMENT OF ENERGY
 SOLAR DECATHLON 2013
 WWW.SOLARDECATHLON.GOV




MARK	DATE	DESCRIPTION
01	10/11/2012	80% DOE/NR DD SUBMISSION
02	11/20/2012	80% DOE/NR DD RE-SUBMISSION
03	02/14/2013	95% DOE/NR CD SUBMISSION
03	04/05/2013	95% DOE/NR RE-SUBMISSION

LOT NUMBER: #106
 DRAWN BY: TEAM TEXAS
 CHECKED BY: CONSULTANTS
 COPYRIGHT: NONE; PROJECT IS PUBLIC DOMAIN

SHEET TITLE
PLUMBING SOLAR SYSTEM FLOOR PLAN, SOLAR RISER DIAGRAM, SOLAR SCHEDULES AND SCHEMATICS

P-300

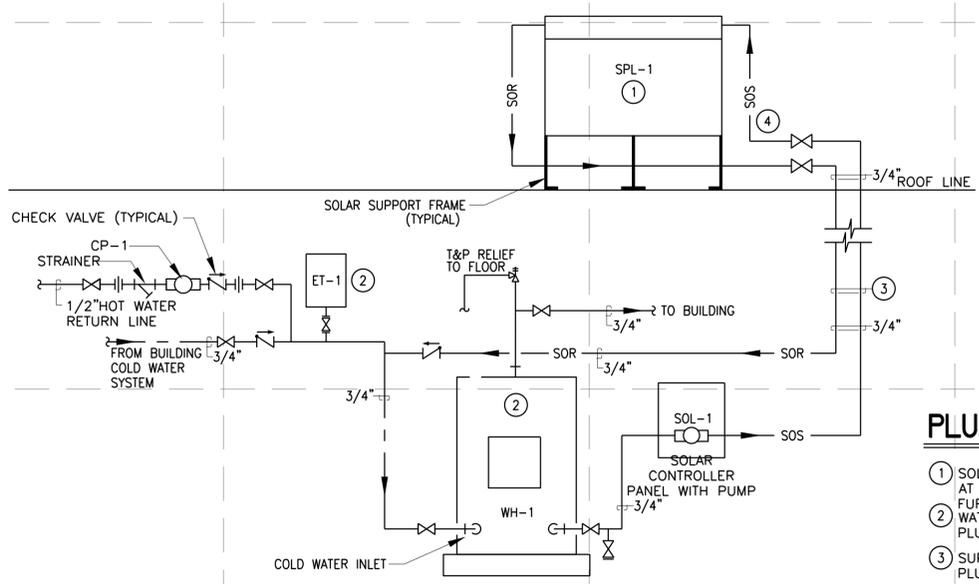

2 W.H./SOLAR INSTALLATION SCHEMATIC
 SCALE: NONE
 P-300


PLUMBING NOTES:

- SOLAR PANEL MOUNTED ON ADJUSTABLE SOLAR SUPPORT FRAME SET AT 35 DEGREES FROM HORIZONTAL. REFER TO SPECIFICATION FOR FURTHER INFORMATION.
- WATER HEATER (WH-1) AND EXPANSION TANK (ET-1), REFER TO PLUMBING DRAWINGS FOR FURTHER INFORMATION.
- SUPPORT PIPING FROM STRUCTURE PER SPECIFICATIONS, REFER TO PLUMBING DRAWINGS FOR FURTHER INFORMATION.
- SUPPORT PIPING FROM SOLAR SYSTEM STRUCTURE PER SPECIFICATIONS, REFER TO PLUMBING DRAWINGS FOR FURTHER INFORMATION.


MINIMUM CONNECTIONS					TYPE	FIXTURE	MANUFACTURER	OPTIONS
SYMBOL	CW	HW-110	VENT	WASTE				
WC-1	1/2"	--	2"	4"	FLOOR MOUNTED TANK TYPE GRAVITY FLUSH ADA COMPLIANT WATER CLOSET ELONGATED CHINA BOWL, EXTRA HEAVY DUTY OPEN FRONT WHITE SEAT, BOTTOM OUTLET, 1.6 GALLON PER FLUSH, FLUSH LEVER ON RIGHT WHERE REQUIRED.	SEAT - BEMIS 1655SSC, CHURCH 9500SSC, CENTOCO 1500CCSS, BENEKE 527SS, KOHLER K4666SC		
LAV-1	1/2"	1/2"	1-1/2"	1-1/2"	WALL MOUNTED ADA COMPLIANT LAVATORY VITREOUS CHINA, NOMINAL 20"x18", BACK AND SIDE SPLASHES, FOR CONCEALED ARM CARRIER, SINGLE CENTERED FAUCET HOLE, ADA COMPLIANT SINGLE LEVER FAUCET, LESS ESCUTCHEON PLATE, LESS DRAIN, CAST BRASS CONSTRUCTION, WATER LESS, DRAIN OUTLET WITH POP-UP WASTE	ELJER 051-2644 DELWYN AMER. STD 0356.421 LUCERNE KOHLER K-2007 KINGSTON CRANE 1-412H ZURN	FAUCET - ZURN Z-82200 AQUASPEC, CHICAGO 2200 CARRIER - ZURN Z-1231, OR EQUAL BY WADE, JR SMITH DRAIN - AMER. STD. 2411.015, ELJER 803-0552	
S-1	1/2"	1/2"	1-1/2"	1-1/2"	COUNTERTOP SINGLE DEEP COMPARTMENT 18 GA. STAINLESS STEEL, NOM. 16" x 22" BOWL, 10" DEEP, BACK FLANGE, WIDEST GOOSENECK FAUCET WITH HOLES 4" ON CENTER, LEVER HANDLE, DRAIN OUTLET WITH GRID STRAINER	JUST SLX-2225-A-GR ELKAY DLR252210	FAUCET - CHICAGO FAUCET #786-369, ZURN Z-831B4 AQUASPEC DRAIN - J-35-316	
SH-1	3/4"	3/4"	--	--	HANDICAPPED ADA COMPLIANT SHOWER ASSEMBLY HAND SPRAY SHOWER UNIT, PRESSURE BALANCING MIXING VALVE W/ INTEGRAL VOLUME CONTROL AND ADJUSTABLE STOP SCREW. BALANCING PISTON SEALED OPERATING SPINDLE, INTEGRAL STOPS, CLEAR-FLO 2.5 GPM SHOWER HEAD WITH ARM & FLANGE, WALL/HAND SHOWER W/ 5' FLEX METAL HOSE, WALL CONNECTION & FLANGE, IN-LINE VACUUM BREAKER, 30" SLIDE BAR FOR HAND SHOWER MOUNTING, POLISHED CHROME FINISH.	SYMMONS S-96-300X-B30-L-V		
SA-1	3/4"	3/4"	--	--	SHOCK ABSORBER STAINLESS STEEL NESTED BELLOWS TYPE. CASING & BELLOWS SHALL BE TYPE 304 STAINLESS STEEL. PROVIDE ISOLATION BALL VALVE WITH ACCESS DOOR (IF REQUIRED) AT INLET. CONTRACTOR SHALL SIZE EACH UNIT FOR PROPER DISPLACEMENT FOR THE FIXTURES COUNT ON CW OR HW LINE AS REQUIRED AT LOCATION SHOWN.	ZURN Z-1700 SHOCKTROLS JR SMITH 5000 HYDROTROLS WADE PRECISION PRODUCTS		
WM-1	3/4"	3/4"	--	2"	WASHING MACHINE CONNECTION AUTOMATIC WASHING MACHINE VALVE ASSEMBLY WITH 1/2" SWEAT UNION ELL CONNECTIONS AND 2" DRAIN CONNECTION. VALVE ASSEMBLY SHALL HAVE TRIPLE SEAL PACKING, SELF ADJUSTING SPRING LOADED, NON-WEAR ACTION. VALVES TO BE HOUSED IN A METAL OR PLASTIC ENCLOSURE	SYMMONS W-602	THE WASHING MACHINE CONNECTION IS TO CONNECT TO A MINIMUM 3 INCH WASTE MAIN IN THE WALL PER SCHEMATIC.	
FD-1	--	--	2"	3"	FLOOR DRAIN 6" ROUND ADJUSTABLE NICKEL BRONZE STRAINER, CAST IRON BODY, SEDIMENT BUCKET, ADJUSTABLE FLASHING COLLAR, 3/4" TRAP PRIMER ADAPTER	ZURN ZN-415-B-P JR SMITH 2005	PROVIDE TRAP PRIMER ADAPTER - ZURN-1023 OR EQUAL	
WCO	--	--	--	AS SHOWN ON DWG	WALL CLEANOUT NO-HUB CAST IRON CLEANOUT TEE WITH ROUND STAINLESS STEEL COVER AND CENTER SCREW, GASKETED SEAL IRON THREADED PLUG WITH RECESSED SOCKET	ZURN Z-1446-BP, JR SMITH 4422-PB	OR EQUAL BY WADE	
ECO DCO	--	--	--	AS SHOWN ON DWG	EXTERIOR CLEANOUT CAST IRON CLEANOUT WITH ROUND ADJUSTABLE SCORATED SECURED CAST IRON TOP, GASKET SEAL CAST IRON PLUG WITH RECESSED SOCKET. INSTALL IN MINIMUM OF 12" x 12" x 4" REINFORCED CONCRETE PAD WITH BEVELED EDGES.	ZURN Z-1400-HD	OR EQUAL BY JR SMITH OR WADE	

NOTES:


- MANUFACTURERS WITH MODEL NUMBERS ARE BASE ITEMS. OTHER MANUFACTURERS LISTED ARE EQUIVALENT MANUFACTURERS.
- FOR MOUNTING HEIGHTS OF INDIVIDUAL WALL-MOUNTED FIXTURES, REFER TO ARCHITECTURAL ELEVATION DRAWINGS.
- EACH UNDERSLAB OR CONCEALED P-TRAP SHALL BE A DEEP-SEAL TYPE.
- PROVIDE EACH WALL MOUNTED PLUMBING FIXTURE, SUCH AS SINKS, LAVATORIES, ELECTRIC WATER COOLERS, DRINKING FOUNTAINS, ETC., WITH A FLOOR MOUNTED FIXTURE SUPPORT CARRIER WITH RECTANGULAR LEGS.
- UNLESS SCHEDULED OTHERWISE, PROVIDE EACH LAVATORY, SINK, WATER COOLER, ETC. WITH A P-TRAP ASSEMBLY CONSISTING OF A CHROME-PLATED (C.P.) CAST BRASS TRAP WITH CLEANOUT PLUG, C.P. TUBING OUTLET (MIN. 17 GA.), AND C.P. CAST BRASS ESCUTCHEON WITH SETSCREW.
- PROVIDE EACH FIXTURE WHICH REQUIRES COLD AND/OR HOT WATER (EXCEPT FLUSH VALVES) WITH A SUPPLY/STOP ASSEMBLY CONSISTING OF A C.P. BRASS QUARTER TURN STOP VALVE (MIN. 1/2") WITH LOOSE KEY HANDLE AND LOCK SHIELD, STAINLESS STEEL FLEXIBLE RISER, C.P. BRASS NIPPLE, AND C.P. CAST BRASS ESCUTCHEON WITH SETSCREW.
- FOR EACH PUBLIC LAVATORY OR SINK WITH EXPOSED DRAIN AND BOTH COLD AND HOT SUPPLY COMPONENTS, PROVIDE A MANUFACTURED INSULATION KIT MADE FROM MOLDED CLOSED CELL VINYL THAT IS ANTI-MICROBIAL, FORM FITTING, AND SEAMLESS. EACH KIT SHALL COVER THE TAILPIECE, P-TRAP, WALL BEND, BOTH WATER SUPPLY STOPS, AND BOTH WATER RISERS. KITS SHALL BE EQUAL OR EQUIVALENT TO "PROWRAP" BY MCGUIRE OR LAV-GUARD BY TRUEBRO.
- ALL ITEMS SHALL BE NSF APPROVED AND LISTED FOR THEIR USAGE. ALL FAUCETS, WATER COOLERS, AND DRINKING FOUNTAINS SHALL BE TO NSF 61 AND LISTED WITH NSF.
- PROVIDE ACCESS DOORS FOR ANY CONCEALED VALVES, SHOCK ABSORBERS, AIR GAP FITTINGS AND ANY OTHER CONCEALED FIXTURES THAT REQUIRED MAINTENANCE.
- WHERE ARCHITECTURAL PLANS SHOW WATER CLOSETS AND URINALS, PROVIDE AND INSTALL FLUSHING VALVE SUCH THAT FLUSH HANDLE IS ON WIDE SIDE OF WATER CLOSET, THAT IS, THE SIDE AWAY FROM THE ADJACENT WALL. ALL WALL MOUNTED FIXTURES SHALL BE MOUNTED AT THE REQUIRED ADA AND TAS MOUNTING HEIGHTS IN ACCORDANCE WITH THE ARCHITECTURAL DRAWINGS.

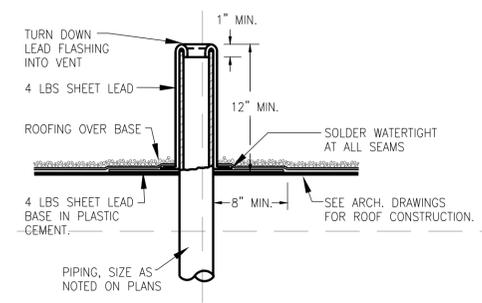


1 VENT THRU ROOF SCHEMATIC
SCALE: NONE

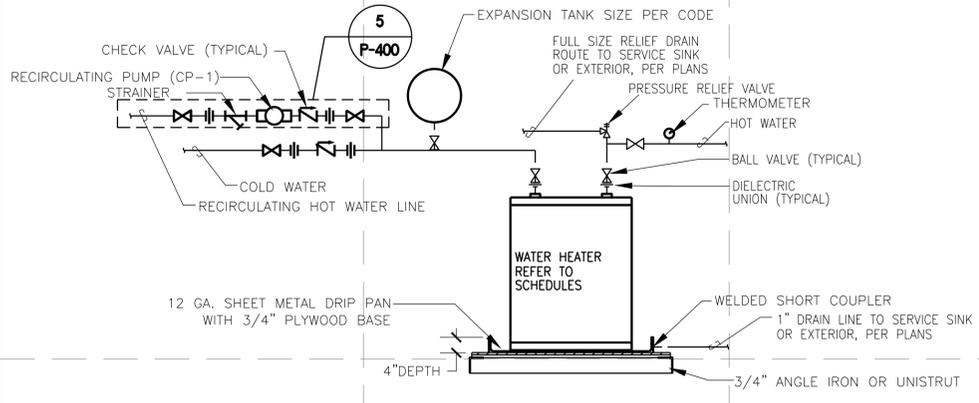


2 W.H. INSTALLATION SCHEMATIC
SCALE: NONE

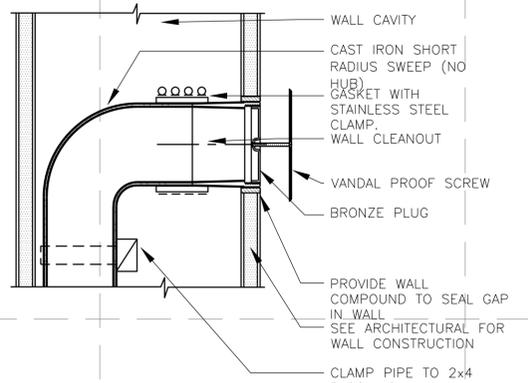

3 WALL CLEANOUT SCHEMATIC
SCALE: NONE

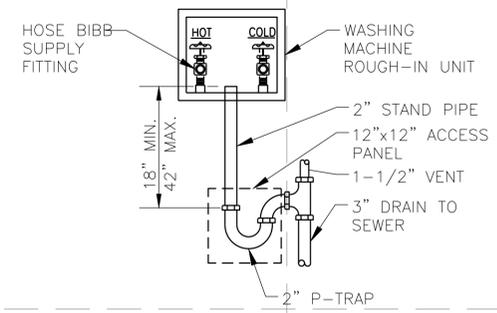

4 WASHING MACHINE HOOKUP SCHEMATIC
SCALE: NONE

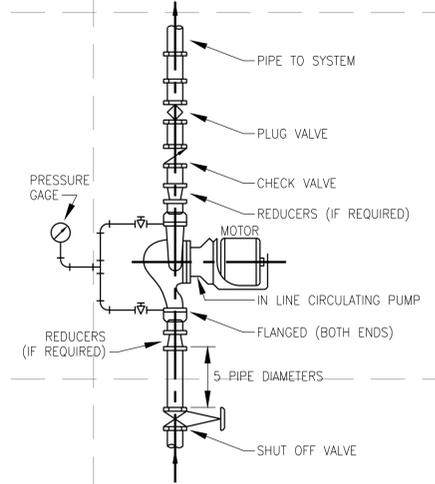

5 CIRCULATION PUMP DETAIL
SCALE: NONE

TEAM NAME:	TEAM TEXAS
ADDRESS:	ORANGE COUNTY GREAT PARK IRVINE, CALIFORNIA LOT #106
CONTACT:	ASMARSHALL@UTEP.EDU SOLARDECATHLON.UTEP.EDU

CLIENT	U.S. DEPARTMENT OF ENERGY SOLAR DECATHLON 2013 WWW.SOLARDECATHLON.GOV
U.S. DEPARTMENT OF ENERGY SOLAR DECATHLON	

MARK	DATE	DESCRIPTION
01	10/11/2012	90% DOE/NR DD SUBMISSION
02	11/20/2012	90% DOE/NR DD RE-SUBMISSION
03	02/14/2013	95% DOE/NR CD SUBMISSION
03	04/05/2013	95% DOE/NR RE-SUBMISSION

LOT NUMBER:	#106
DRAWN BY:	TEAM TEXAS
CHECKED BY:	CONSULTANTS
COPYRIGHT:	NONE; PROJECT IS PUBLIC DOMAIN

SHEET TITLE

PLUMBING FIXTURE SCHEDULES AND SCHEMATICS

P-400

MECHANICAL GENERAL NOTES:

GENERAL

1. THESE MECHANICAL GENERAL NOTES ARE APPLICABLE TO ALL MECHANICAL SHEETS IN THIS PROJECT SET.

2. THE MECHANICAL WORK SHALL BE PERFORMED IN STRICT ACCORDANCE WITH THE APPLICABLE AND ADOPTED PROVISIONS OF THE FOLLOWING CODES:
 2012 INTERNATIONAL RESIDENTIAL BUILDING CODE
 2012 INTERNATIONAL ENERGY CONSERVATION CODE
 AS ADOPTED AND INTERPRETED BY THE STATE OF TEXAS, CITY OF EL PASO, DOE SOLAR DECATHALON, AND THE NATIONAL FIRE PROTECTION ASSOCIATION (NFPA) REGULATIONS, CURRENT ADOPTED EDITION REGARDING MECHANICAL SYSTEMS, FIRE PROTECTION AND ALARM SYSTEMS AND ELECTRICAL SYSTEMS. ALL MATERIALS AND LABOR NECESSARY TO COMPLY WITH RULES, REGULATIONS AND ORDINANCES SHALL BE PROVIDED. WHERE THE DRAWINGS INDICATE MATERIALS OR CONSTRUCTION IN EXCESS OF CODE REQUIREMENTS, THE DRAWINGS SHALL GOVERN. THE CONSTRUCTION TEAM SHALL HOLD AND SAVE THE TEAM TEXAS AND DESIGN TEAM FREE AND HARMLESS FROM LIABILITY OF ANY NATURE OR KIND ARISING FROM HIS FAILURE TO COMPLY WITH ALL APPLICABLE CODES AND ORDINANCES.

3. THE CONSTRUCTION TEAM SHALL COORDINATE WITH TEAM TEXAS AND DESIGN TEAM ANY WORK THAT HAS THE POTENTIAL TO HINDER MECHANICAL AND PLUMBING SERVICES TO AREA OUTSIDE OF THIS CONTRACT. ALL SHUT-DOWNS OR TIE-INS RELATING TO THESE SYSTEMS SHALL BE SCHEDULED AND SUBMITTED IN WRITING TO BE APPROVED BY THE TEAM TEXAS AND DESIGN TEAM OFFICE. CONSTRUCTION TEAM SHALL SUBMIT IN WRITING A SCHEDULE FOR PHASING OF CONSTRUCTION THAT INDICATES AREAS OF FIRST PRIORITY DURING EACH PHASE AND ANTICIPATED COMPLETION TIMES. SCHEDULES SHALL BE SUBMITTED A MINIMUM OF ONE WEEK PRIOR TO COMMENCING WORK. TEAM TEXAS AND DESIGN TEAM SHALL REVIEW THESE SCHEDULES AND NOTIFY CONSTRUCTION TEAM OF ACCEPTANCE PRIOR TO COMMENCEMENT OF WORK.

4. ALL MATERIALS AND LABOR NECESSARY TO COMPLY WITH CODES AND RULES, REGULATIONS AND ORDINANCES SHALL BE PROVIDED. WHERE THE DRAWINGS AND/OR SPECIFICATIONS INDICATE MATERIALS OR CONSTRUCTION IN EXCESS OF CODE REQUIREMENTS, THE DRAWINGS AND/OR SPECIFICATIONS SHALL GOVERN. THE CONSTRUCTION TEAM SHALL HOLD AND SAVE THE TEAM TEXAS AND DESIGN TEAM FREE AND HARMLESS FROM LIABILITY OF ANY NATURE OR KIND ARISING FROM HIS FAILURE TO COMPLY WITH ALL APPLICABLE CODES AND ORDINANCES.

5. BIDDERS SHALL VISIT THE SITE AND SHALL BE RESPONSIBLE FOR HAVING ASCERTAINED PERTINENT LOCAL CONDITIONS SUCH AS LOCATION, ACCESSIBILITY AND GENERAL CHARACTER OF THE SITE, THE CHARACTER AND EXTENT OF THE WORK WITHIN THE BUILDING AND TO BECOME FAMILIAR WITH ALL OTHER WORK TO BE PERFORMED AT THIS TIME. NO ADDITIONAL COMPENSATION WILL BE ALLOWED DUE TO CONSTRUCTION TEAM'S FAILURE TO DETERMINE ALL CONDITIONS UNDER WHICH THE WORK IS TO BE PERFORMED.

6. BEFORE YOU DIG ALL EXISTING UTILITIES I.E. WATER, SEWER, GAS, FIRE LINE, ELECTRICITY, TELEPHONE, CABLE, IRRIGATION LINES, SHALL BE LOCATED AND CLEARLY MARKED IN ORDER TO AVOID UNNECESSARY SHUT DOWNS AND EMERGENCY.

7. EACH CONSTRUCTION TEAM SHALL GIVE ALL REQUISITE NOTICES, OBTAIN AND PAY FOR ALL PERMITS, DEPOSITS AND FEES (INCLUDING UTILITY CONNECTIONS FEES, ANY UTILITY EXTENSION FEES, DEVELOPMENT FEES, AND IMPACT FEES) NECESSARY FOR THE INSTALLATION OF WORK UNDER THESE NOTES. TWO (2) COPIES OF CERTIFICATES OF APPROVAL SHALL BE OBTAINED FROM ALL AUTHORITIES ISSUING SAME AND SHALL BE TURNED OVER TO TEAM TEXAS AND DESIGN TEAM PRIOR TO FINAL ACCEPTANCE OF THE WORK.

8. REQUIRED INSURANCE SHALL BE PROVIDED BY THIS CONSTRUCTION TEAM FOR PROTECTION AGAINST PUBLIC LIABILITY AND PROPERTY DAMAGE FOR THE DURATION OF WORK. CONSTRUCTION TEAM SHALL SECURE AND PAY ALL PERMITS, FEES, INSPECTIONS, AND TESTS UNLESS OTHERWISE INDICATED. COORDINATE WITH DESIGN TEAM AND TEAM TEXAS. SUBSTITUTIONS REQUESTED BY THE CONSTRUCTION TEAM SHALL BE PAID FOR BY THE CONSTRUCTION TEAM.

9. ALL WORK SHALL CONFIRM WITH FEDERAL, STATE, AND LOCAL CODES, RULES, AND REGULATIONS. ALL WORK SHALL BE PERFORMED BY A LICENSED CONSTRUCTION TEAM IN A FIRST CLASS WORKMANLIKE MANNER. THE SYSTEMS SHALL BE INSTALLED COMPLETE AND FULLY OPERATIVE UNLESS OTHERWISE INDICATED

10. CONSTRUCTION TEAM SHALL FIELD VERIFY EXISTING CONDITIONS AND PROVIDE A WRITTEN REPORT TO THE DESIGN TEAM OFFICES. THIS REPORT SHALL DESCRIBE EXISTING DAMAGE OR OTHER CONDITIONS THAT MAY INTERFERE WITH THIS PROPOSED NEW WORK. THIS SITE SURVEY SHALL ALSO INCLUDE VERIFICATION OF SIZES, LOCATIONS, AND CONDITIONS OF EXISTING UTILITIES. QUESTIONS REGARDING THESE DRAWINGS SHALL BE ADDRESSED TO THE DESIGN TEAM PRIOR TO THE AWARDED OF THE CONTRACT. OTHERWISE THE DESIGN TEAM'S INTERPRETATION OF THE MEANING AND INTENT OF THE DRAWINGS SHALL BE FINAL.

11. WHERE STRUCTURE IS ALTERED OR DAMAGES DURING CONSTRUCTION, INSTALLATION AND REMOVAL OF EQUIPMENT OR FIXTURES, THE CONSTRUCTION TEAM SHALL REPAIR THE AREA TO MATCH SURROUNDING AREA PER DESIGN TEAM SPECIFICATIONS CUTTING, TRENCHING, AND PENETRATIONS THROUGH FIRE WALL, CONCRETE AND OTHER STRUCTURES ARE A PART OF THIS PROJECT SCOPE AND SHALL BE INCLUDED IN THE CONSTRUCTION TEAM'S BID. ALL EXCAVATION AND BACKFILLING REQUIRED FOR PLUMBING WORK IS ALSO INCLUDED AS PART OF THIS CONTRACT AND SHALL BE INCLUDED IN CONSTRUCTION TEAM'S BID.

11. ALL SYSTEMS AND COMPONENTS SHALL BE APPROVED FOR THE PURPOSE FOR WHICH INSTALLED. ALL EQUIPMENT AND MATERIALS SHALL BE NEW AND FROM ESTABLISHED AMERICAN SUPPLIERS UNLESS OTHERWISE INDICATED.

12. ALL EQUIPMENT PARAMETERS SHOWN ARE FOR PERFORMANCE AT SITE ALTITUDE. SUPPLIERS SHALL SELECT AND DEMONSTRATE THAT THEIR EQUIPMENT MEETS THE DESIGN CONDITIONS AT SITE ALTITUDE.

13. MECHANICAL CONSTRUCTION TEAM SHALL COORDINATE WITH ELECTRICAL CONSTRUCTION TEAM THE ELECTRICAL REQUIREMENTS, INCLUDING POWER, CONTROL, COMMUNICATION, AND MONITORING, OF EACH DEVICE PROVIDED AND/OR INSTALLED BY MECHANICAL CONSTRUCTION TEAM.

14. SUPPORT SYSTEM FOR PIPING MATERIALS AND EQUIPMENT SUPPORTED BY THE BUILDING STRUCTURE SHALL BE SUBMITTED TO THE STRUCTURAL DESIGN TEAM FOR APPROVAL PRIOR TO PURCHASE AND INSTALLATION. NO WIRE OR PERFORATED STRAP WILL BE PERMITTED FOR ANY HANGER OR SUPPORT.

15. CONSTRUCTION TEAM SHALL NOT CUT, DRILL, OR ALTER ANY ELEMENT OF ANY WALLS, FLOORS CEILINGS, ROOFS, AND SLABS WITHOUT FIRST RECEIVING INSTRUCTIONS FROM DESIGN TEAM. ALL CUTS SHALL BE MADE WITH A CUTTING TOOL.

16. PATCHING OR SEALING OF CUTS OR PENETRATIONS SHALL BE DONE BY CONSTRUCTION TEAM PER INSTRUCTIONS FROM AND TO FINAL APPROVAL OF DESIGN TEAM. COORDINATE WITH GENERAL CONSTRUCTION TEAM.

17. CONSTRUCTION TEAM SHALL FIELD VERIFY CONDITION OF EXISTING EQUIPMENT AND PROVIDE NECESSARY COMPONENTS TO ASSEMBLE AND TO START-UP COMPLETE AND FULLY OPERATIONAL SYSTEMS.

18. BEFORE INSTALLATION, EQUIPMENT AND DEVICES INCLUDING, BUT NOT LIMITED TO, ANY DEVICE WITH ELECTRICAL CONNECTIONS, DUCTWORK, INSULATION, PIPING, VALVES, AND AIR DEVICES SHALL NOT BE STORED DIRECTLY ON GRADE OR ON A SLAB OR FLOOR. BEFORE AND AFTER INSTALLATION, SUCH EQUIPMENT AND DEVICES SHALL BE PROTECTED FROM ENTRY OF DIRT, TRASH WATER (EXCEPT AS REQUIRED), VERMIN.

19. CONSTRUCTION TEAM SHALL COORDINATE ACTUAL LOCATIONS OF AIR DEVICES AND DUCTWORK WITH LIGHTS, CEILING PANELS, JOIST SPACING AND DESIGN TEAM REFLECTED CEILING PLAN (REF. ELECTRICAL PLANS AND DESIGN TEAM PLANS).

20. PROVIDE THE TEAM TEXAS WITH THREE (3) COPIES OF ALL INSTALLATIONS INSTRUCTIONS, PRODUCT DATA SUBMITTAL INFORMATION, WARRANTIES, CONTACT INFORMATION DURING WARRANTY PERIOD AND BALANCING REPORTS IN 3-RING BINDERS.

21. OPERATING TESTS AND CLEANING PROCEDURES SHALL BE PERFORMED AND REPORTS SHALL BE ISSUED PER CODE REQUIREMENTS, MANUFACTURER'S RECOMMENDATIONS.

22. PIPING ROUTED ON THE ROOF SHALL BE SUPPORTED BY FACTORY MADE PIPE SUPPORTS PER MANUFACTURER'S RECOMMENDATIONS.

23. CONSTRUCTION TEAM SHALL PROVIDE AND INSTALL IDENTIFICATION TAGS FOR EQUIPMENT AND PIPING PER ASME 13.1 SCHEME OF IDENTIFICATION FOR PIPING.

24. LOCATIONS OF CEILING, ROOF AND ATTIC MECHANICAL EQUIPMENT ARE APPROXIMATE AS SHOWN. MECHANICAL CONSTRUCTION TEAM SHALL FIELD ADJUST AS REQUIRED.

25. CONSTRUCTION TEAM SHALL TAKE PRECAUTIONS PER THE DESIGN TEAM'S INSTRUCTIONS TO PROTECT EXISTING TREES AND /OR OTHER SITE VEGETATION.

26. THE MECHANICAL/PLUMBING CONSTRUCTION TEAM SHALL PROVIDE AND HAVE INSTALLED ANY ACCESS DOOR REQUIRED TO ACCESS MECHANICAL OR PLUMBING EQUIPMENT THAT REQUIRES ACCESS BEHIND GYPBOARD OR HARD CEILINGS AND IN WALLS. THE MECHANICAL/PLUMBING CONSTRUCTION TEAM SHALL PROVIDE THE GENERAL CONSTRUCTION TEAM WITH THESE ACCESS DOORS FOR INSTALLATION IN THE CEILING OR WALL. ACCESS DOORS SHALL BE RATED FOR THE WALL, FLOOR, OR CEILING TYPE AND SHALL BE A MINIMUM SIZE OF 12"x12".

27. ALL MATERIAL INSTALLED IN CEILING SPACE SHALL BE NONCOMBUSTIBLE PLENUM RATED MATERIALS.

28. FOR OUTDOOR EQUIPMENT ON GRADE, CONSTRUCTION TEAM SHALL CONSTRUCT LEVEL 3000 PSI CONCRETE SLABS WITH FINISHED EDGES, WIRE REINFORCED, MINIMUM 3 1/2" THICK, AND MINIMUM 6" LARGER ON ALL SIDES THAN THE EQUIPMENT BEING SUPPORTED.

29. ALL PIPING, PLUMBING AND DUCTWORK OPENINGS SHALL BE CAPPED DURING DEMOLITION AND CONSTRUCTION.

30. SUBMITTAL REQUIREMENTS
 A. THE INTENT OF THIS SECTION IS TO GIVE GENERAL SUBMITTAL INFORMATION, REFER TO SPECIFIC SUBMITTAL INFORMATION IN THE SUBSEQUENT MECHANICAL SECTIONS.
 B. WITHIN 10 DAYS AFTER AWARD OF THE CONTRACT, AND BEFORE ORDERS ARE PLACED, CONSTRUCTION TEAM SHALL SUBMIT SPECIFIC INFORMATION ON LIST OF EQUIPMENT AND PRINCIPAL MATERIALS SPECIFIED IN PDF FORMAT TO THE CONSTRUCTION MANAGER (CM). CONSTRUCTION TEAM SHALL INDICATE AND/OR PROVIDE NAMES OF MANUFACTURERS, CATALOG AND MODEL NUMBERS, CUT SHEETS, AND SUCH OTHER SUPPLEMENTARY INFORMATION AS NECESSARY FOR EVALUATION.

31. REQUIRED SHOP DRAWING SUBMITTALS
 A. RADIANT FLOOR HEATING SYSTEM
 B. RADIANT CEILING COOLING "CHILLED BEAM" SYSTEM
 C. THERMOSTAT, HUMIDISTAT, AND REMOTE SENSORS

RADIANT SYSTEMS:

32. DEVICES THAT MIGHT CAUSE OR OPERATE WITH VIBRATION OR NOISE SHALL BE ISOLATED PER MANUFACTURER'S RECOMMENDATIONS.

33. RADIANT FLOOR HEATING SYSTEM SHALL BE ZURN PEX SYSTEM WITH ACCUFLOW INJECTION PUMP MANIFOLDS WITH ZONE CIRCULATING PUMPS AND ASSOCIATED VALVES, ZONE THERMOSTATS, SUPPORTS, AND CONNECTORS MANIFOLD ZONE CIRCULATION PUMPS (4 TOTAL) SHALL BE SIZED AT 1 GPM AT 20 FEET OF HEAD USING 1/2" PEX TUBING EACH.

34. RADIANT CEILING COOLING "CHILLED BEAM" SYSTEM SHALL BE A TWA PANEL SYSTEMS, INC. ASSEMBLY WITH ASSOCIATED INJECTION PUMP MANIFOLDS WITH ZONE CIRCULATING PUMPS AND ASSOCIATED VALVES, ZONE THERMOSTATS, SUPPORTS, AND CONNECTORS MANIFOLD ZONE CIRCULATION PUMPS (4 TOTAL) SHALL BE SIZED AT 1 GPM AT 20 FEET OF HEAD USING 1/2" PEX TUBING EACH.

MECHANICAL SYMBOL LEGEND

SYMBOL	DESCRIPTION
	NEW EQUIPMENT
	NEW WORK KEYED NOTE
xx-##	EXISTING EQUIPMENT INDICATORS WILL NOT HAVE A SYMBOL. (EXAMPLE: B-1 = EXIST. BOILER #1)
	NEW EQUIPMENT ABBREVIATION SEQUENCE NUMBER
P	PUMP
—CHS—	CHILLED WATER SUPPLY
—CHR—	CHILLED WATER RETURN
—HWS—	HEATING WATER SUPPLY
—HWR—	HEATING WATER RETURN
	THERMOSTAT(TSTAT)
—HCS—	DUAL HEAT/COOL SUPPLY
—HCR—	DUAL HEAT/COOL RETURN


NOTES: GENERAL LEGEND NOT ALL ITEMS APPLICABLE TO THIS PROJECT



TEAM NAME: TEAM TEXAS

ADDRESS: ORANGE COUNTY GREAT PARK
IRVINE, CALIFORNIA
LOT #106

CONTACT: ASMARSHALL@UTEP.EDU
SOLARDECATHLON.UTEP.EDU

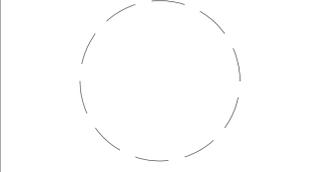

CLIENT
 U.S. DEPARTMENT OF ENERGY
 SOLAR DECATHLON 2013
 WWW.SOLARDECATHLON.GOV



MARK	DATE	DESCRIPTION
01	10/11/2012	90% DOE NR DD SUBMISSION
02	11/20/2012	90% DOE NR DD RE-SUBMISSION
03	02/14/2013	95% DOE NR CD SUBMISSION
03	04/05/2013	95% DOE NR RE-SUBMISSION

LOT NUMBER: #106
 DRAWN BY: TEAM TEXAS
 CHECKED BY: CONSULTANTS
 COPYRIGHT: NONE; PROJECT IS PUBLIC DOMAIN


SHEET TITLE
**SYMBOL LEGEND,
 MECHANICAL GENERAL
 NOTES**

M-001



TEAM NAME: TEAM TEXAS
 ADDRESS: ORANGE COUNTY GREAT PARK
 IRVINE, CALIFORNIA
 LOT #106
 CONTACT: ASMARSHALL@UTEP.EDU
 SOLARDECATHLON.UTEP.EDU

CONSULTANTS
 WRIGHT AND DALBIN ARCHITECTS
 HKN ENGINEERS - STRUCTURE
 EMC ENGINEERS - MPE
 EPCC - SCHOOL OF INTERIOR DESIGN
 EPCC - SCHOOL OF CULINARY ARTS

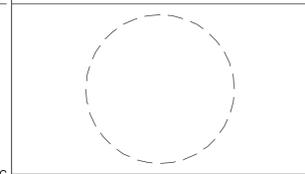

CLIENT
 U.S. DEPARTMENT OF ENERGY
 SOLAR DECATHLON 2013
 WWW.SOLARDECATHLON.GOV




01	10/11/2012	80% DOE-NR DD SUBMISSION
02	11/20/2012	80% DOE-NR DD RE-SUBMISSION
03	02/14/2013	95% DOE-NR CD SUBMISSION
03	04/05/2013	95% DOE-NR RE-SUBMISSION

MARK	DATE	DESCRIPTION
------	------	-------------

LOT NUMBER: #106
 DRAWN BY: TEAM TEXAS
 CHECKED BY: CONSULTANTS
 COPYRIGHT: NONE - PROJECT IS PUBLIC DOMAIN

SHEET TITLE
 ENLARGED MECHANICAL ROOM FLOOR PLAN,
 ELEVATION, AND KEYED NOTES

M-200

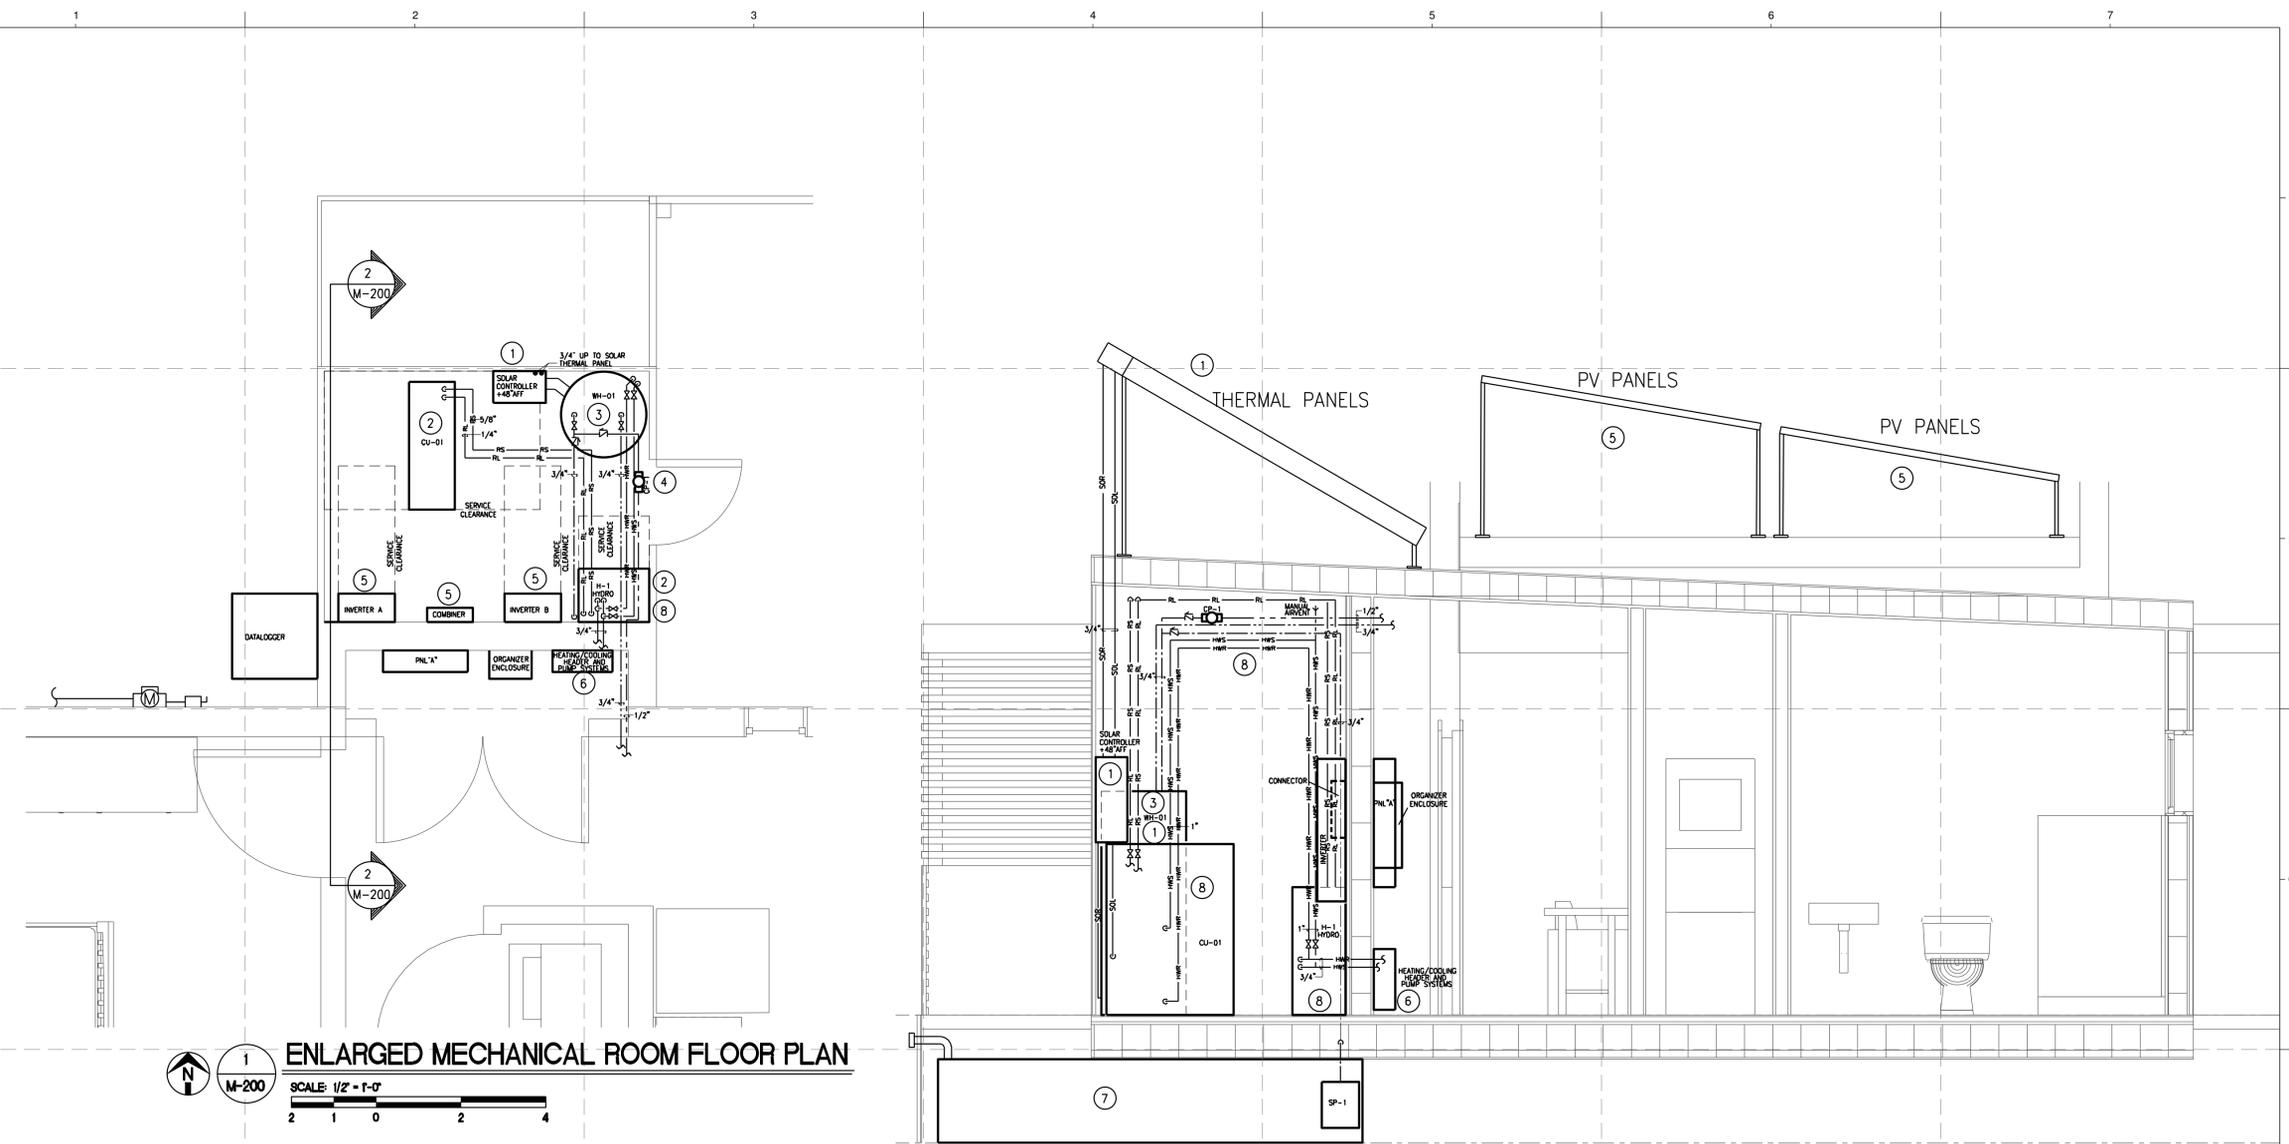


1 ENLARGED MECHANICAL ROOM FLOOR PLAN
 SCALE: 1/2" = 1'-0"
 2 1 0 2 4

MECHANICAL KEYED NOTES: ①

- ① DOMESTIC WATER SOLAR SYSTEM, REFER TO SCHEMATIC 2-P-200 FOR FURTHER INFORMATION
- ② HEAT PUMP CONDENSING UNIT ASSEMBLY, REFER TO SCHEMATIC 1/M-300 FOR FURTHER INFORMATION.
- ③ DOMESTIC WATER HEATER TANK (WH-01), REFER TO SCHEMATIC 2-P-200 AND 2-P-400 FOR FURTHER INFORMATION.
- ④ DOMESTIC WATER RECIRCULATION PUMP (CP-1), REFER TO SCHEMATIC 2-P-200 AND 5-P-400 FOR FURTHER INFORMATION.
- ⑤ ELECTRICAL PV PANELS COMBINER PANELS AND PV-DC/AC INVERTER DISCONNECT.
- ⑥ RADIANT HEATING AND COOLING MANIFOLDS ASSEMBLIES REFER TO SCHEMATICS 1/M-200 AND 2/M-200 FOR FURTHER INFORMATION.
- ⑦ 1,200 GALLON POTABLE WATER STORAGE TANK.
- ⑧ REFER TO MECHANICAL SYSTEM SCHEMATIC 4/M-300.

2 MECHANICAL ROOM ELEVATION
 SCALE: 1/2" = 1'-0"
 2 1 0 2 4

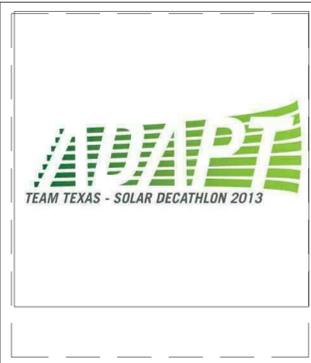

TEAM NAME: TEAM TEXAS
 ADDRESS: ORANGE COUNTY GREAT PARK
 IRVINE, CALIFORNIA
 LOT #106
 CONTACT: ASMARSHALL@UTEP.EDU
 SOLARDECATHLON.UTEP.EDU

CLIENT
 U.S. DEPARTMENT OF ENERGY
 SOLAR DECATHLON 2013
 WWW.SOLARDECATHLON.GOV




MARK	DATE	DESCRIPTION
01	10/11/2012	90% DOE NR DD SUBMISSION
02	11/20/2012	90% DOE NR DD RE-SUBMISSION
03	02/14/2013	95% DOE NR CD SUBMISSION
03	04/05/2013	95% DOE NR RE-SUBMISSION

LOT NUMBER: #106
 DRAWN BY: TEAM TEXAS
 CHECKED BY: CONSULTANTS
 COPYRIGHT: NONE; PROJECT IS PUBLIC DOMAIN


SHEET TITLE
 MECHANICAL SCHEMATICS

M-300

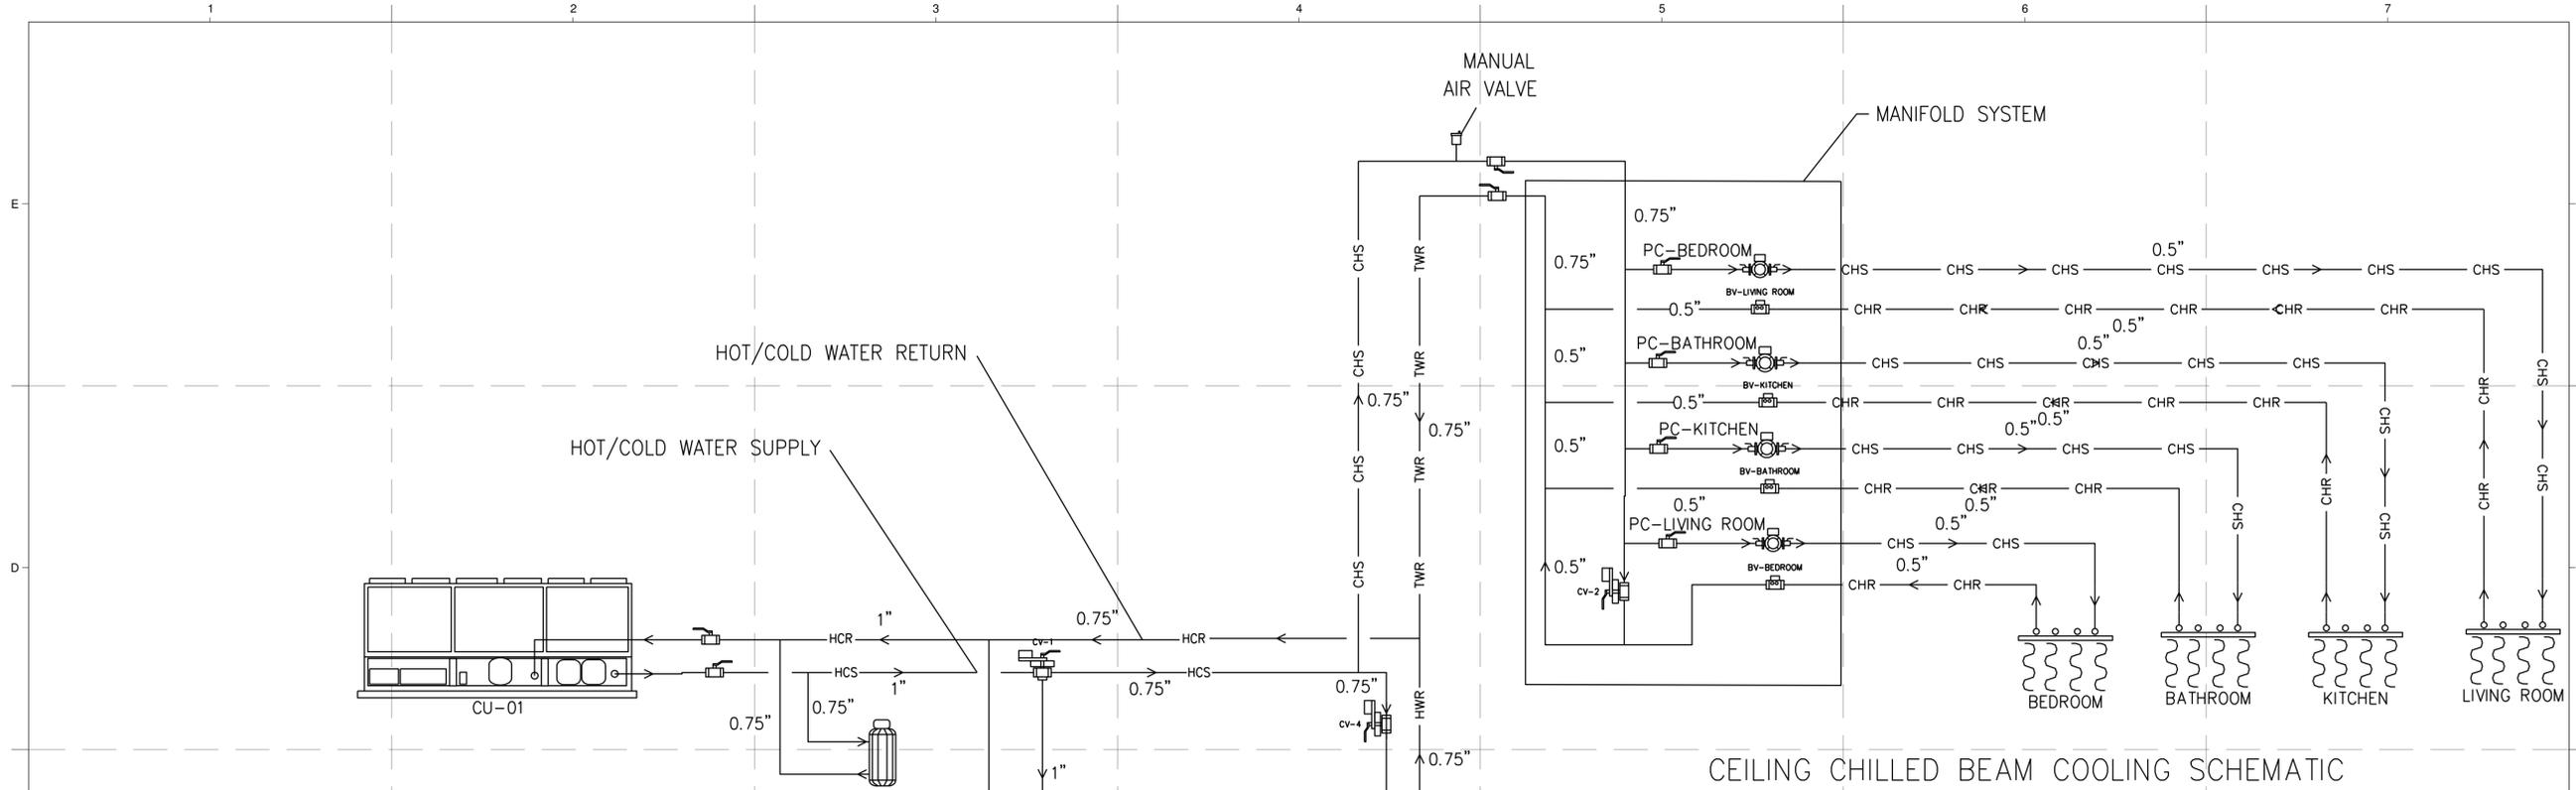


CEILING CHILLED BEAM COOLING SCHEMATIC

OUTDOOR CONDENSING UNIT SCHEDULE	
OUTDOOR UNIT SYMBOL	CU-01
SYSTEM SERVED	BUILDING
COOLING	
NOMINAL TONS	3.0
MINIMUM TOTAL CAPACITY, MBH	34.0
PERCENTAGE OF CAPACITY AT DESIGN CONDITIONS	100.0%
FANS (NO) / TYPE	1
ENTERING CONDENSER AIR TEMPERATURE (F)	105
SPECIFIED UNIT'S (EER/SBHR)	12.2 EER
COMPRESSOR QUANTITY / STAGES	1
HEATING	
CAPACITY, MBH AT 47 DEG F	38.0
SPECIFIED UNIT'S (COP)	4.5
ELECTRICAL (SEE NOTE 4)	
VOLTAGE	208V/1P
MINIMUM CIRCUIT AMPACITY	18.0
MAXIMUM OVERCURRENT PROTECTION	20
REFRIGERANT TYPE	R410a
WEIGHT (LB)	150
DAIKIN ALTHERMA MODEL NUMBER, SEE NOTE 1	ERLQ030BAVJU
WATER HEAT PUMP ASSEMBLY	
SYMBOL	H-01
FUNCTION	HEAT PUMP
SYSTEM HEATING WATER TEMPERATURE RANGE DEG F	59.0 TO 131.0 DEF G
SYSTEM COOLING WATER TEMPERATURE RANGE DEG F	41.0 TO 71.6 DEG F
WATER FLOW:	
HEATING GPM	4.0
COOLING GPM	4.0
PUMP HEAD PRESSURE (PSI)	7.0
HP - REFRIGERANT CONNECTIONS (RS-RL)	5/8" RS - 1/4" RL
ELECTRICAL BACKUP HEATER (KW)	3.0
ELECTRICAL (SEE NOTE 4)	
VOLTAGE	208V/1P
MINIMUM CIRCUIT AMPACITY	14.3
MAXIMUM OVERCURRENT PROTECTION	20
WEIGHT (LB)	130
DAIKIN ALTHERMA MODEL NUMBER, SEE NOTE 1	EKHBX030BA3VJU
NOTES:	
1. UNITS ARE SCHEDULED TO BE MANUFACTURED BY DAIKIN. ALL OTHERS MANUFACTURERS REQUIRE PRIOR APPROVAL.	
2. COOLING CAPACITIES, SEER'S, AND HEATING COP'S ARE COMBINATION RATINGS WITH OUTDOOR UNITS. CAPACITIES ARE RATED AT ENTERING AIR TEMPERATURE AND AMBIENT AS LISTED, SEER ARE RATED AT ARI CONDITIONS. AIRFLOW CONDITIONS ARE RATED AT 4,000 FEET ALTITUDE.	
3. EACH OUTDOOR UNIT SHALL BE EQUIPPED WITH HAIL GUARD FOR THE CONDENSER COIL, DEFROST CONTROL, HIGH PRESSURE SWITCH, HARD START KIT ON SINGLE PHASE UNITS, ANTI-SHORT CYCLE TIMER, SERVICE VALVES, ANCILLARY REFRIGERANT EQUIPMENT AND INDOOR BLOWER RELAY KIT, CONDENSATE KIT, INSULATION KIT TO PREVENT CONDENSATION ON THE BOTTOM AN ANTI-SHORT CYCLE TIMER AND A TIME DELAY RELAY ON MULTI-COMPRESSOR UNITS TO PREVENT MORE THAN ONE COMPRESSOR FROM STARTING SIMULTANEOUSLY.	

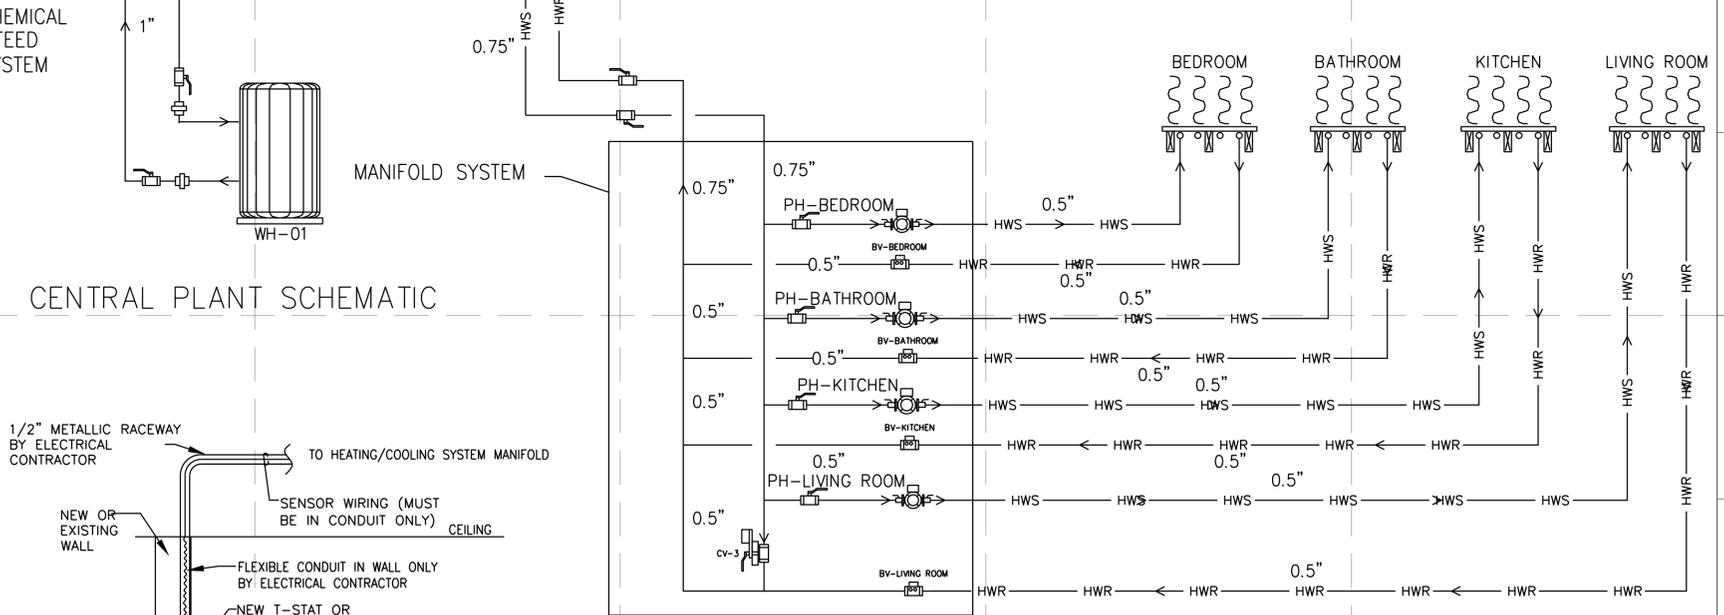


CENTRAL PLANT SCHEMATIC

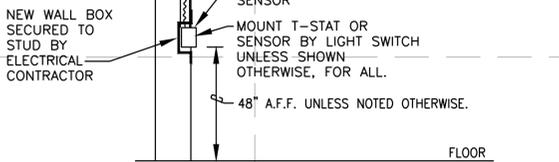

NOTE:
 1. ELECTRICAL CONTRACTOR TO INSTALL CONDUIT AND PULL STRING FOR CONTROLS. CONTRACTOR TO INSTALL WIRE DEVICES.


2
 M-300 SCALE: NONE
 THERMOSTAT/SENSOR MOUNTING SCHEMATIC

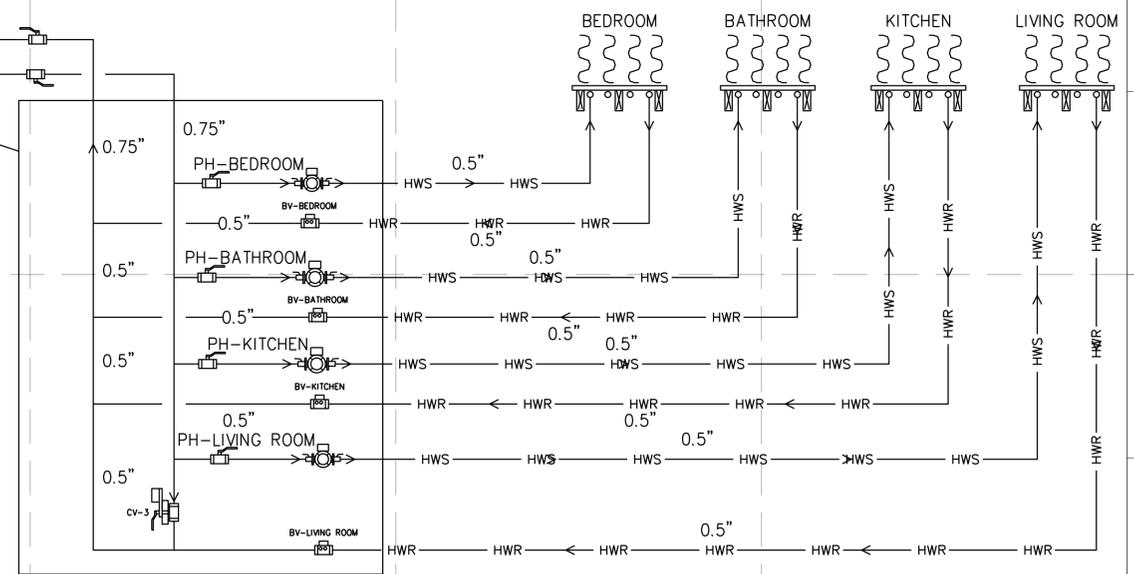

RADIANT FLOOR HEATING SCHEMATIC

1
 M-300 SCALE: NONE
 RADIANT HEATING/COOLING SCHEMATIC

2/13/2013 11:31:47 AM

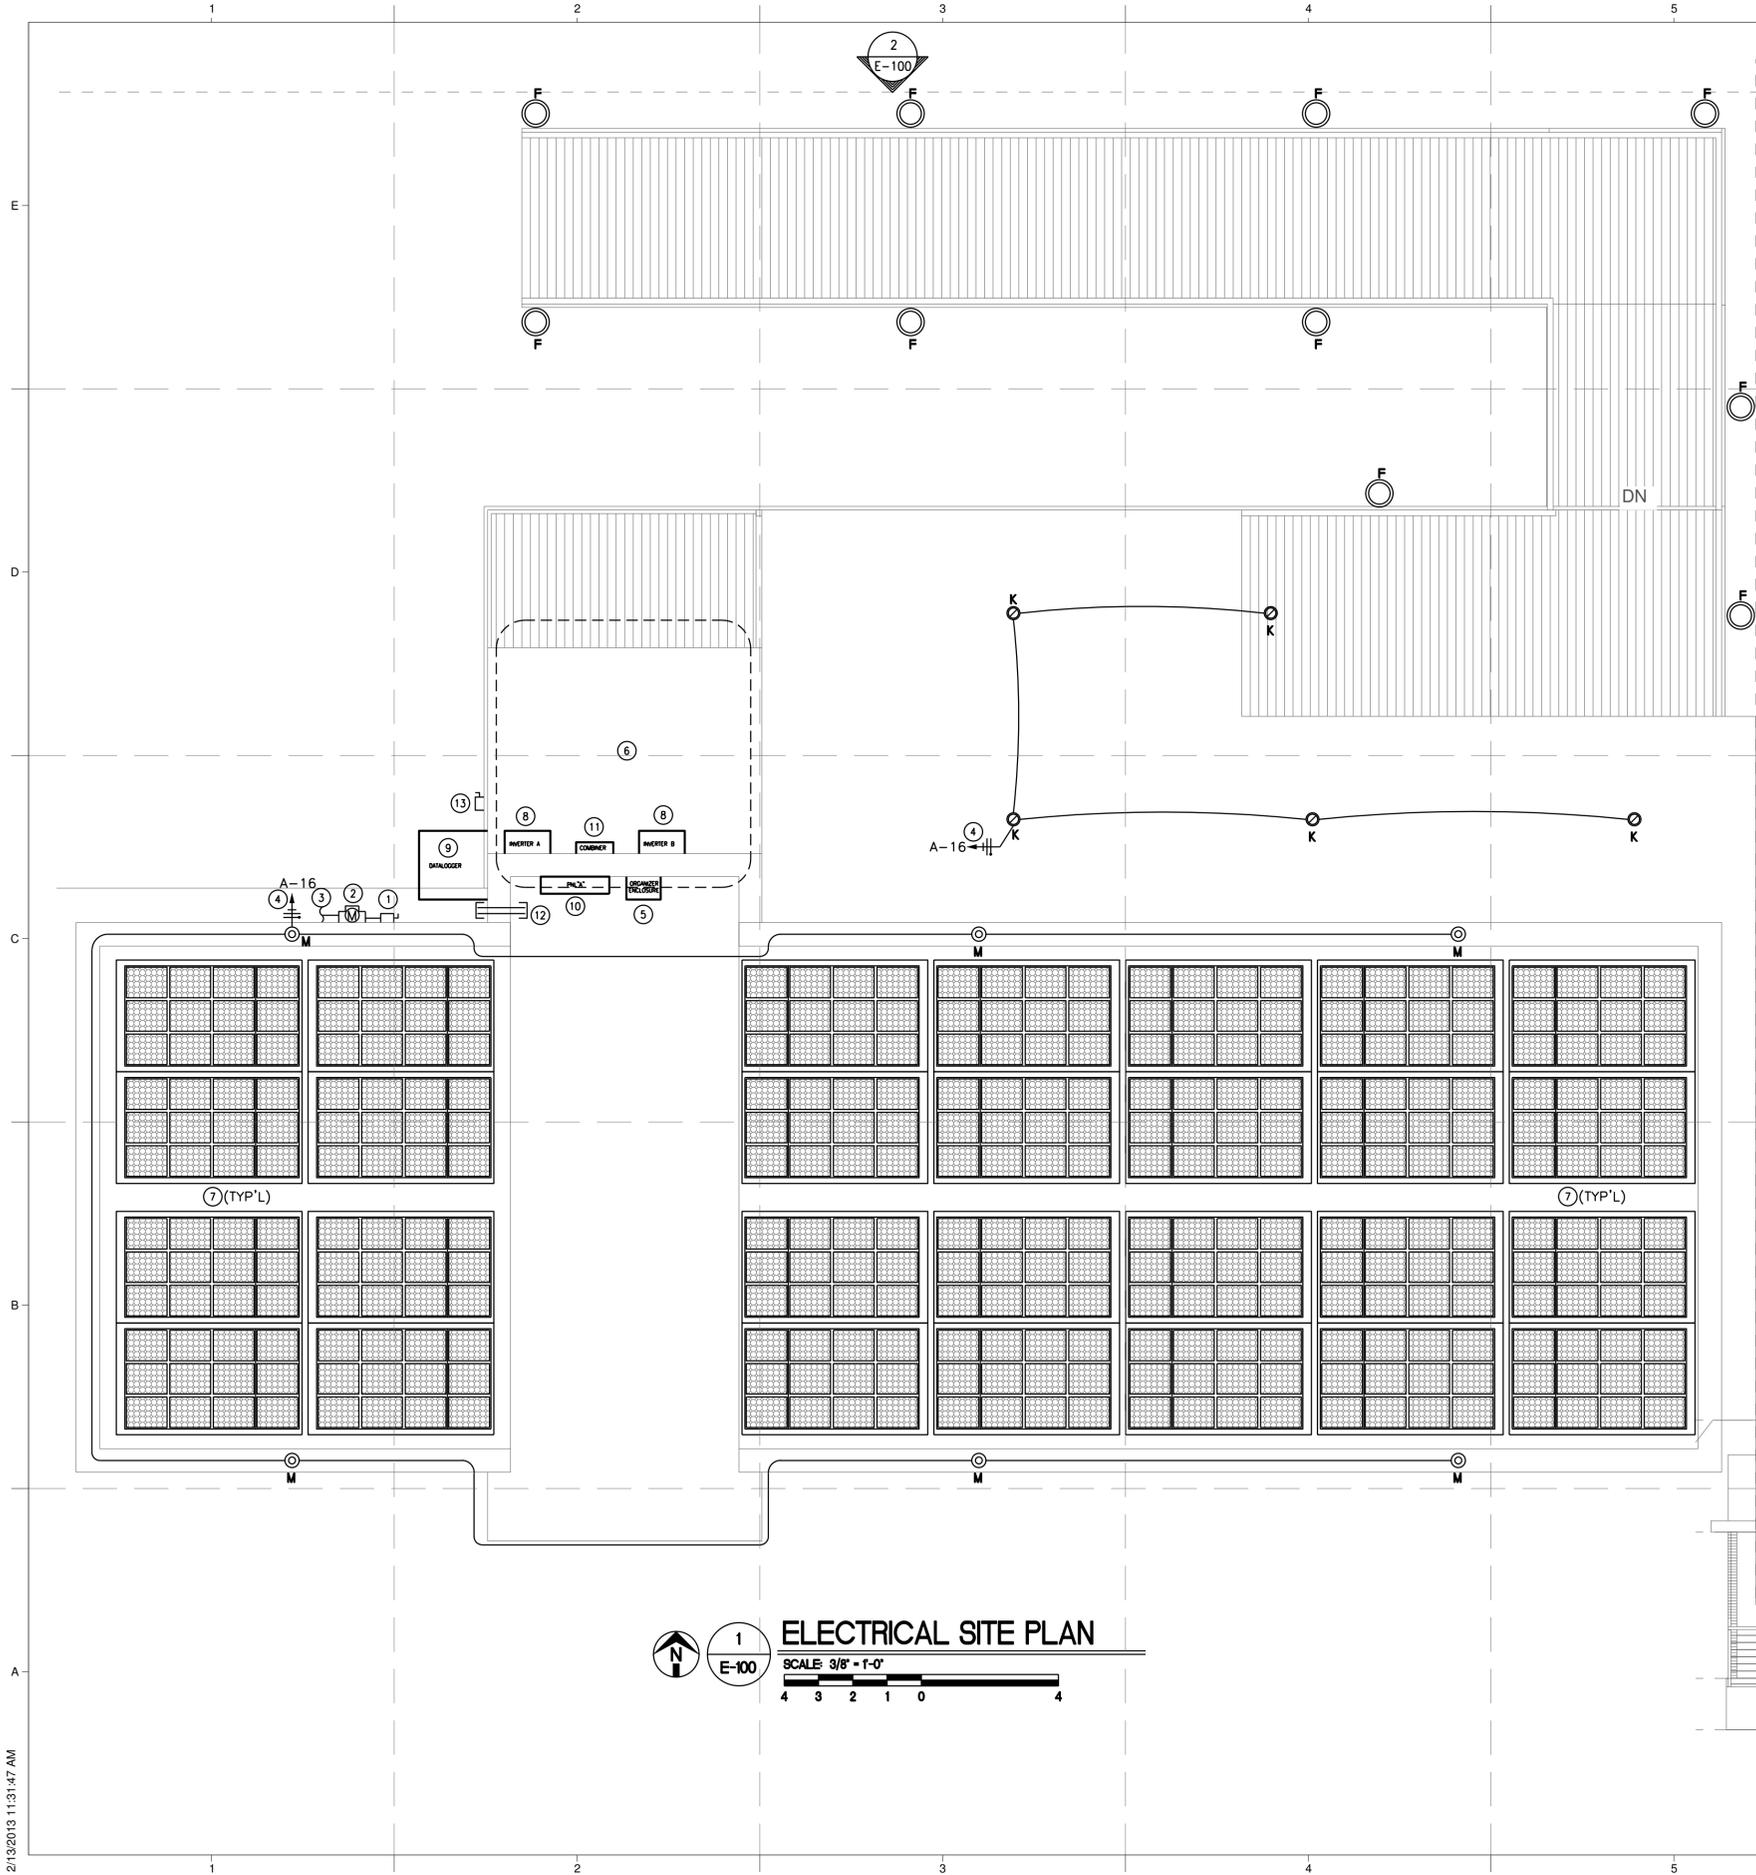


1 ELECTRICAL SITE PLAN
 SCALE: 3/8" = 1'-0"
 4 3 2 1 0 4

ELECTRICAL GENERAL NOTES:

- 1 SEE PANEL SCHEDULE ON SHEET E-400.
- 2 SEE LIGHTING FIXTURE SCHEDULE ON SHEET E-200.
- 3 FIXTURE "J" ARE SOLAR POWERED LOW-LEVEL BOLLARDS AND DO NOT REQUIRE SEPARATE POWER WIRING. SEE FIXTURE SCHEDULE ON SHEET E-200. COORDINATE WITH LANDSCAPING LOCATIONS.
- 4 HOUSE EXTERIOR RECEPTACLES ARE SHOWN ON SHEET E-300.
- 5 REFER TO MECHANICAL ROOM ELEVATION ON SHEET M-200.

ELECTRICAL KEYED NOTES: #


- 1 MAIN SERVICE DISCONNECT. SEE THREE-LINE DIAGRAM ON SHEET E-500.
- 2 ELECTRICAL METER. SEE THREE-LINE DIAGRAM ON SHEET E-500.
- 3 CONNECTION TO UTILITY MICRO-GRID VIA ORGANIZER UTILITY PANEL. SEE THREE-LINE DIAGRAM ON SHEET E-500 FOR CONDUIT AND CONDUCTOR SIZING. PROTECT THE GROUND-LAID CABLE FROM DAMAGE AND FOR PREVENTING A TRIPPING HAZARD. ORGANIZER UTILITY PANEL IS LOCATED NEAR PROPERTY LINE.
- 4 HOMERUN FROM EXTERIOR LIGHTING CIRCUITS AS SHOWN. CONTROL LIGHTS WITH INTERIOR LIGHTING CONTROL PANEL. SEE SHEET E-200.
- 5 ORGANIZER ENCLOSURE. 12" WIDE X 24" HIGH X 8" DEEP WITH REQUIRED 6" CLEARANCE AT THE BOTTOM FOR CONNECTIONS AND WIRING BY OTHERS.
- 6 SEE MECHANICAL PLANS FOR SOLAR THERMAL SYSTEMS LOCATED IN THIS AREA ON THE ROOF.
- 7 TYPICAL UL1703 LISTED PHOTOVOLTAIC SOLAR PANEL. PRISM SOLAR TECHNOLOGIES BIFACIAL MODULE, MODEL B245. MOUNT ON ROOF AT 10 DEGREE ANGLE VIA SCHLETTER INC. RACKING ASSEMBLY. FOLLOW ALL MANUFACTURER'S INSTALLATION INSTRUCTIONS FOR SOLAR PANEL AND RACKING ASSEMBLY. SEE THREE-LINE DIAGRAM ON SHEET E-500 FOR PHOTOVOLTAIC SYSTEM WIRING DIAGRAM. SEE ELEVATION VIEW ON SHEET M-200.
- 8 INVERTER LOCATION.
- 9 ORGANIZER-PROVIDED DATALOGGER ENCLOSURE.
- 10 PANEL "A" LOCATION.
- 11 PV CIRCUIT COMBINER BOX LOCATION.
- 12 PROVIDE 2" CONDUIT STUBBED THROUGH EXTERIOR WALL, CAPPED ON BOTH ENDS FOR CONNECTIONS BY ORGANIZERS.
- 13 40A, 120V/1P, NEMA 3R LOCKABLE SAFETY DISCONNECT FUSED AT 30A FOR FIRE PUMP, 3/4" C WITH (3) #10 CU THWN AND (1) #10 CU EGG. J-BOX FOR CONNECTION TO 120V FIRE SPRINKLER PUMP CONTROL. PROVIDE POWER TO FIRE PUMP AND ASSOCIATED CONTROL PANEL FROM LINE SIDE OF MAIN SERVICE DISCONNECT AND COMPLY WITH ALL NEC REQUIREMENTS. LABEL DISCONNECT "FIRE PUMP DISCONNECTING MEANS." REFER TO THREE-LINE DIAGRAM ON E-500 FOR FURTHER INFORMATION.

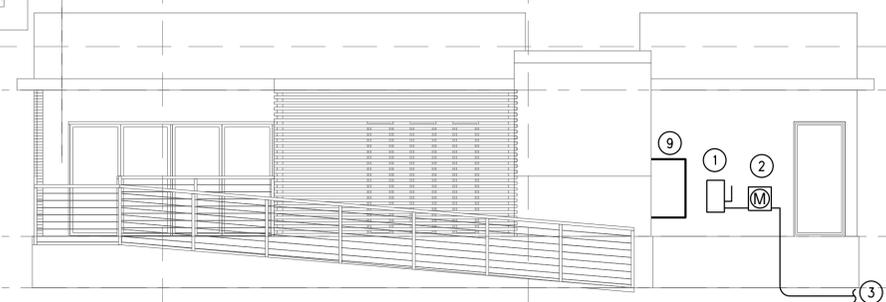

2 ELECTRICAL POWER EQUIPMENT ELEVATION
 SCALE: 3/16" = 1'-0"
 4 3 2 1 0 4 8 12



TEAM NAME: TEAM TEXAS
 ADDRESS: ORANGE COUNTY GREAT PARK
 IRVINE, CALIFORNIA
 LOT #106
 CONTACT: ASMARSHALL@UTEP.EDU
 SOLARDECATHLON.UTEP.EDU

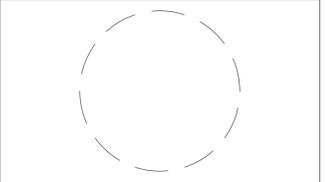

CLIENT
 U.S. DEPARTMENT OF ENERGY
 SOLAR DECATHLON 2013
 WWW.SOLARDECATHLON.GOV




MARK	DATE	DESCRIPTION
01	10/11/2012	90% DOE/NR DD SUBMISSION
02	11/20/2012	90% DOE/NR DD RE-SUBMISSION
03	02/14/2013	95% DOE/NR CD SUBMISSION
03	04/05/2013	95% DOE/NR RE-SUBMISSION

MARK	DATE	DESCRIPTION
LOT NUMBER:	#106	
DRAWN BY:	TEAM TEXAS	
CHECKED BY:	CONSULTANTS	
COPYRIGHT:	NONE: PROJECT IS PUBLIC DOMAIN	

SHEET TITLE
**ELECTRICAL SITE PLAN AND
 ELECTRICAL POWER
 EQUIPMENT ELEVATION**

E-100

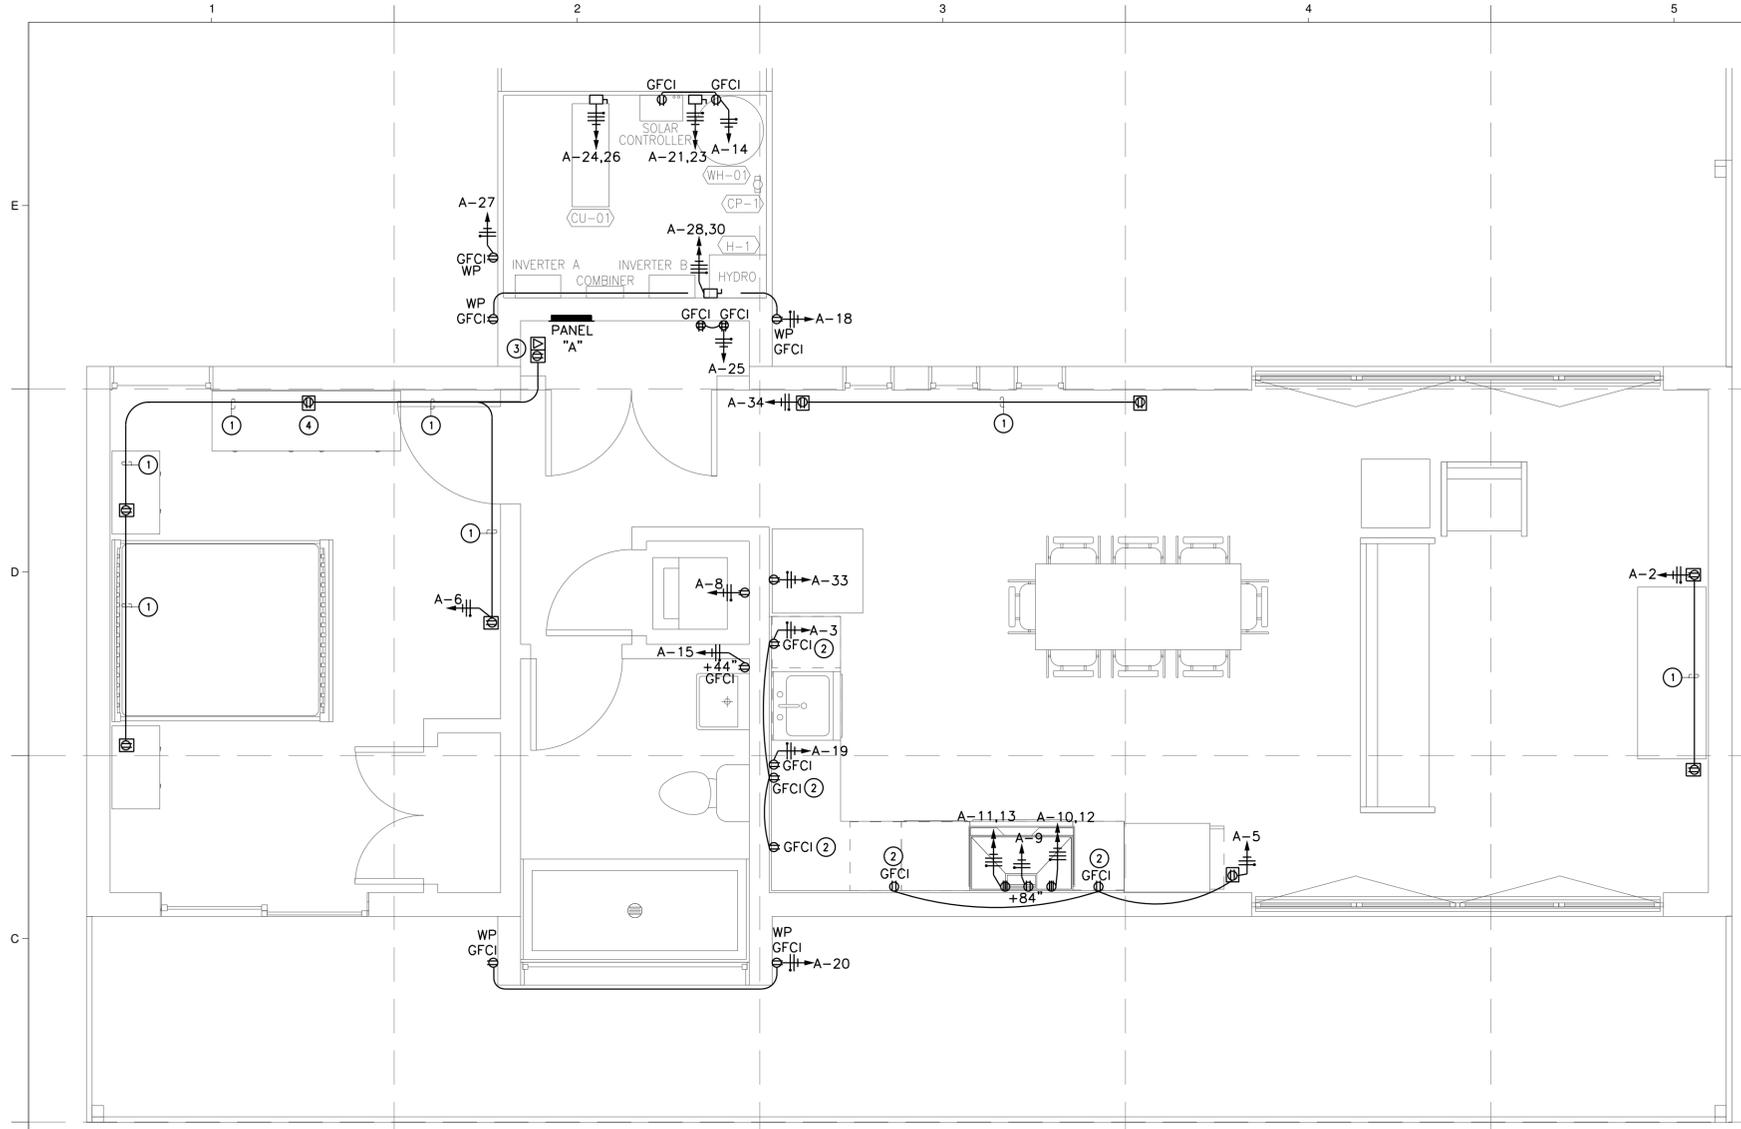

1 ELECTRICAL POWER FLOOR PLAN
 SCALE: 3/8" = 1'-0"
 4 3 2 1 0 4

APPLIANCE & ELECTRONICS SCHEDULE				
ITEM	ITEM MANUFACTURER AND MODEL	VOLTAGE	AMPS/W	COORDINATION NOTES
REFRIGERATOR	THERMADOR 30" BUILT-IN BOTTOM-FREEZER #T30BB810SS	120V	15A	DEDICATED CIRCUIT
MICROWAVE	SAMSUNG #SMH1816S 1.8 CU FT OVER-THE-RANGE WITH ECO MODE	120V	1500W (1W STANDBY)	DEDICATED CIRCUIT
COOKTOP	THERMADOR 36" MASTERPIECE SERIES FREEDOM INDUCTION COOKTOP #CIT36XKB	240V	40A	DEDICATED CIRCUIT
OVEN	THERMADOR 30" MASTERPIECE SERIES STEAM AND CONVECTION OVEN #MES301HS	240V	15A	DEDICATED CIRCUIT
DISHWASHER	SAMSUNG #DMT800RHS ENERGY STAR 24" SIZE, QUIET	120V	MOTOR 150-190W HEATER 1100W	DEDICATED CIRCUIT
WASHER/ DRYER	LG #WM3455HS WASHER/DRYER COMBO WITH STEAM WASH	120V	12A	DEDICATED CIRCUIT
TELEVISION	SAMSUNG #UN46ES8000FXZA 46" SLIM LED, 3-D, HD SMART TV, ENERGY STAR	120V	76W (NORMAL) 0.09W (STANDBY)	PART OF MULTI-OUTLET BRANCH CIRCUIT
SURROUND SOUND	SONY #BDV-N890W 3-D BLU-RAY HOME THEATRE SYSTEM	120V	115W (NORMAL) 0.3W (STANDBY)	PART OF MULTI-OUTLET BRANCH CIRCUIT
COMPUTER	CUSTOM -ADE COMPUTER	120V	520W	PART OF MULTI-OUTLET BRANCH CIRCUIT


NOTES:
 1. SEE PANEL SCHEDULE FOR CONDUCTOR SIZING. MINIMUM OF #12 CU THWN IN 3/4" C. UNLESS NOTED OTHERWISE.
 2. INSTALL BREAKER, WIRING AND CONDUIT PER MANUFACTURER'S SPECIFICATIONS.
 3. THE PURPOSE OF THIS TABLE IS FOR COORDINATION PURPOSES ONLY. APPLIANCE INFORMATION ON ARCHITECTURAL SHEETS TAKES PRECEDENCE OVER THIS TABLE.

ELECTRICAL GENERAL NOTES:

- SEE PANEL SCHEDULE ON SHEET E-400.
- INSTALL GFCI, AFCI AND TAMPER RESISTANT RECEPTACLES PER NEC REQUIREMENTS, ELECTRICAL GENERAL NOTES ON SHEET E-100, AND PANEL SCHEDULE ON SHEET E-400.
 - PER NEC 210.12(A), AFCI PROTECTION IS REQUIRED FOR ALL 120V, 15A AND 20A CIRCUITS SUPPLYING THE FOLLOWING AREAS: FAMILY ROOMS, DINING ROOMS, LIVING ROOMS, BEDROOMS, CLOSETS, HALLWAYS, OR OTHER SIMILAR ROOMS OR AREAS.
 - PER NEC 406.9(A) AND (B), ALL 15A AND 20A, 125V OR 250V RECEPTACLES IN DAMP AND WET LOCATIONS MUST BE LISTED AS WEATHER RESISTANT. THIS REQUIREMENT APPLIES TO THE RECEPTACLE ITSELF, NOT JUST THE COVER.
 - PER NEC 406.9(B)(1), ALL 15A OR 20A, 125V OR 250V RECEPTACLES IN WET LOCATIONS MUST HAVE AN ENCLOSURE THAT IS WEATHERPROOF WEATHER OR NOT THE ATTACHMENT PLUG CAP IS INSERTED.
 - PER NEC 406.12, ALL NON-LOCKING TYPE 15A OR 20A, 125V RECEPTACLES MUST BE LISTED AS TAMPER RESISTANT.
- ALL FLOOR MOUNTED RECEPTACLES TO BE INSTALLED FLUSH IN FLOOR WITHIN 18" OF THE NEAREST WALL.

ELECTRICAL KEYED NOTES: #


- INSTALL FLOOR MOUNTED RECEPTACLES WITH MODULAR WIRING SYSTEM PER SCHEMATIC 2/E-300.
- INSTALL UL-LISTED, UNDER-CABINET POWER RACEWAY FOR SMALL APPLIANCE CONVENIENCE OUTLETS, LEGRAND "PLUGMOLD" OR SIMILAR. MOUNT RACEWAY TO BOTTOM OF CABINET.
- SINGLE ETHERNET PORT FOR USE BY WIRELESS ROUTER. PROVIDE ADAPTER AS REQUIRED FOR ORGANIZER-PROVIDED ETHERNET CABLE.
- PROVIDE AND INSTALL USB-CHARGING RECEPTACLE WITH TWO USB PORTS AND A SINGLE 120V RECEPTACLE.

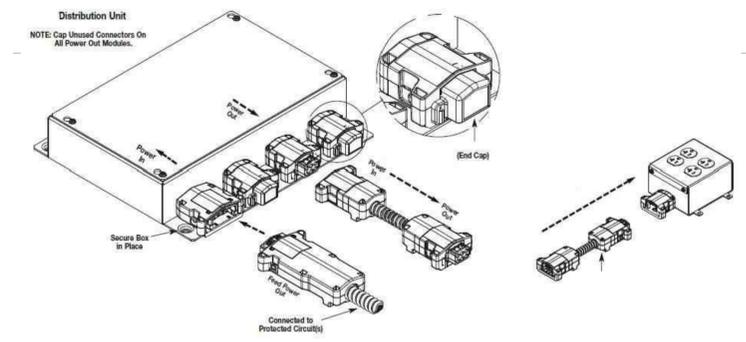

2 MODULAR SYSTEM WIRING DIAGRAM
 SCALE: NOT TO SCALE



TEAM NAME: TEAM TEXAS
 ADDRESS: ORANGE COUNTY GREAT PARK
 IRVINE, CALIFORNIA
 LOT #106
 CONTACT: ASMARSHALL@UTEP.EDU
 SOLARDECATHLON.UTEP.EDU

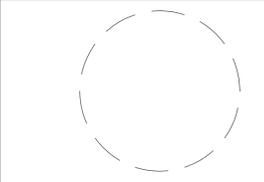

CLIENT
 U.S. DEPARTMENT OF ENERGY
 SOLAR DECATHLON 2013
 WWW.SOLARDECATHLON.GOV



MARK	DATE	DESCRIPTION
01	10/11/2012	90% DOE/NR DD SUBMISSION
02	11/20/2012	90% DOE/NR DD RE-SUBMISSION
03	02/14/2013	95% DOE/NR CD SUBMISSION
03	04/05/2013	95% DOE/NR RE-SUBMISSION

LOT NUMBER: #106
 DRAWN BY: TEAM TEXAS
 CHECKED BY: CONSULTANTS
 COPYRIGHT: NONE: PROJECT IS PUBLIC DOMAIN


SHEET TITLE
ELECTRICAL POWER FLOOR PLAN, APPLIANCE SCHEDULE, MODULAR WIRING SYSTEM DIAGRAM

E-300



PANEL "A" SCHEDULE													
WIRE / CONDUIT		LOCATION:	SERVICE:	LOAD DESCRIPTION	POLE	AMP	VA	PH "A"	PH "C"	VA	AMP	POLE	WIRE / CONDUIT
	1	C		INTERIOR LIGHTING (LED)	1	20	510	870	0	360	20 (AFCI)	1	LIVING ROOM RECEPTACLES
	3	O		SPACE									SPACE
	5	R		KITCHEN GEN APPLIANCE RECEPTACLES	1	20 (GFCI)	360	1,080	0	720	20 (AFCI)	1	BEDROOM RECEPTACLES
	7	K		REFRIGERATOR	1	15	1,440			1,800	20 (GFCI)	1	WASHER/DRYER COMBO
	9	K		MICROWAVE	1	20	1,500	2,220		720	15	2	CONVECTION-STEAM OVEN
	11	K		INDUCTION COOKTOP	2	40	3,700			4,420	720		3/4" C. WITH (3) #12 CU THWN AND (1) #10 CU EGC.
	13	K		BATHROOM RECEPTACLES	1	20 (GFCI)	3,700	5,308		1,608	15	1	CP-1 AND SPL-1 (1/3 & 1/6 HP)
	15	R		BATHROOM RECEPTACLES	1	20 (GFCI)	180			330	20	1	EXTERIOR LIGHTING (LED)
	17	K		GARBAGE DISPOSAL, FUTURE	1	20 (GFCI)		360		360	20 (GFCI)	1	EXTERIOR RECEPTACLES, NORTH
	19	K		DISHWASHER	1	15	1,290			1,650	360	1	EXTERIOR RECEPTACLES, SOUTH
	21	M		WATER HEATER	2	30	1,200	1,200					SPACE
	23	M		HEATING AND COOLING PUMP QUAD RECEPT.			1,200			3,360	2,160	2	OUTDOOR CONDENSING UNIT
	25	M		SUBMERSIBLE PUMP SP-1 (1 HP)	1	20 (GFCI)	990	3,150		2,160	20	2	HYDRO BOX
	27	M		SPACE	1	30	2,400			1,716	1,716		SPACE
	29	O		SPACE									SPACE
	31	O		SPACE									SPACE
	33	R		KITCHEN GEN APPLIANCE RECEPTACLES	1	20 (GFCI)	360	720	0	360	20 (AFCI)	1	DINING ROOM RECEPTACLES
	35	O		SPACE							30	2	PV PANEL INVERTER
	37	O		SPACE							(BACKFED)		PV PANEL INVERTER
	39	O		SPARE- RESERVED FOR ORGANIZER	2	15					30	2	PV PANEL INVERTER
	41	O		SPACE							(BACKFED)		SPACE
WIRING AND CONDUITS SHALL BE IN ACCORDANCE WITH E-100 ELECTRICAL GENERAL NOTES #36 AND #46, UNLESS NOTED OTHERWISE. DEMAND LOADS MAY VARY FROM CONNECTED LOADS BECAUSE OF CODE DIVERSITIES							CONNECTED VA	16,624	17,116				
							CONNECTED AMPS	138.5	142.6				
							TOTAL DIVERSITY KVA	33.7	142.6	PHASE UNBALANCE % 2.9			
							TOTAL DIVERSITY AMPS	119.6					
							TOTAL DIVERSITY KVA	28.7					
TYPE OF LOAD							VA	DEMAND FACTOR	DEMAND VA	NOTES:			
C CONTINUOUS							660.0	1.25	825.0	1. DEMAND FACTORS PER NEC 220.			
N NON-CONTINUOUS							0.0	1.00	0.0	2. INSTALL GFCI AND AFCI AS SHOWN AND PER NEC REQ'TS.			
K KITCHEN							14870.0	0.65	9665.5	3. POWER APPLIANCES AND MECHANICAL EQUIPMENT IN ACCORDANCE WITH MANUFACTURER'S SPECS.			
R RECEPTACLES							3060.0	1.00	3060.0	4. INSTALL ALL WIRING SIZED PER NEC TABLE 310.15(B)(16).			
O OTHER							0.0	1.00	0.0				
M MECHANICAL							15150.0	1.00	15150.0				
TOTAL							33740.0		28700.5				

TEAM NAME: TEAM TEXAS
 ADDRESS: ORANGE COUNTY GREAT PARK IRVINE, CALIFORNIA LOT #106
 CONTACT: ASMARSHALL@UTEP.EDU SOLARDECATHLON.UTEP.EDU

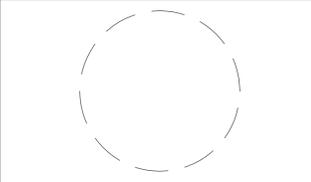

CLIENT
 U.S. DEPARTMENT OF ENERGY
 SOLAR DECATHLON 2013
 WWW.SOLARDECATHLON.GOV




MARK	DATE	DESCRIPTION
01	10/11/2012	80% DOE NR DD SUBMISSION
02	11/20/2012	80% DOE NR DD RE-SUBMISSION
03	02/14/2013	95% DOE NR CD SUBMISSION
03	04/05/2013	95% DOE NR RE-SUBMISSION

LOT NUMBER: #106
 DRAWN BY: TEAM TEXAS
 CHECKED BY: CONSULTANTS
 COPYRIGHT: NONE: PROJECT IS PUBLIC DOMAIN

SHEET TITLE
 ELECTRICAL PANEL SCHEDULE

E-400

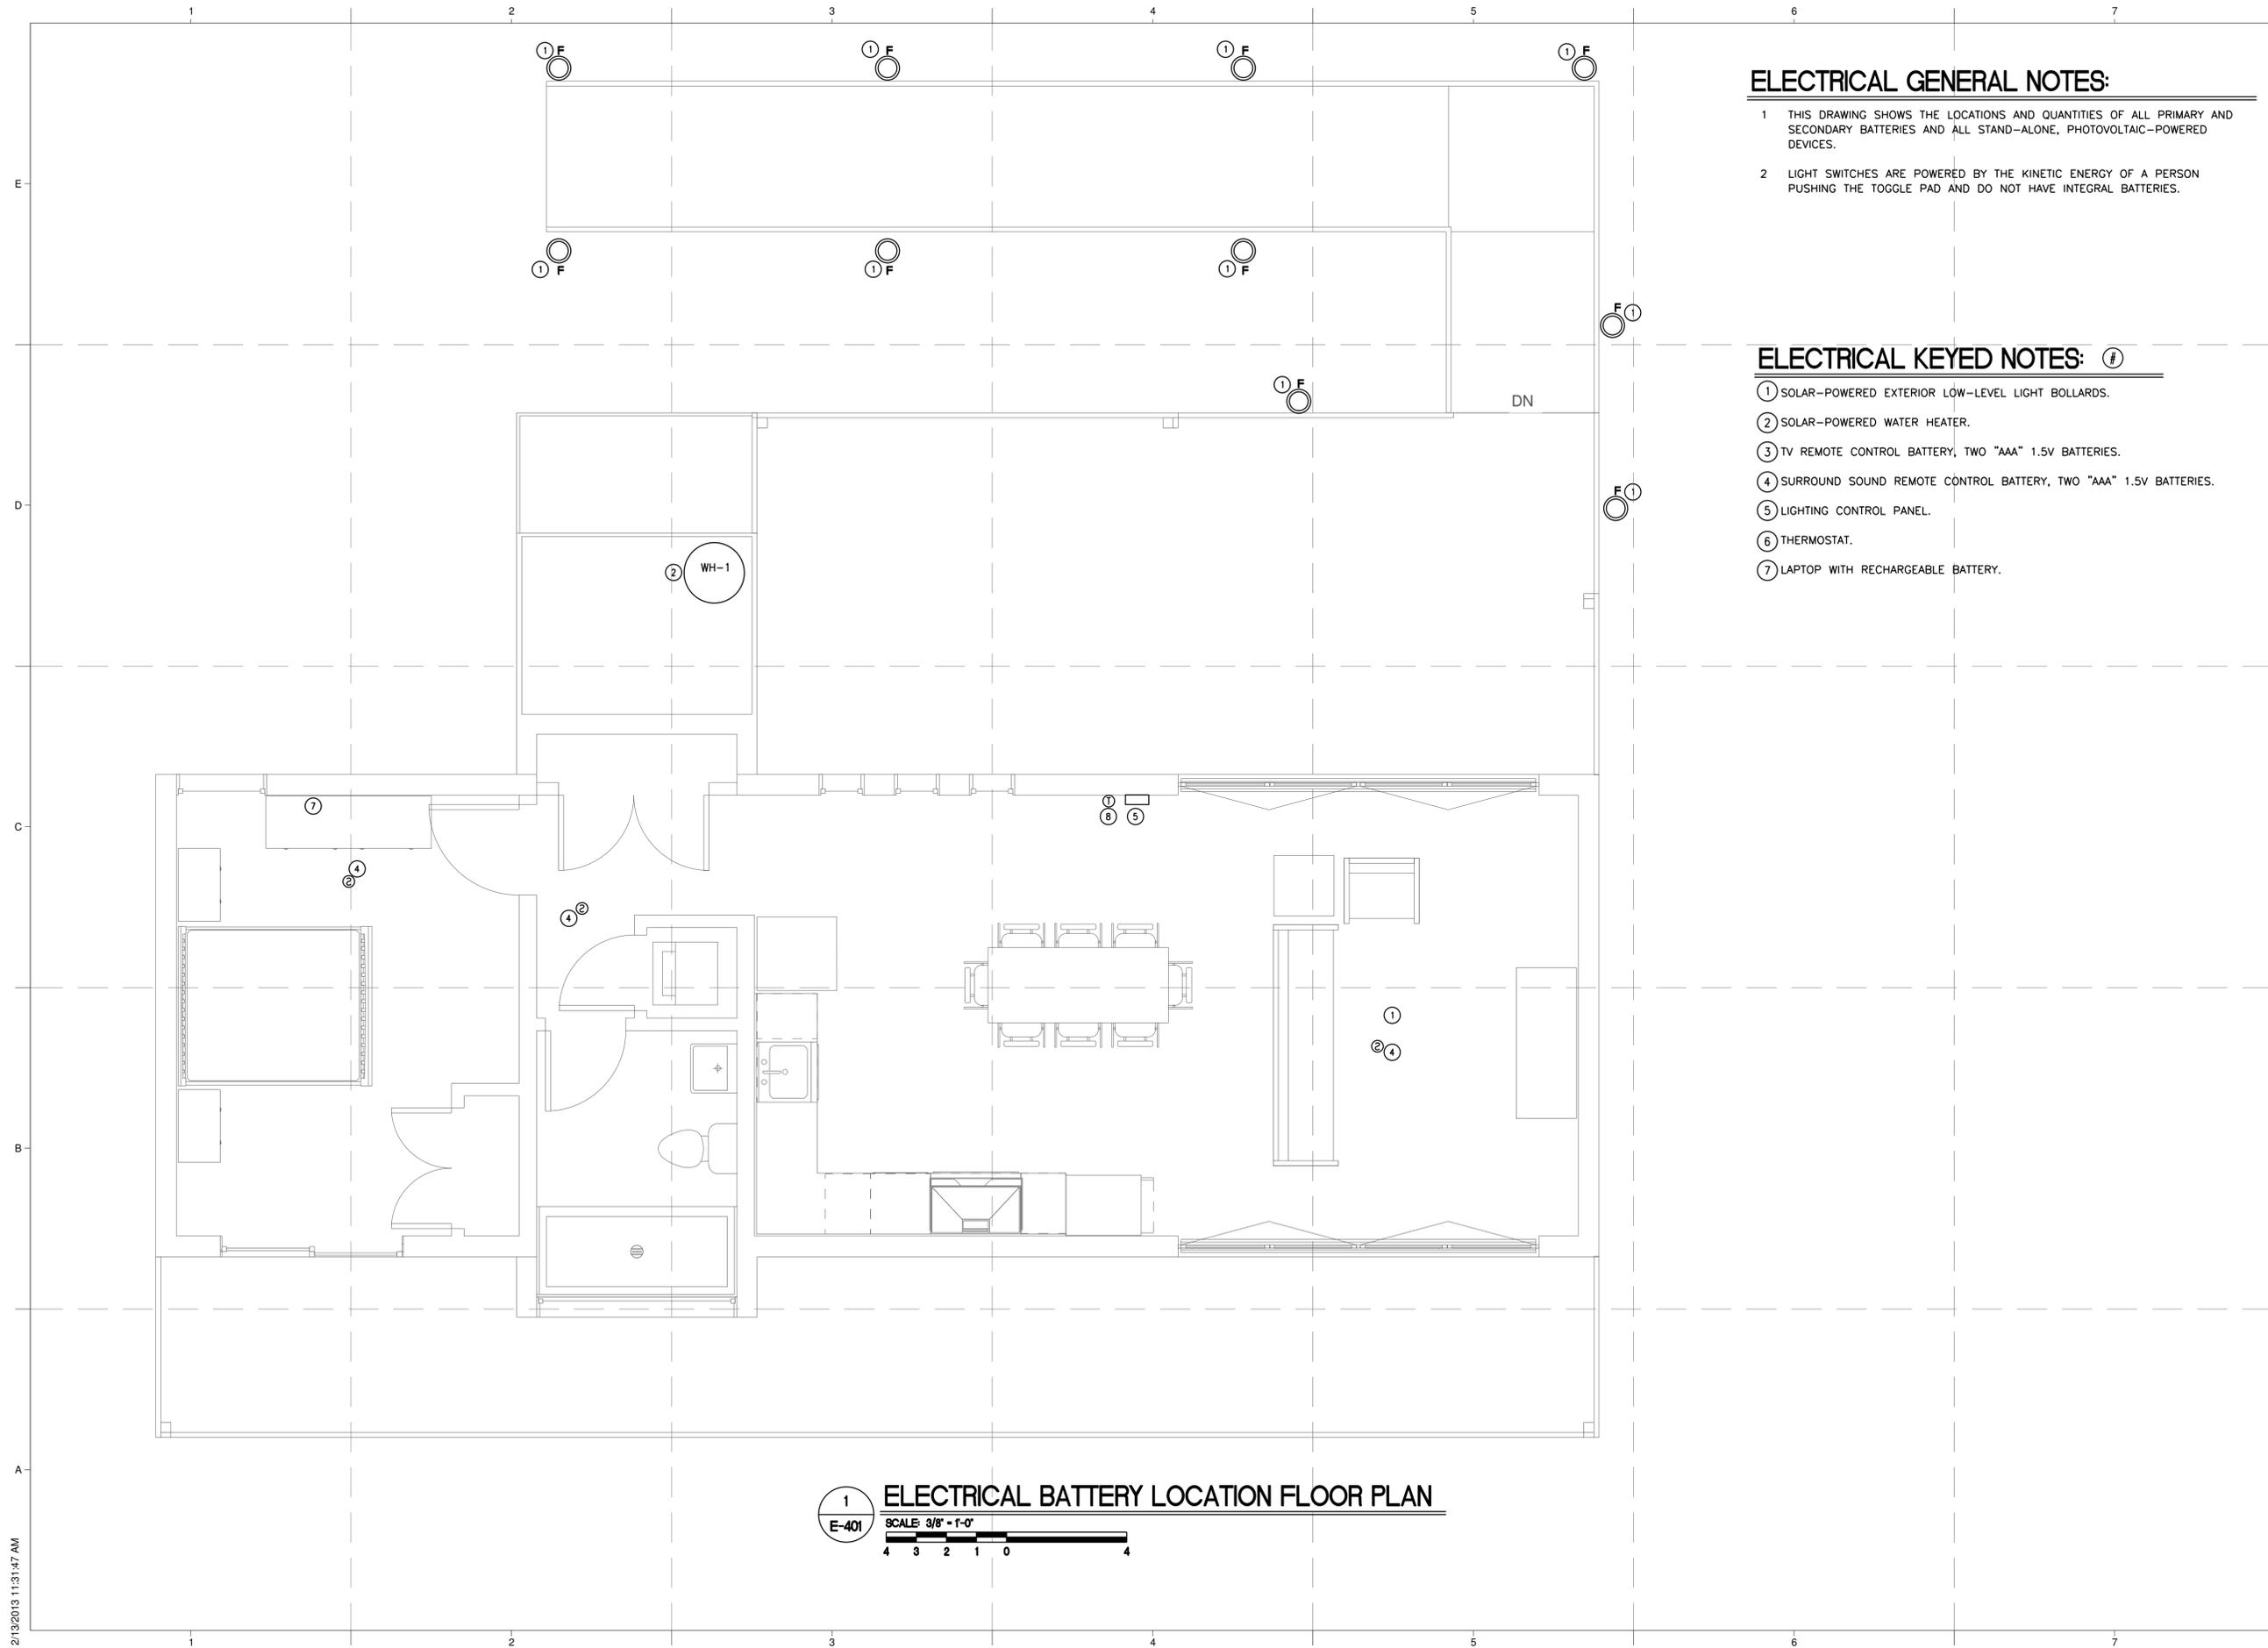

ELECTRICAL GENERAL NOTES:

- 1 THIS DRAWING SHOWS THE LOCATIONS AND QUANTITIES OF ALL PRIMARY AND SECONDARY BATTERIES AND ALL STAND-ALONE, PHOTOVOLTAIC-POWERED DEVICES.
- 2 LIGHT SWITCHES ARE POWERED BY THE KINETIC ENERGY OF A PERSON PUSHING THE TOGGLE PAD AND DO NOT HAVE INTEGRAL BATTERIES.

ELECTRICAL KEYED NOTES: #

- ① SOLAR-POWERED EXTERIOR LOW-LEVEL LIGHT BOLLARDS.
- ② SOLAR-POWERED WATER HEATER.
- ③ TV REMOTE CONTROL BATTERY, TWO "AAA" 1.5V BATTERIES.
- ④ SURROUND SOUND REMOTE CONTROL BATTERY, TWO "AAA" 1.5V BATTERIES.
- ⑤ LIGHTING CONTROL PANEL.
- ⑥ THERMOSTAT.
- ⑦ LAPTOP WITH RECHARGEABLE BATTERY.



TEAM NAME: TEAM TEXAS
 ADDRESS: ORANGE COUNTY GREAT PARK
 IRVINE, CALIFORNIA
 LOT #106
 CONTACT: ASMARSHALL@UTEP.EDU
 SOLARDECATHLON.UTEP.EDU

CLIENT
 U.S. DEPARTMENT OF ENERGY
 SOLAR DECATHLON 2013
 WWW.SOLARDECATHLON.GOV



01	10/11/2012	90% DOE NR DD SUBMISSION
02	11/20/2012	90% DOE NR DD RE-SUBMISSION
03	02/14/2013	95% DOE NR CD SUBMISSION
03	04/05/2013	95% DOE NR RE-SUBMISSION


MARK	DATE	DESCRIPTION
------	------	-------------

LOT NUMBER: #106
 DRAWN BY: TEAM TEXAS
 CHECKED BY: CONSULTANTS
 COPYRIGHT: NONE: PROJECT IS PUBLIC DOMAIN

SHEET TITLE
ELECTRICAL BATTERY LOCATION FLOOR PLAN

E-401

1
E-401
ELECTRICAL BATTERY LOCATION FLOOR PLAN
 SCALE: 3/8" = 1'-0"
 4 3 2 1 0 4

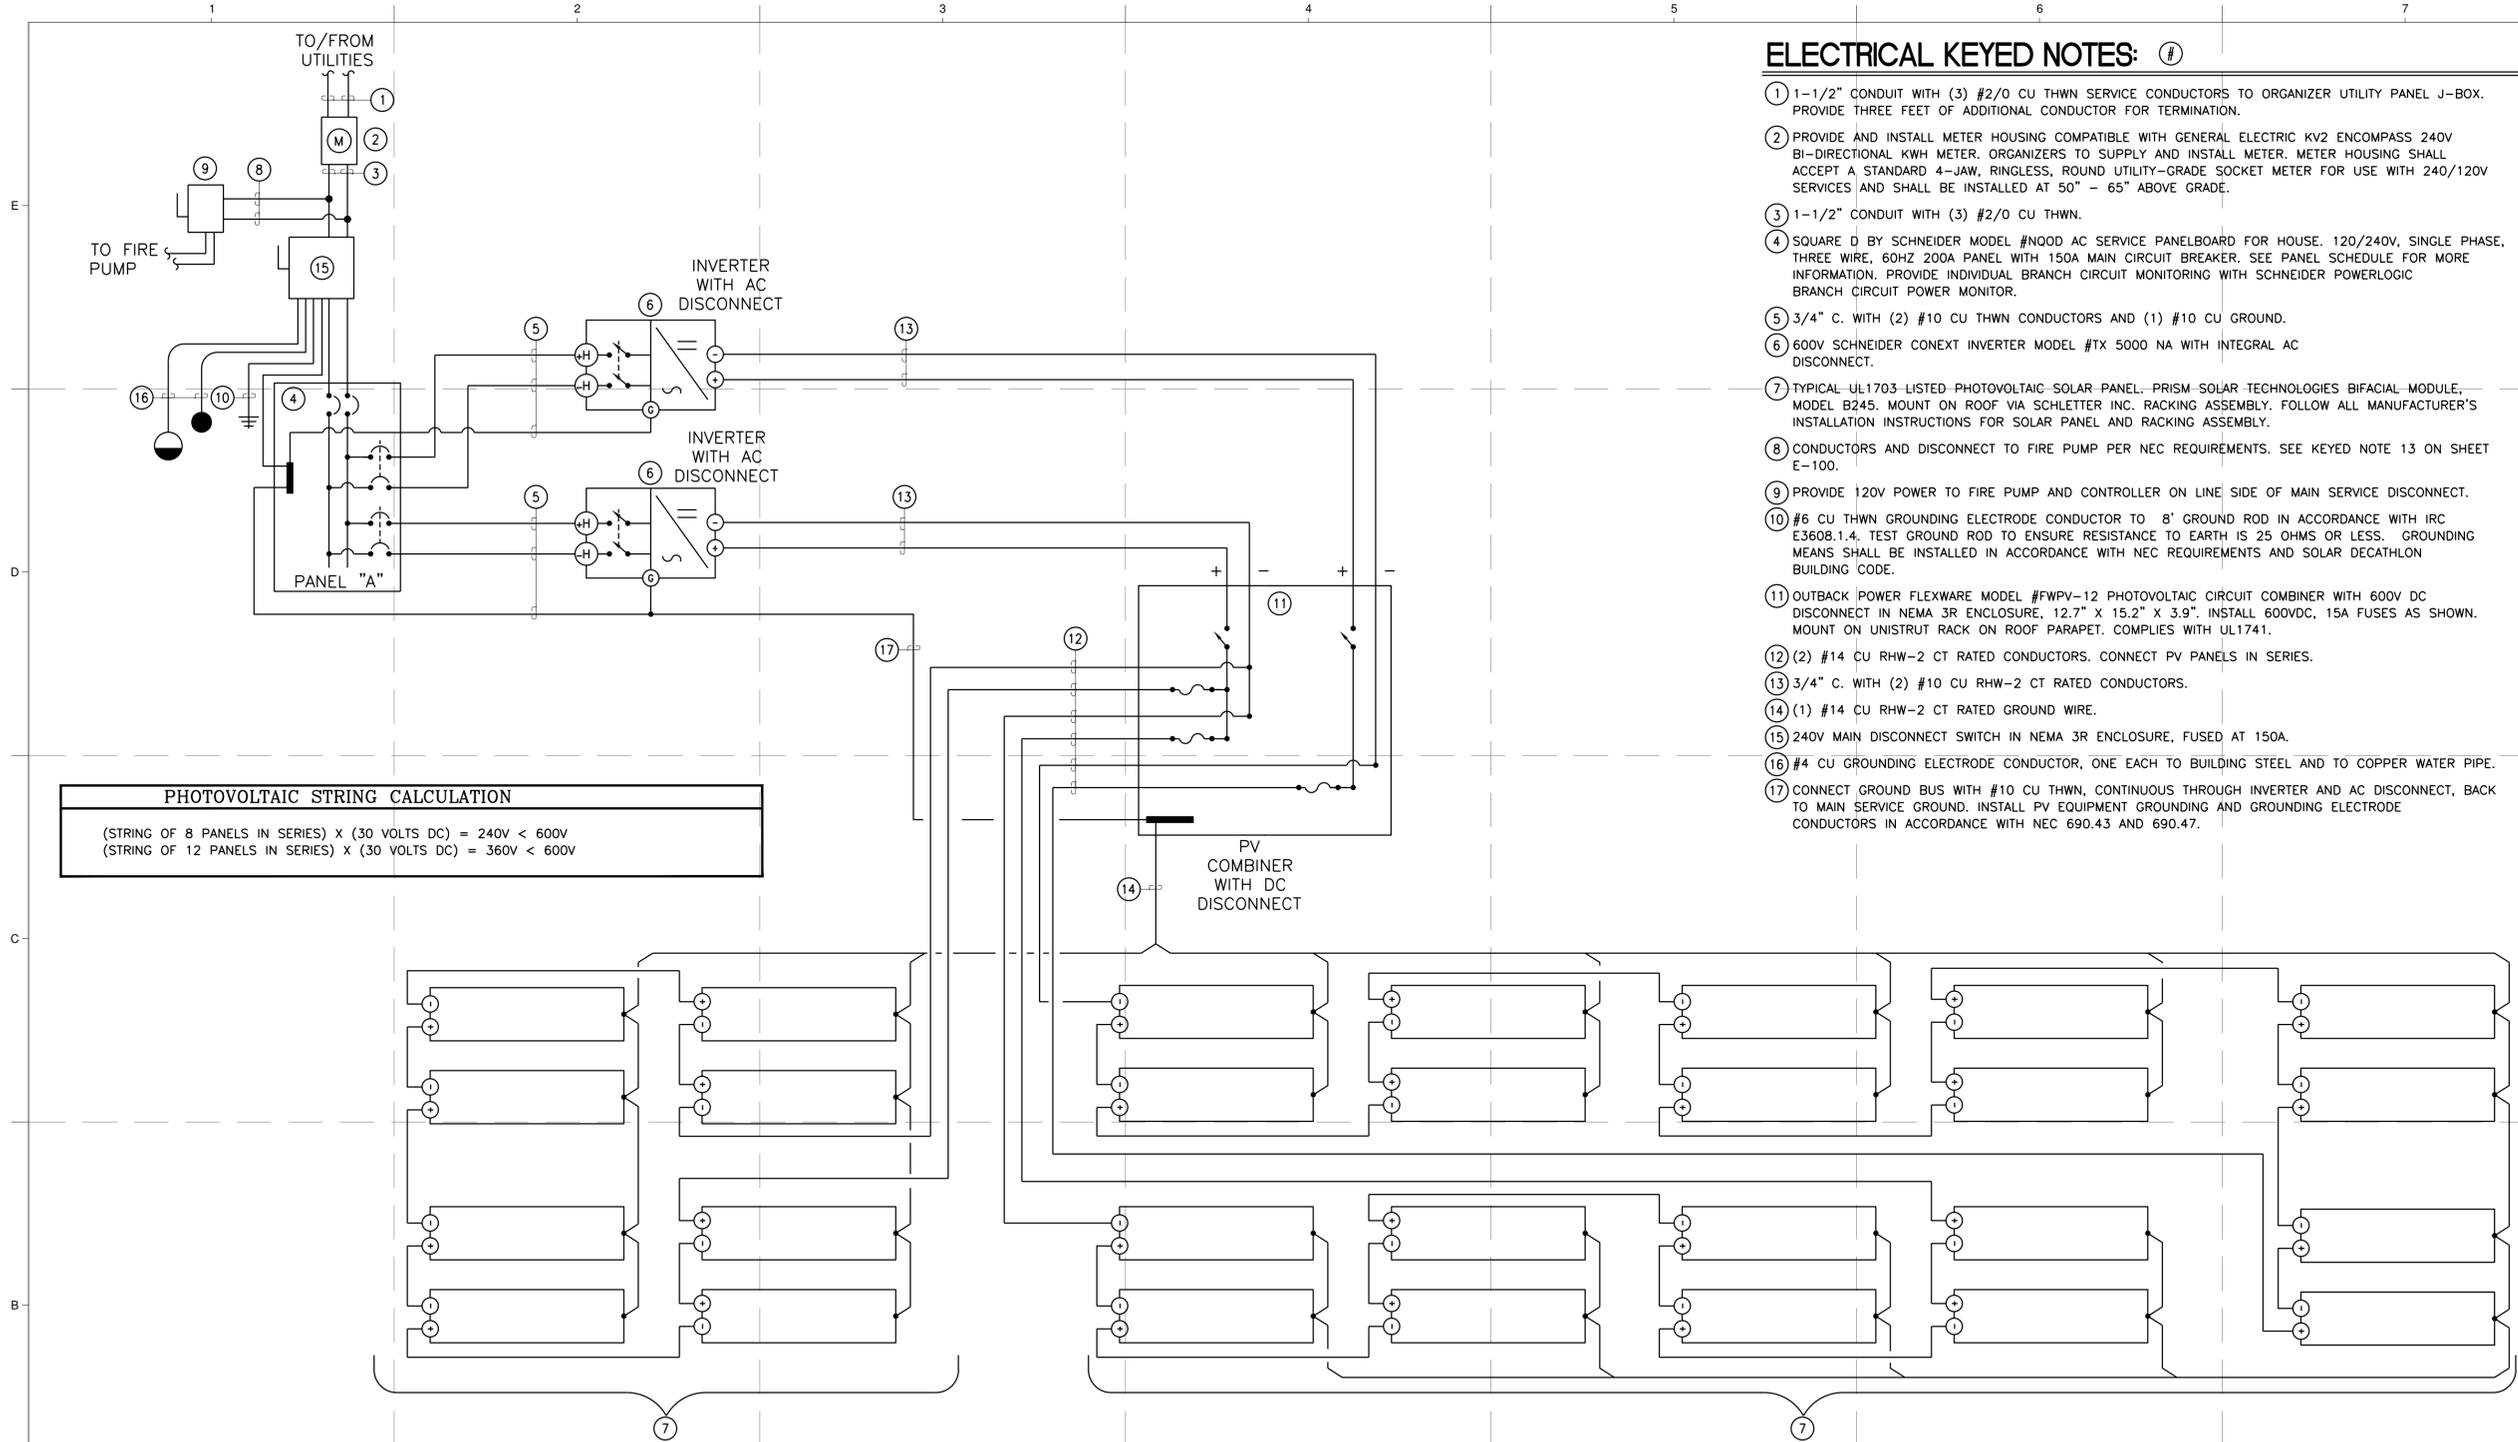

ELECTRICAL KEYED NOTES: #

- ① 1-1/2" CONDUIT WITH (3) #2/0 CU THWN SERVICE CONDUCTORS TO ORGANIZER UTILITY PANEL J-BOX. PROVIDE THREE FEET OF ADDITIONAL CONDUCTOR FOR TERMINATION.
- ② PROVIDE AND INSTALL METER HOUSING COMPATIBLE WITH GENERAL ELECTRIC KV2 ENCOMPASS 240V BI-DIRECTIONAL KWH METER. ORGANIZERS TO SUPPLY AND INSTALL METER. METER HOUSING SHALL ACCEPT A STANDARD 4-JAW, RINGLESS, ROUND UTILITY-GRADE SOCKET METER FOR USE WITH 240/120V SERVICES AND SHALL BE INSTALLED AT 50" - 65" ABOVE GRADE.
- ③ 1-1/2" CONDUIT WITH (3) #2/0 CU THWN.
- ④ SQUARE D BY SCHNEIDER MODEL #NQ00 AC SERVICE PANELBOARD FOR HOUSE. 120/240V, SINGLE PHASE, THREE WIRE, 60HZ 200A PANEL WITH 150A MAIN CIRCUIT BREAKER. SEE PANEL SCHEDULE FOR MORE INFORMATION. PROVIDE INDIVIDUAL BRANCH CIRCUIT MONITORING WITH SCHNEIDER POWERLOGIC BRANCH CIRCUIT POWER MONITOR.
- ⑤ 3/4" C. WITH (2) #10 CU THWN CONDUCTORS AND (1) #10 CU GROUND.
- ⑥ 600V SCHNEIDER CONEXT INVERTER MODEL #TX 5000 NA WITH INTEGRAL AC DISCONNECT.
- ⑦ TYPICAL UL1703 LISTED PHOTOVOLTAIC SOLAR PANEL. PRISM SOLAR TECHNOLOGIES BIFACIAL-MODULE, MODEL B245. MOUNT ON ROOF VIA SCHLETTER INC. RACKING ASSEMBLY. FOLLOW ALL MANUFACTURER'S INSTALLATION INSTRUCTIONS FOR SOLAR PANEL AND RACKING ASSEMBLY.
- ⑧ CONDUCTORS AND DISCONNECT TO FIRE PUMP PER NEC REQUIREMENTS. SEE KEYED NOTE 13 ON SHEET E-100.
- ⑨ PROVIDE 120V POWER TO FIRE PUMP AND CONTROLLER ON LINE SIDE OF MAIN SERVICE DISCONNECT.
- ⑩ #6 CU THWN GROUNDING ELECTRODE CONDUCTOR TO 8' GROUND ROD IN ACCORDANCE WITH IRC E3608.1.4. TEST GROUND ROD TO ENSURE RESISTANCE TO EARTH IS 25 OHMS OR LESS. GROUNDING MEANS SHALL BE INSTALLED IN ACCORDANCE WITH NEC REQUIREMENTS AND SOLAR DECATHLON BUILDING CODE.
- ⑪ OUTBACK POWER FLEXWARE MODEL #FWPV-12 PHOTOVOLTAIC CIRCUIT COMBINER WITH 600V DC DISCONNECT IN NEMA 3R ENCLOSURE, 12.7" X 15.2" X 3.9". INSTALL 600VDC, 15A FUSES AS SHOWN. MOUNT ON UNISTRUT RACK ON ROOF PARAPET. COMPLIES WITH UL1741.
- ⑫ (2) #14 CU RHW-2 CT RATED CONDUCTORS. CONNECT PV PANELS IN SERIES.
- ⑬ 3/4" C. WITH (2) #10 CU RHW-2 CT RATED CONDUCTORS.
- ⑭ (1) #14 CU RHW-2 CT RATED GROUND WIRE.
- ⑮ 240V MAIN DISCONNECT SWITCH IN NEMA 3R ENCLOSURE, FUSED AT 150A.
- ⑯ #4 CU GROUNDING ELECTRODE CONDUCTOR, ONE EACH TO BUILDING STEEL AND TO COPPER WATER PIPE.
- ⑰ CONNECT GROUND BUS WITH #10 CU THWN, CONTINUOUS THROUGH INVERTER AND AC DISCONNECT, BACK TO MAIN SERVICE GROUND. INSTALL PV EQUIPMENT GROUNDING AND GROUNDING ELECTRODE CONDUCTORS IN ACCORDANCE WITH NEC 690.43 AND 690.47.

PHOTOVOLTAIC STRING CALCULATION

(STRING OF 8 PANELS IN SERIES) X (30 VOLTS DC) = 240V < 600V
 (STRING OF 12 PANELS IN SERIES) X (30 VOLTS DC) = 360V < 600V

PHOTOVOLTAIC SYSTEM COMPONENTS

ITEM	ITEM MANUFACTURER AND MODEL	VOLTAGE	AMPS	WATTS	NOTES
PV PANEL	PRISM SOLAR TECHNOLOGIES MODEL B245	30.0 VMP 38.5 VOC	8.04A IMP 8.76A ISC	P _{MAX} = 245 W (@ STC)	TYPICAL. CAN ACHIEVE 30% MORE POWER FROM REFLECTION ON THE PANEL'S REAR.
PV COMBINER	OUTBACK POWER MODEL #FWPV-12	600V DC	(3) 15 AMP FUSES	N/A	TYPICAL. NEMA 3R ENCLOSURE. 2 OUTPUT CIRCUITS. 10KA MAX FUSE SC CURRENT.
INVERTER	SCHNEIDER MODEL CONEXT #TX 5000 NA	600V INPUT 240V OUTPUT	22.5A MAX	5 KW MAX OUTPUT	TYPICAL. WITH INTEGRAL AC DISCONNECT. REQUIRES 30A OVERCURRENT PROTECTION.

NOTES:
 1. SEE PANEL SCHEDULE FOR CONDUCTOR SIZING. MINIMUM OF #12 CU THWN IN 3/4" C. UNLESS NOTED OTHERWISE.
 2. INSTALL WIRING AND CONDUIT IN ACCORDANCE WITH MANUFACTURER'S SPECIFICATIONS.
 3. ALL EQUIPMENT IS UL LISTED. SEE PROJECT MANUAL FOR DETAILS.

PHOTOVOLTAIC MAXIMUM POWER OUTPUT CALCULATION

	POWER (WATTS) STANDARD (1)	POWER (WATTS) WITH REFLECTION (2)
A. PRISM SOLAR BIFACIAL MODULE MODEL B245 -WATTS	245	315
B. DERATING FACTOR OF 6% FOR 10 DEGREE INCLINE	0.94	0.94
C. TOTAL NUMBER OF PV PANELS	28	28
A*B*C = EXPECTED WATTS MAXIMUM OUTPUT		6,448 8,291 (3)

NOTES:
 (1) MAXIMUM RATED POWER AT STANDARD TESTING CONDITIONS (STC)
 (2) MAXIMUM RATED POWER AT STC WITH 30% ADDITIONAL REFLECTION POWER
 (3) MAX POWER IS LESS THAN 2 X 5,000 WATT INVERTERS.

1 ELECTRICAL THREE-LINE DIAGRAM
 E-500 SCALE: NOT TO SCALE

TEAM NAME: TEAM TEXAS
 ADDRESS: ORANGE COUNTY GREAT PARK IRVINE, CALIFORNIA LOT #106
 CONTACT: ASMARSHALL@UTEP.EDU SOLARDECATHLON.UTEP.EDU

CLIENT
 U.S. DEPARTMENT OF ENERGY
 SOLAR DECATHLON 2013
 WWW.SOLARDECATHLON.GOV

MARK	DATE	DESCRIPTION
01	10/11/2012	90% DOE/NR DD SUBMISSION
02	11/20/2012	90% DOE/NR DD RE-SUBMISSION
03	02/14/2013	95% DOE/NR CD SUBMISSION
03	04/05/2013	95% DOE/NR RE-SUBMISSION

LOT NUMBER: #106
 DRAWN BY: TEAM TEXAS
 CHECKED BY: CONSULTANTS
 COPYRIGHT: NONE; PROJECT IS PUBLIC DOMAIN

SHEET TITLE
ELECTRICAL THREE-LINE DIAGRAM

E-500

